

A 519 001


COUNTY #

SOIL PROFILE

0' 55
 yel. sil. cl
 4' 55
 Mix. sil. clay
 mica L. F.
 yel. sil. clay
 mica L. silty
 6' 55
 Mid. sil.
 mica L. sil.
 11' 55
 very micaceous
 str. silty
 mica L. silty
 mica L. silty
 15' 55

4' 55
 sil. clay
 yel. sil.
 cl
 8' 55
 Red sil. clay
 mica L. sil.
 13' 55
 Mid. sil.
 mica L. sil.

B, A
 5' 55
 dark brown L
 str. brown
 silty clay
 mica L. sil.
 22' 55
 Mid. sil.
 mica L. sil.
 13' 55

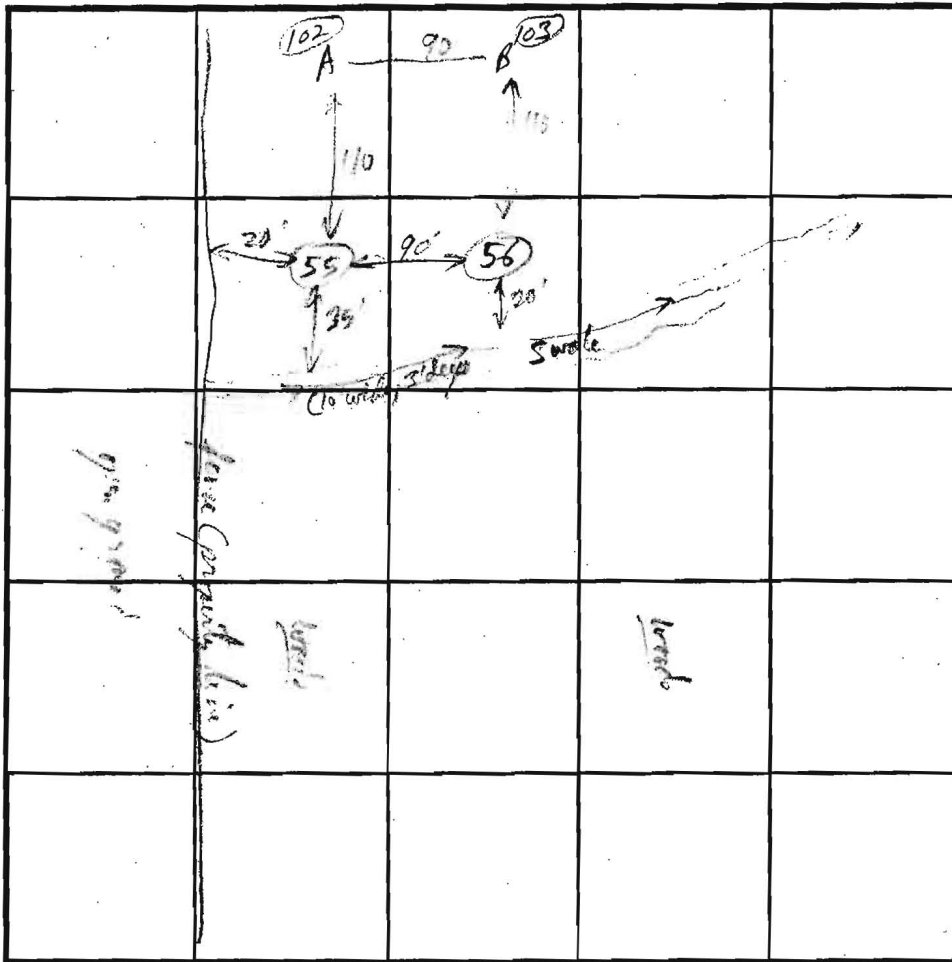

SOIL PROFILE

0'

INDICATE NORTH - NAME ADJOINING ROADWAY AS BASE LINE.

(No watch is 1h 20 min slow)

DATE	TEST NO.	DEPTH	PRE-WET		TEST - 1" DROP		TIME
			START	STOP	START	STOP	
5/24/01	56	v13' 4'	1:07:00	1:038:30			6' 31 min
	55	v13 1/2' 4 1/2'	1:10:00	1:14:30	1:16:00	1:24:30	10 min
110' No 55	(102) A	v13' 4'	1:41:41	1:42:30	1:42:30	1:44:30	2 min
	(103) B	v13'	1:59:00	2:01:00	2:01:00	2:03:30	2 1/2 min

REMARKS SDA's Must avoid swales.
 TYPE OF SOIL Glendale / Chester
 TESTED BY R. Pink ALSO PRESENT Tim Keaney, Mike
 TRENCH DESIGN DATA: AVERAGE PERCOLATION TIME 13 min TRENCH WIDTH 3
 INLET DEPTH 4 MAXIMUM BOTTOM DEPTH 6 SQ. FT./BEDROOM 240 ppp 9/4/01

perc cert
signed 11-20-02

