

MARYLAND DEPARTMENT OF THE ENVIRONMENT, WATER MANAGEMENT ADMINISTRATION
1800 Washington Blvd., Baltimore, Maryland 21230 (410) 537-3784

WATER WELL ABANDONMENT-SEALING REPORT FORM

SUBMIT COPIES OF COMPLETED FORM TO:

- * COUNTY ENVIRONMENT AGENCY (contact MDE, WMA if address needed)
- * WELL OWNER
- * MDE, WATER MANAGEMENT ADMINISTRATION, WELL PROGRAM

DATE WELL ABANDONED: 8/3/13 (month/day/year)

*OK
11/13*
*connected to public water
9/1/2005
RFB per N.Allen*

* PERMIT NUMBER OF ABANDONED WELL (if any) _____

* PERMIT NUMBER OF REPLACEMENT WELL _____

* PERSON ABANDONING WELL: Michael Tom


WELL DRILLERS LICENSE NUMBER: 162

CIRCLE: MWD/MSD/MGD

* OWNER'S NAME: Dae Lee

SITE LOCATION MAP

* WELL LOCATION:
COUNTY: Howard
NEAREST TOWN: Columbia
TAX MAP 41 BLOCK 6 PARCEL 252
SUBDIVISION: Holiday Hills
SECTION: _____ LOT: 48
NEAREST ROAD: 10717 Hunting Lane

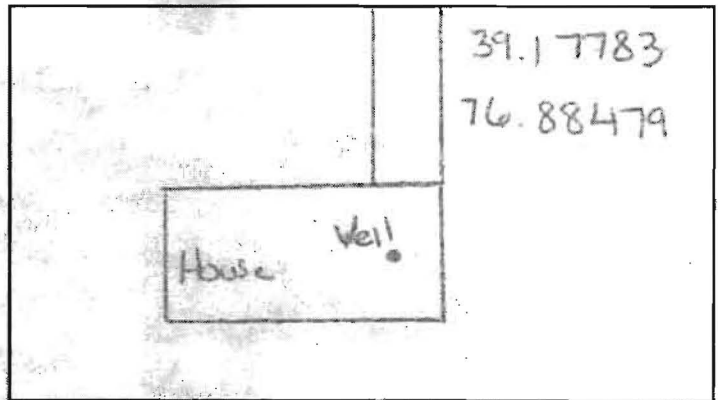

* TYPE OF WELL BEING ABANDONED:

- DRILLED _____ JETTED
- _____ BORED/AUGERED _____ HAND DUG
- _____ OTHER (specify) _____

* USE CODE:

- DOMESTIC _____ MUNICIPAL/PUBLIC
- _____ IRRIGATION _____ INDUSTRIAL
- _____ TEST/OBSERVATION _____ GEOTHERMAL

* TYPE OF CASING:

- STEEL _____ PLASTIC
- _____ CONCRETE _____ OTHER (specify) _____

* SIZE OF CASING: 6 INCHES IN DIAMETER

* DEPTH OF WELL: 80 FEET DEEP

* WAS ANY CASING REMOVED? _____ YES NO
if yes, length removed, in feet: _____

* WAS CASING RIPPED OR PERFORATED? _____ YES NO

LOG OF SEALING MATERIAL

MATERIAL	FEET	
	FROM	TO
Bentonite CLAY	80	0
VOLUME OF MATERIAL USED		
500 lbs		

SIGNATURE-MASTER WELL DRILLER OR SUPERVISING SANITARIAN _____

LICENSE # 162

MWD/MSD/MGD
CIRCLE ONE

DATE 8/5/13

W.H. Winegar & Son Plumbing & Heating, Inc.
 3005 Winifred Dr.
 Burtonsville, MD 20866
 (301)384-5818

Invoice

Date	Invoice #
11/18/2014	46245

Bill To
Dae Lee 10717 Hunting lane Columbia, MD

→ email daeyung2000@yaho.com

Job Location	P.O. Number	Terms

Quantity	Item Code	Description	Price Each	Amount
	SERVICE	~ Excavate yard to locate existing water line to house, tie new water line from new tap to old line in yard. ~ New tap to be supplied by others ~ Pump septic tank, expose tank, break top and fill in with dirt. ~ Excavate yard from existing sewer pipe to new sewer tap in front yard. ~ Supply and install new 4" schedule 40 PVC pipe with required cleanouts from existing line in backyard to new tap. ~ Backfill all excavation to rough grade with no guarantee on trees, grass or shrubs. ~ Spread grass seed and straw. ~ Plumbing permit and inspection included in price.	6,400.00	6,400.00
			Total	\$6,400.00

10717 Hunting Lane

FILE INQUIRY NOTES

Status of Wastewater Disposal

DATE	RESULTS OF REVIEW FOR FILE
5/24/16	<p>- Nancy Allen of Howard County Utilities confirmed that 10717 Hunting Lane is currently being billed for water service and sewer service.</p> <p>Water service was connected 9/1/2005. Sewer service was connected 12/15/2015.</p>
5/24/16	<p>- A Well Abandonment Report is stored on shared drive.</p>
5/25/16	<p>- I went to 10717 Hunting Lane to inspect for existence/absence of the septic tank. Mr Lee, the owner, informed me that the septic tank was "destroyed" (abandoned). He provided a copy of an Invoice from W.H. Winegar & Son Plumbing & Heating, Inc. Content of the Invoice indicates the septic tank was pumped dry then abandoned.</p>
	<p>Robert Buckner</p>