

MA

APPLICATION

HOWARD COUNTY

PERMIT APPLICATION

DEPARTMENT OF INSPECTIONS, LICENSES & PERMIT
3430 COURT HOUSE DRIVE, ELLICOTT CITY, MARYLAND 21043

SERIAL NUMBER

44619

BUILDING ADDRESS (HOUSE NO., STREET, TOWN OR AREA)

12401 TONDROP DR.

GRADING SEDIMENT CONTROL YES NO

DESCRIPTION OF WORK AUTHORIZED

NEW SNOW FAN HOME
W/ 3 CAR GARAGE
includes 2 6x6
Decorative guard
rail

LOT NO. PARCEL NO. SEC. AREA BLOCK NO. LIBER FOLIO

11 48 4 2 12

SUB DIVISION ZONE ZONE MAP ELEC. DIST. CENSUS TR.

BEAUFORT PARK R 45 5 6051-02 3BR

OWNER NAME AND ADDRESS PHONE NO.

ROBERT DAFFER 8300 Guilford Rd. 301 995-9246
PULTELY, MD 21046 3154

OCCUPANT'S NAME AND ADDRESS PHONE NO.

MA OWNER

ARCHITECT OR ENGINEER'S NAME AND ADDRESS PHONE NO.

N/A

CONTRACTOR'S NAME AND ADDRESS PHONE NO.

THE MASSIC CO. 301 924-2184
2080 WASHINGTON DR.
CLNEY, MD 20832

EXISTING USE PROPOSED USE

VACANT LOT SNOW FAN HOME

EST. CONSTRUCTION COST LICENSE NUMBER PERMIT FEE

105,000 1136

W/S CODE FOR OFFICE USE ONLY

DISTRICT IN FEET FROM R/W LINE TO FRONT BUILDING LINE 170.0

SIDE YARD 30.0

(DISTANCE IN FEET FROM SIDE BLDG. LINE TO SIDE PROPERTY LINE)

TO SIDE BUILDING LINE 145.0

DISTANCE IN FEET, REAR YD. REQUIRING SET

BACK (CORNER LOT ONLY)

SDP #

Check payable to: DIRECTOR OF FINANCE OF HOWARD COUNTY

CAUTION
To be placed in front of a permit placard has been issued
and no work on the job is a violation of the law.
If you are applying for a permit, you must be applied for 100% cash.

IMPORTANT: PLEASE SHOW ZIP CODES AND AREA CODES WHEREVER REQUIRED.

LP-89-591

SIZE OF BLDG. FRONT DEPTH HEIGHT

TYPE OF BLDG. AREA VOLUME ROOF

B. ROOMS
ROOMS
BATHS
FIREPLACES

FOOTINGS FOUNDATION S. WALLS

UTILITIES

WATER WELLS SEWER/SEPTIC GAS ELECTRICITY TYPE OF HEAT AC

HP

I have carefully examined and read this application and know the same is true and correct, and that in doing this work, all provisions of Howard County Ordinances and the State Laws of Maryland will be complied with, whether specified or not; and I will notify the Department of Inspections, and Permit twenty-four hours in advance when I am ready for the inspections called for elsewhere in the application; and that no work will be covered up until such inspections have been complied with.

SIGNATURE

MASSIC CO. VP 7/12/92
TITLE DATE

FUNCTION DATE SIGNATURE APPROVAL

ZONING/PLANNING X

SHA X

SEDIMENT/GRADING

BUILDING OFFICIAL X

WATER & SEWER

HEALTH DEPT. X 8/12/92

FIRE PROTECTION

STORM WATER MGMT

APPROVED DATE

Distribution of Copies:
White - Building Official
Green - Planning & Zoning

Yellow - Engineering
Pink - Health Dept.
Gold - S.H.A.




LOT 12

LOT 11

LOT 10

Elevations of
SEPTIC LOCATION
AS ADVISED
6/23/93
Cwellen

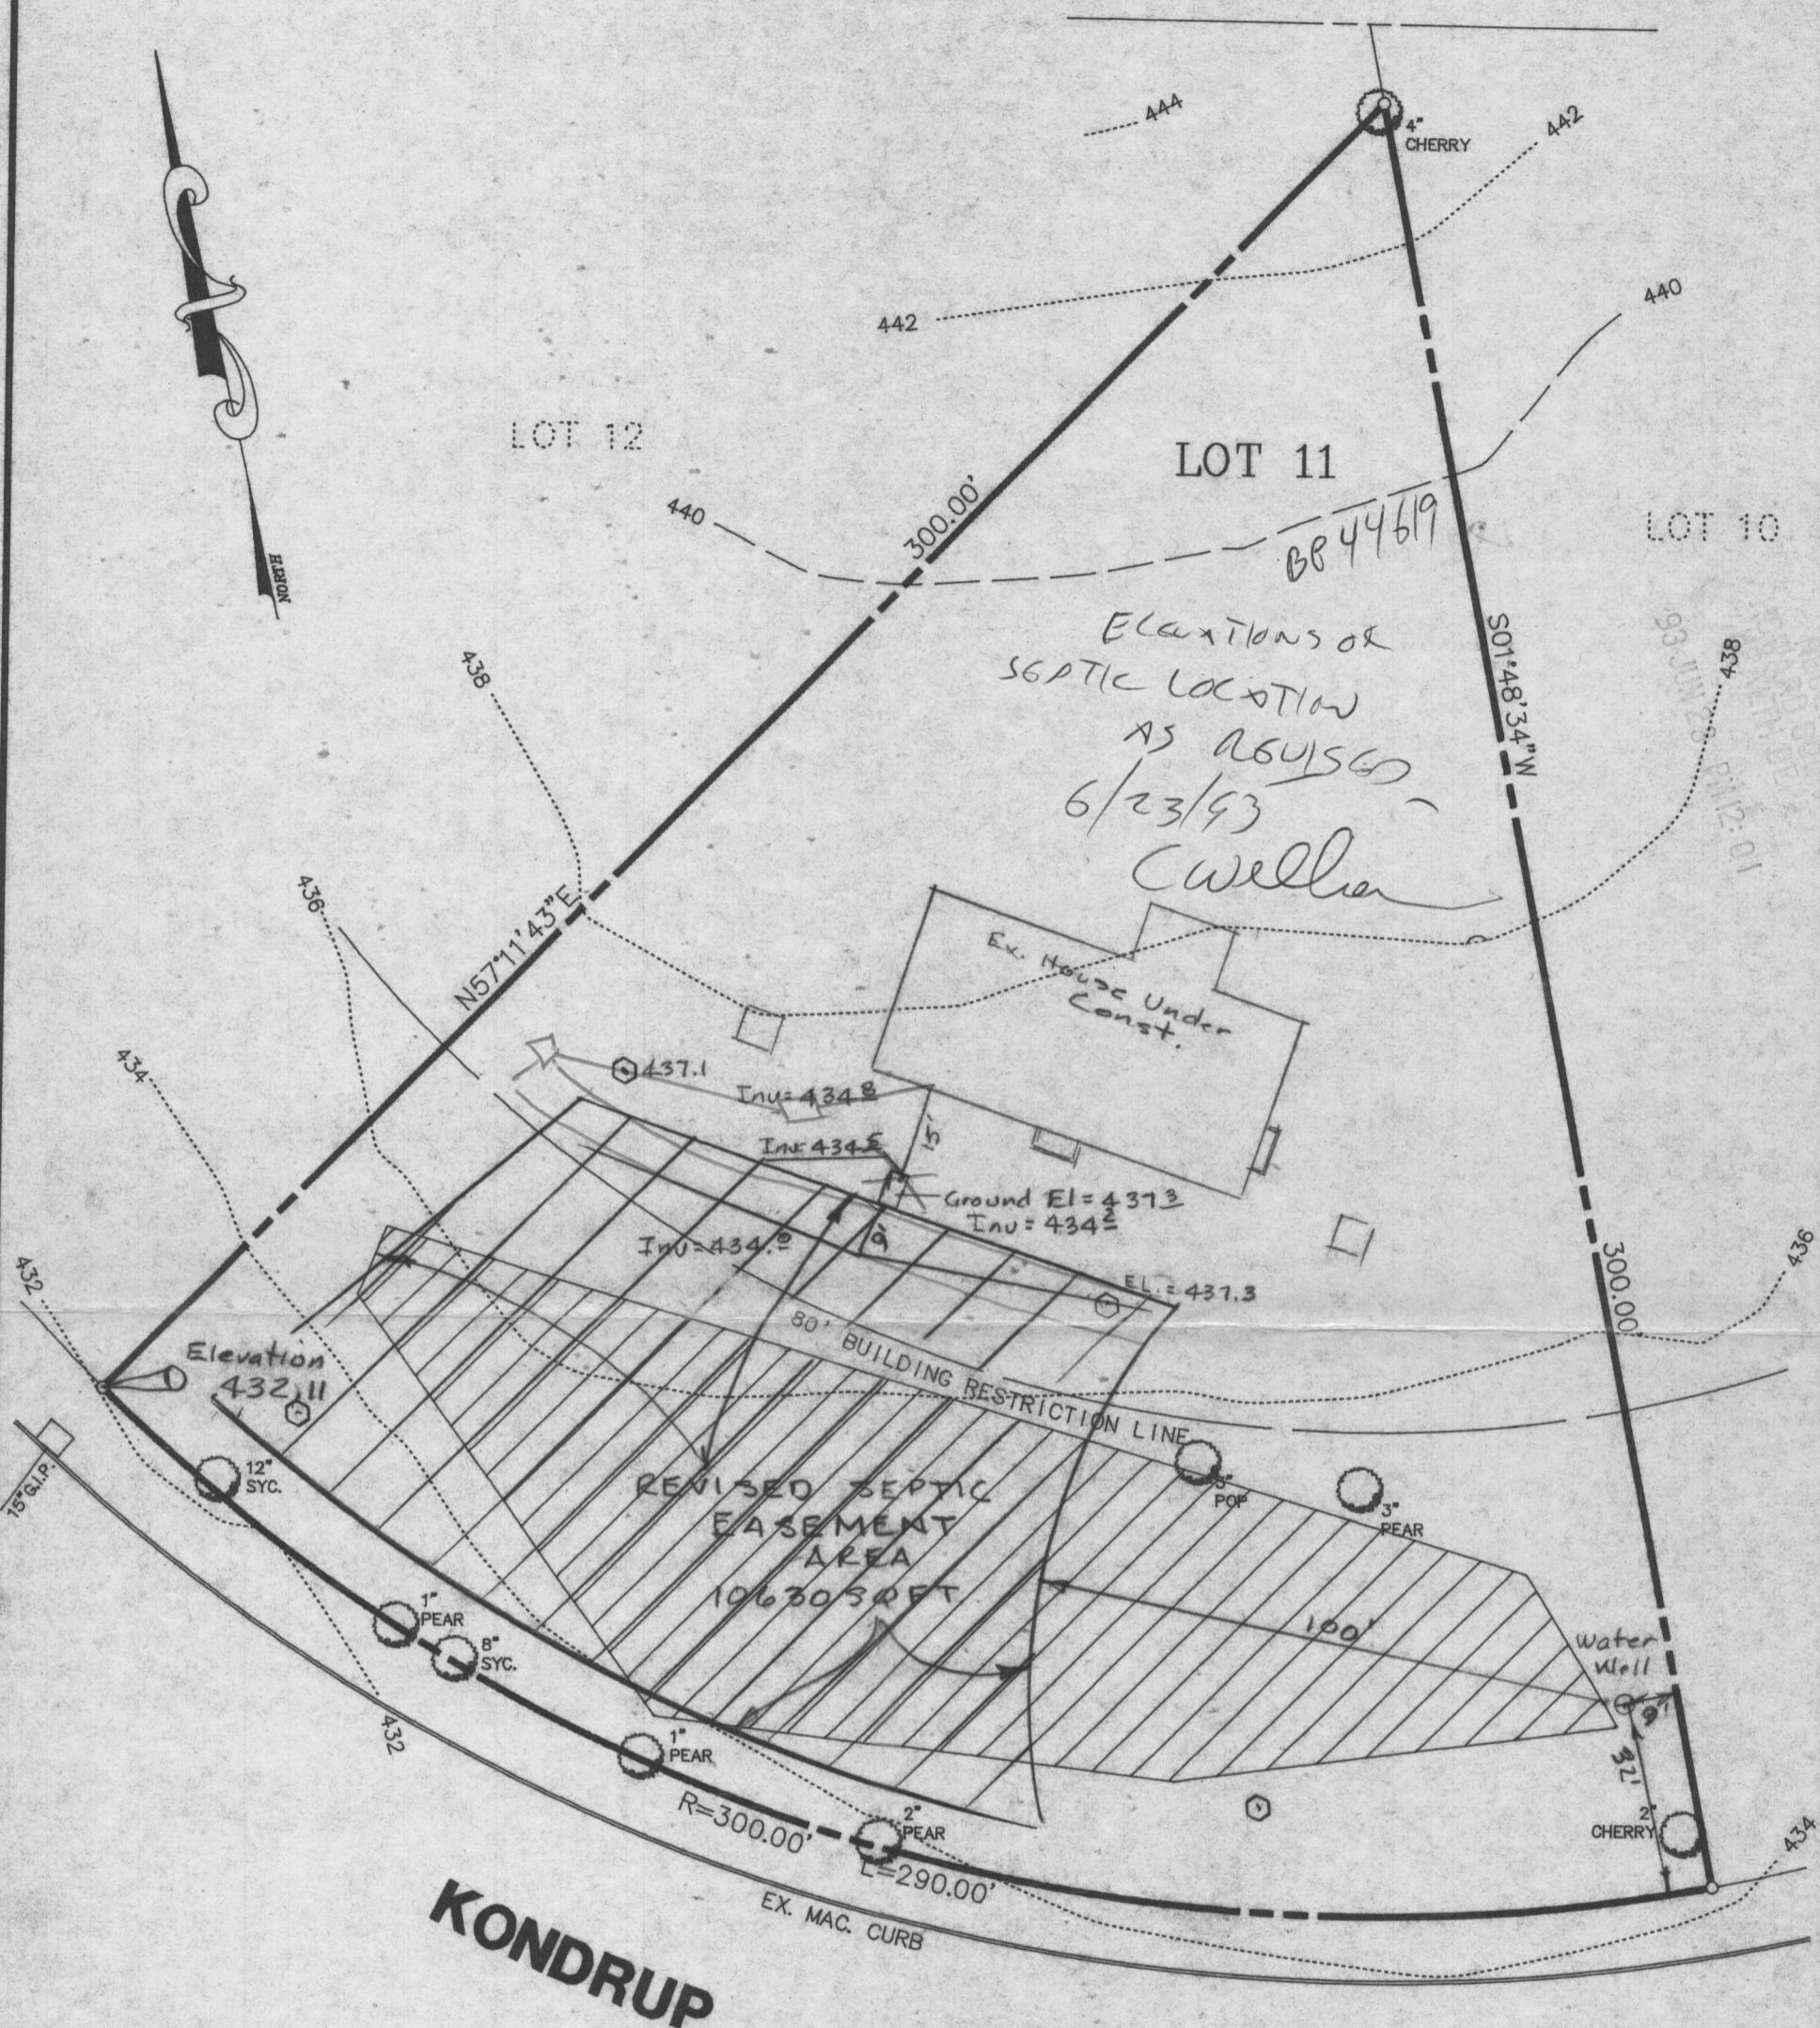

NOTE - Length of Septic
Field Trenches to be
Determined at Time of
Septic Permit Issuance.

SURVEYORS CERTIFICATE

Elevations shown hereon were established
from the Howard County Datum

Jack E. Clark
LAND SURVEYOR



LOT 11
BEAUFORT PARK

SECTION FOUR / AREA TWO
FIFTH ELECTION DISTRICT
HOWARD COUNTY, MARYLAND.

SCALE : 1" = 30' DATE : JULY 1992
REV. JUNE 1993

PREPARED BY:
THE J.E. CLARK COMPANY
LAND SURVEYING AND ENGINEERING

P.O. BOX 147 LAUREL, MARYLAND 20725
(301) 725 3442

920702-7