

APPLICATION

PERCOLATION TESTING

A _____

P _____

HOWARD COUNTY HEALTH DEPARTMENT
BUREAU OF ENVIRONMENTAL HEALTH
3525-H ELLICOTT MILLS DRIVE/ELLICOTT CITY, MARYLAND 21043
TELEPHONE: 313-2640

DISTRICT _____

DATE _____

TO: THE COUNTY HEALTH OFFICER
ELLICOTT CITY, MARYLAND

I HEREBY APPLY FOR THE NECESSARY TEST PRIOR TO APPLICATION FOR PERMIT TO CONSTRUCT (OR RECONSTRUCT) A SEWAGE DISPOSAL SYSTEM.

PROPERTY OWNER _____

ADDRESS _____ PHONE _____

AGENT OR PROSPECTIVE BUYER _____

ADDRESS _____ PHONE _____

PROPERTY LOCATION:

SUBDIVISION _____ LOT NO. *2 Revised*

ROAD AND DESCRIPTION _____

TAX MAP _____ PARCEL # _____

SIZE OF LOT _____ TYPE BLDG. _____
(SINGLE FAMILY DWELLING OR COMMERCIAL)

THE SYSTEM INSTALLED UNDER THIS APPLICATION IS ACCEPTABLE ONLY UNTIL PUBLIC FACILITIES BECOME AVAILABLE. I FULLY UNDERSTAND THE FEE CONNECTED WITH THE FILING OF THIS PERC TEST APPLICATION IS NON-REFUNDABLE UNDER ANY CIRCUMSTANCES. I ALSO AGREE TO COMPLY WITH ALL M.O.S.H.A. REQUIREMENTS IN TESTING THIS LOT.

(SIGNATURE OF APPLICANT)

APPROVED BY _____ FOR _____ DATE _____

DISAPPROVED BY _____ FOR _____ DATE _____

HOLD PENDING FURTHER TESTS _____

REASONS FOR REJECTION OR HOLDING _____

PERCOLATION TEST PLAT/PRELIMINARY PLAT - TITLE OR I.D. # _____ DATE _____

SITE DEVELOPMENT PLAN/FINAL PLAT - TITLE OR I.D. # _____ DATE _____

THIS IS NOT A PERMIT

COUNTY #

SOIL PROFILE

0' 2002

brn orge
si cll m

3-3 1/2

orge tan
yel brn

si l m
20-25% frags
scattered
pockets
@ 30% frags

12

2000

orge brn
si cll m

2-3

tan yel
orge
si l m

w/30-40%
decomposed
blk frags

9-9 1/2

15-20%
frags

13 1/2

1003 1002


orge brn
yel
sa cll m
15% frags

3-4

orge yel
tan


si sa l m
15-20%
saprolite
frags

11'9"
13 1/2

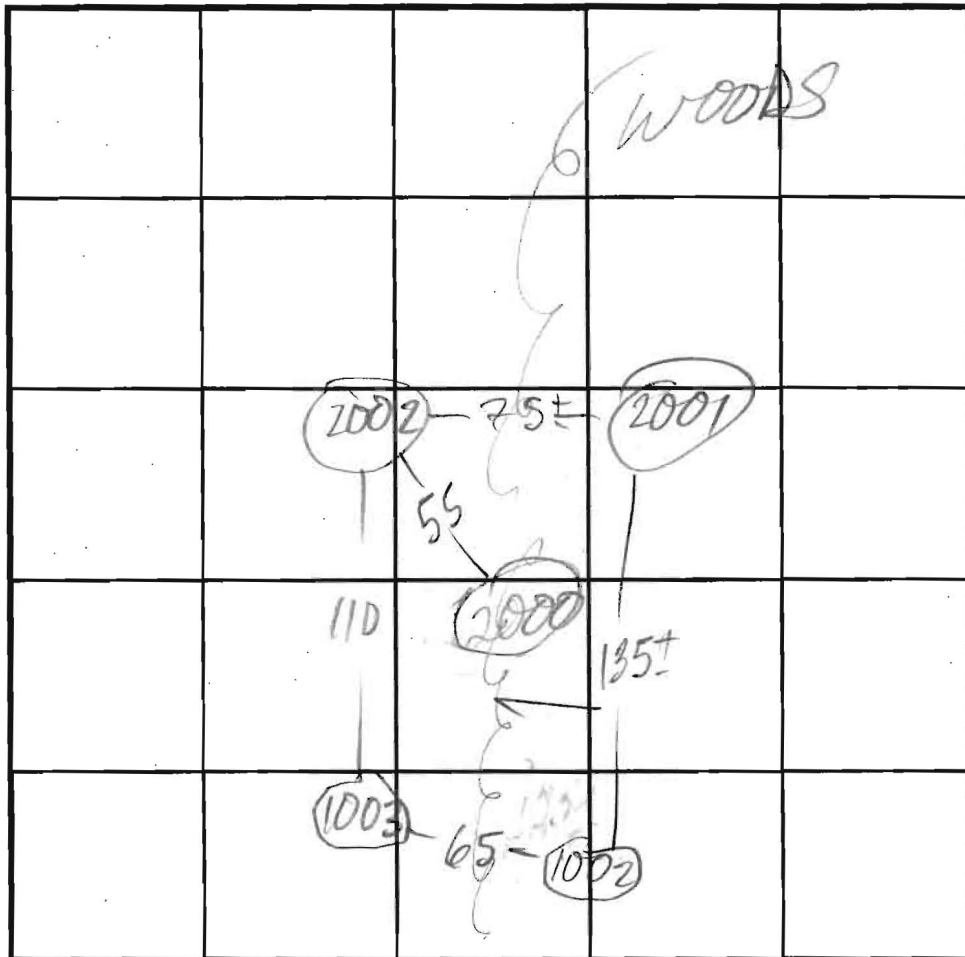

SOIL PROFILE

0'

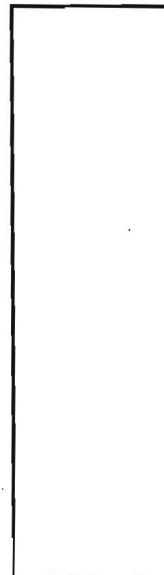

INDICATE NORTH - NAME ADJOINING ROADWAY AS BASE LINE.

DATE	TEST NO.	DEPTH	PRE-WET		TEST - 1" DROP		TIME
			START	STOP	START	STOP	
8/20/01	2002	4 1/2 / 12	12:01	12:03	12:03	12:08	5
	2000	4 1/2 / 13 1/2	12:25	12:26	12:26	12:28	2
	2001	4 / 12	1:05	1:09	1:09	1:13	4
	1003	4 1/2 / 11'9"					4
	1002	5 / 13 1/2					4

REMARKS

TYPE OF SOIL

TESTED BY M.R.

ALSO PRESENT


TRENCH DESIGN DATA: AVERAGE PERCOLATION TIME 4

TRENCH WIDTH 3

INLET DEPTH 3

MAXIMUM BOTTOM DEPTH 5

SQ. FT./BEDROOM 180

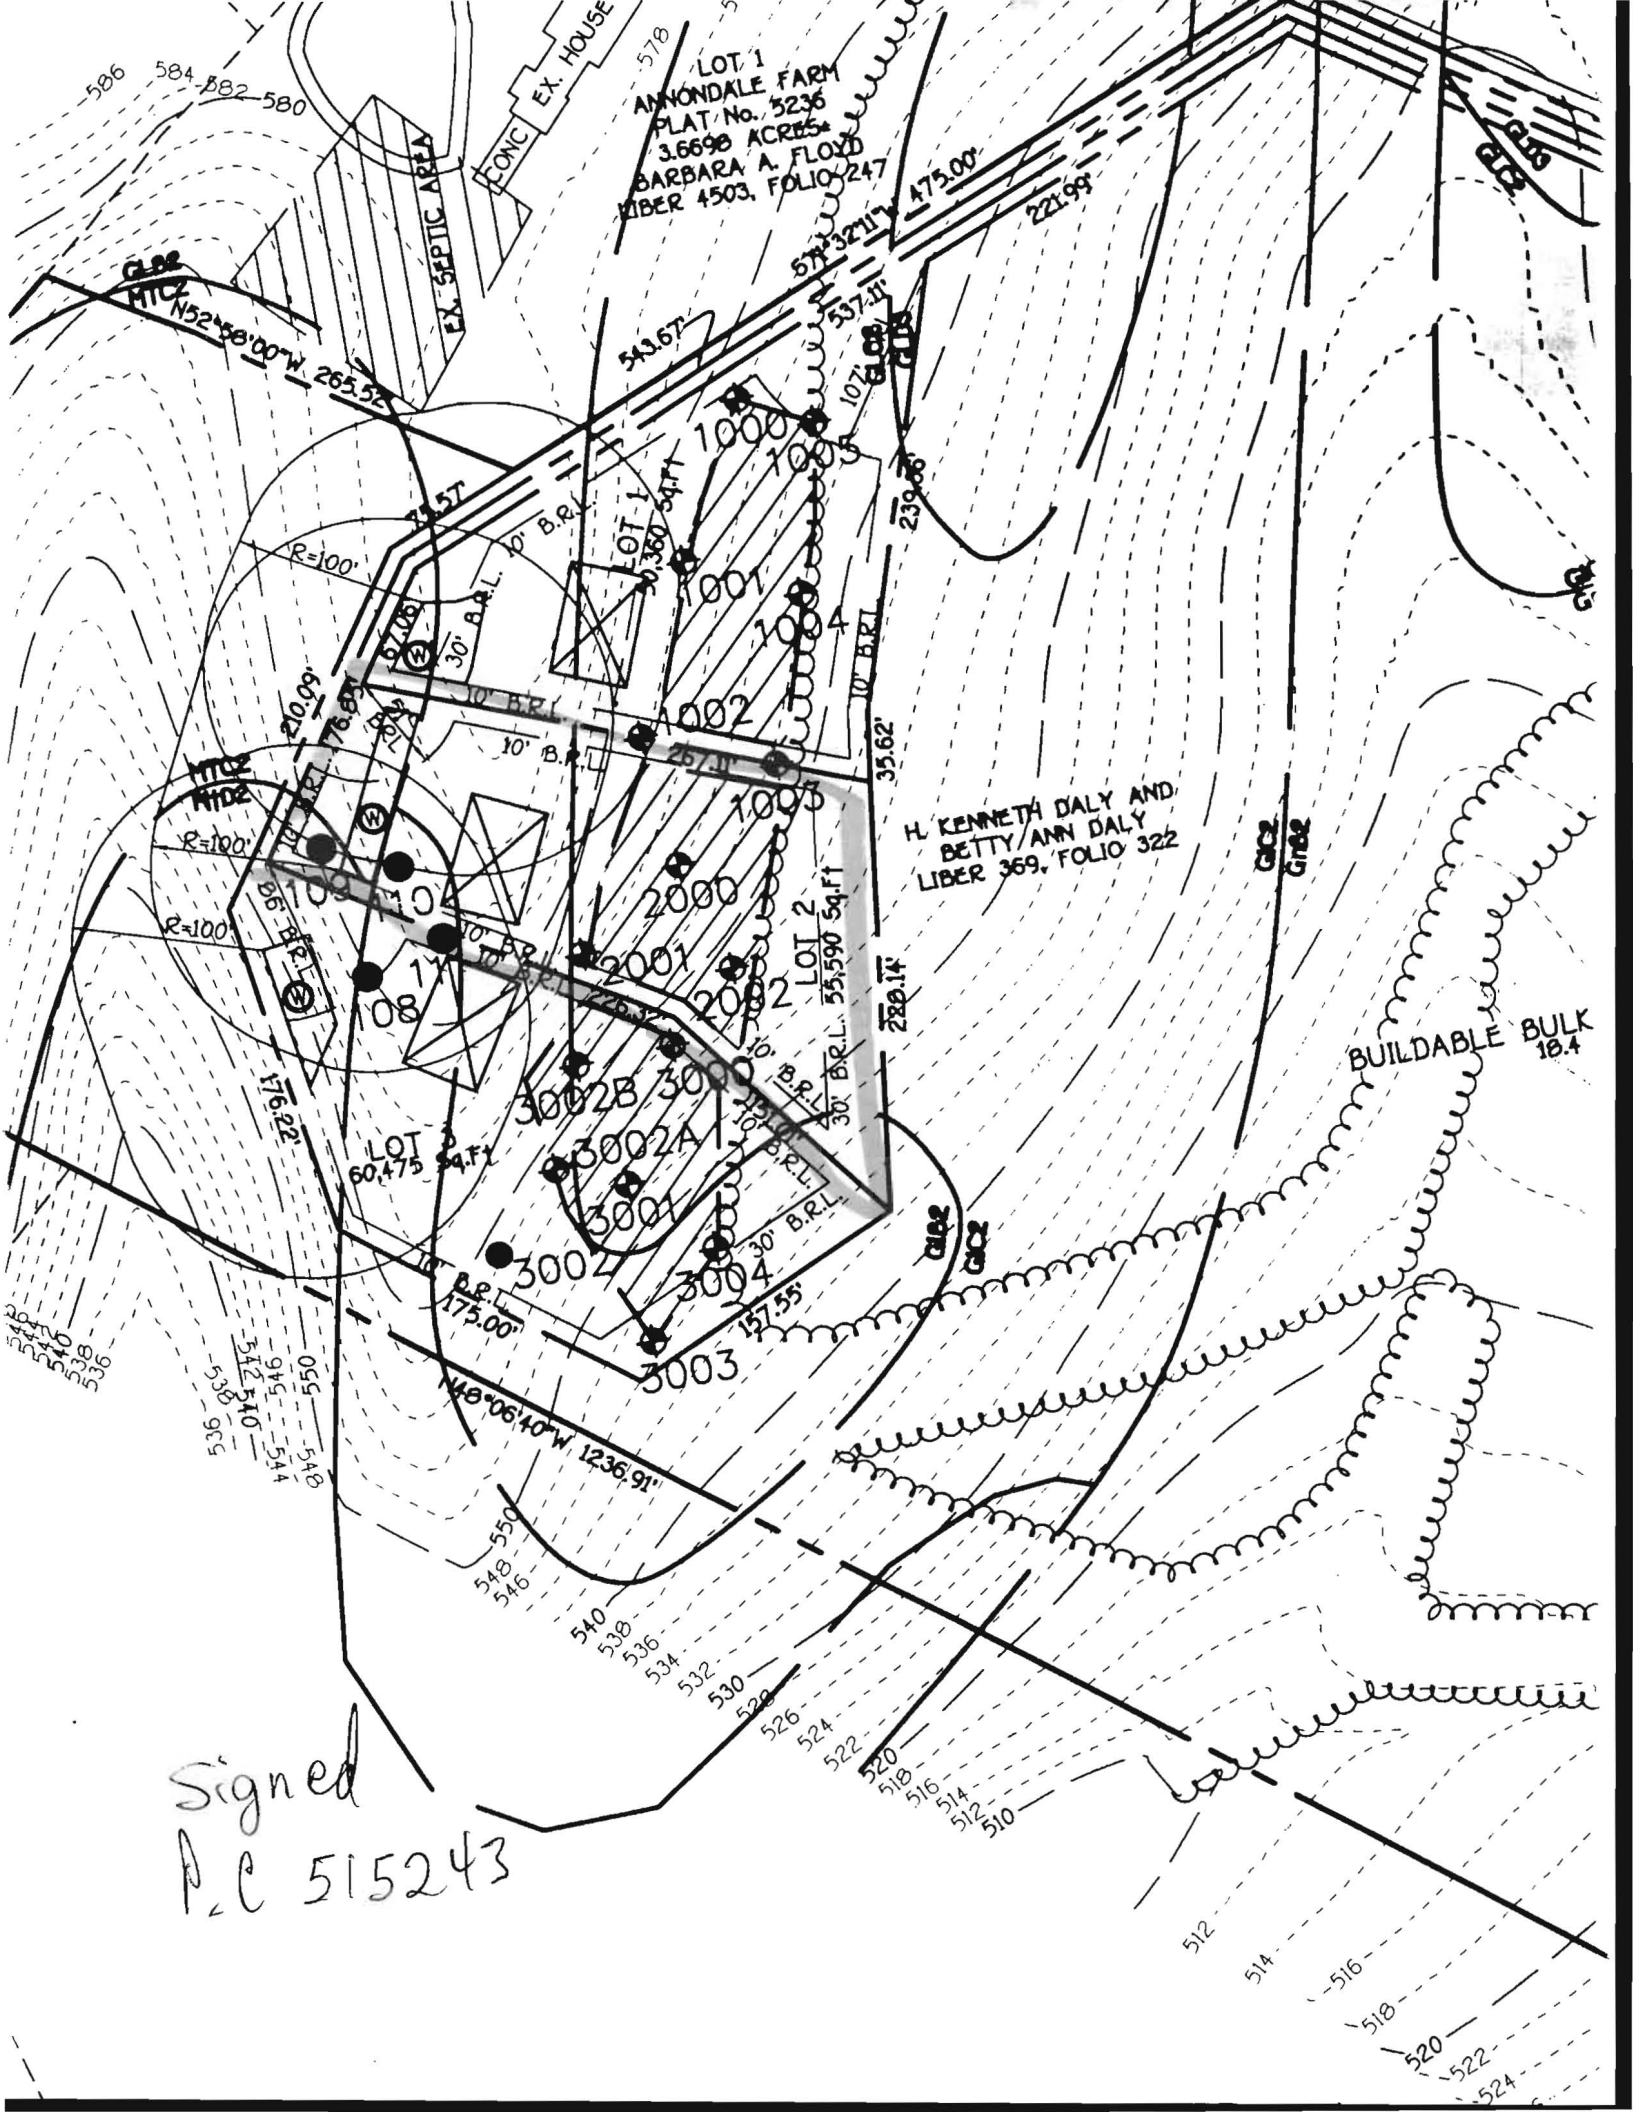

LOT 1
 ANNONDALE FARM
 PLAT No. 5236
 3.6698 ACRES
 BARBARA A. FLOYD
 LIBER 4503, FOLIO 247

H. KENNETH DALY AND
 BETTY/ANN DALY
 LIBER 369, FOLIO 322

BUILDABLE BULK
 18.4

Signed
 P.C. 515243