

MARYLAND DEPARTMENT OF THE ENVIRONMENT, WATER MANAGEMENT ADMINISTRATION  
1800 Washington Blvd., Baltimore, Maryland 21230 (410) 537-3784

WATER WELL ABANDONMENT-SEALING REPORT FORM

SUBMIT COPIES OF COMPLETED FORM TO:

- \* COUNTY ENVIRONMENT AGENCY (contact MDE, WMA if address needed)
- \* WELL OWNER
- \* MDE, WATER MANAGEMENT ADMINISTRATION, WELL PROGRAM

DATE WELL ABANDONED: 04/10/12 (month/day/year)

\* PERMIT NUMBER OF ABANDONED WELL (if any)

\* PERMIT NUMBER OF REPLACEMENT WELL

\* PERSON ABANDONING WELL: TOMY OLESZCZAK SR


WELL DRILLERS LICENSE NUMBER: 1960-098

CIRCLE: MWD/MSD/MGD

\* OWNER'S NAME: HOWARD Co.

SITE LOCATION MAP

\* WELL LOCATION:  
COUNTY: HOWARD  
NEAREST TOWN: ATKINS, MD.  
TAX MAP 39-19124 BLOCK 76-77919 PARCEL  
SUBDIVISION: ARBORETUM WOODS  
SECTION: LOT:  
NEAREST ROAD: MAYFIELD RD.

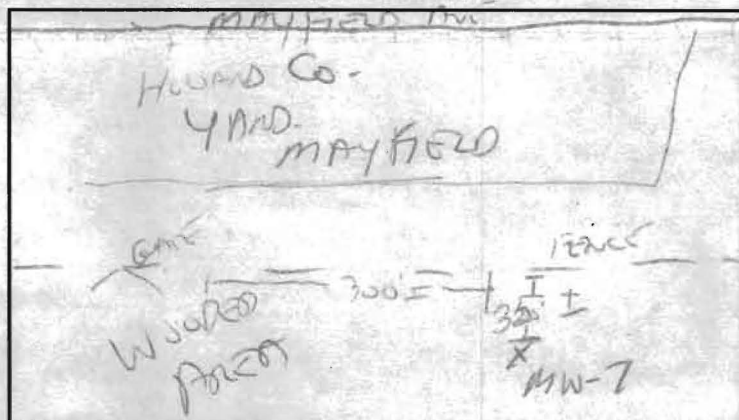

\* TYPE OF WELL BEING ABANDONED:

☒ DRILLED ☐ JETTED  
☒ BORED/AUGERED ☐ HAND DUG  
☐ OTHER (specify) \_\_\_\_\_

\* USE CODE:

☐ DOMESTIC ☐ MUNICIPAL/PUBLIC  
☐ IRRIGATION ☐ INDUSTRIAL  
☒ TEST/OBSERVATION ☐ GEOTHERMAL

\* TYPE OF CASING:

☐ STEEL ☒ PLASTIC  
☐ CONCRETE ☐ OTHER (specify) \_\_\_\_\_

\* SIZE OF CASING: 4" INCHES IN DIAMETER

\* DEPTH OF WELL: 24" FEET DEEP

\* WAS ANY CASING REMOVED? ☒ YES ☐ NO  
if yes, length removed, in feet: 6

\* WAS CASING RIPPED OR PERFORATED? ☐ YES ☒ NO

LOG OF SEALING MATERIAL

MATERIAL	FEET	
	FROM	TO
<u>Topsoil Hole Plug</u>	<u>0.0</u> <u>0.5'</u>	<u>0.5</u> <u>24.0'</u>
VOLUME OF MATERIAL USED		
<u>150 LBS HOLE PLUG</u>		

SIGNATURE-MASTER WELL DRILLER OR SUPERVISING SANITARIAN

LICENSE #

CIRCLE ONE

DATE

DENV 828 JULY 1997