

MARYLAND DEPARTMENT OF THE ENVIRONMENT, WATER MANAGEMENT ADMINISTRATION
1800 Washington Blvd., Baltimore, Maryland 21230 (410) 537-3784

WATER WELL ABANDONMENT-SEALING REPORT FORM

SUBMIT COPIES OF COMPLETED FORM TO:

- * COUNTY ENVIRONMENT AGENCY (contact MDE, WMA if address needed)
- * WELL OWNER
- * MDE, WATER MANAGEMENT ADMINISTRATION, WELL PROGRAM

DATE WELL ABANDONED: 04/10/12 (month/day/year)

* PERMIT NUMBER OF ABANDONED WELL (if any) N/A

* PERMIT NUMBER OF REPLACEMENT WELL

* PERSON ABANDONING WELL: Tony, 01522268

WELL DRILLERS LICENSE NUMBER: MCD-098


CIRCLE: MWD/MSD/MGD

* OWNER'S NAME: HOWARD Co.

SITE LOCATION MAP

* WELL LOCATION:
COUNTY: HOWARD
NEAREST TOWN: ELK RIDGE, MD.
TAX MAP BLOCK PARCEL
SUBDIVISION: ARROW WOODS
SECTION: LOT:
NEAREST ROAD: MAYFIELD RD

G.P.S. 39.19133
76.77955

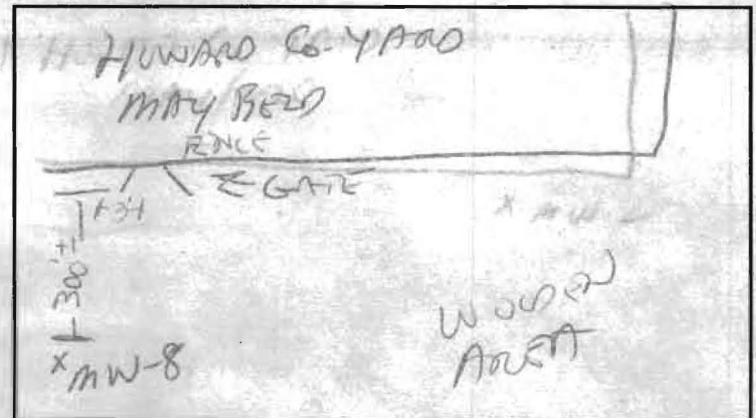

* TYPE OF WELL BEING ABANDONED:

 DRILLED JETTED
 BORED/AUGERED HAND DUG
 OTHER (specify)

* USE CODE:

 DOMESTIC MUNICIPAL/PUBLIC
 IRRIGATION INDUSTRIAL
 TEST/OBSERVATION GEOTHERMAL

* TYPE OF CASING:

 STEEL PLASTIC
 CONCRETE OTHER (specify)

* SIZE OF CASING: 4" INCHES IN DIAMETER

* DEPTH OF WELL: 13 FEET DEEP

* WAS ANY CASING REMOVED? ✓ YES NO
if yes, length removed, in feet: 13

* WAS CASING RIPPED OR PERFORATED? YES NO

LOG OF SEALING MATERIAL

MATERIAL	FEET	
	FROM	TO
Topsoil	0.0	0.5
Hole Plug	0.5	13.0
VOLUME OF MATERIAL USED		
100 LBS HOLE PLUG		

SIGNATURE-MASTER WELL DRILLER OR SUPERVISING SANITARIAN

LICENSE #

MWD/MSD/MGD

CIRCLE ONE

DATE

DENV 828 JULY 1997

2) COUNTY ENVIRONMENTAL AGENCY