

MARYLAND DEPARTMENT OF THE ENVIRONMENT, WATER MANAGEMENT ADMINISTRATION  
 1800 Washington Blvd., Baltimore, Maryland 21230 (410) 537-3784

\*\*\*\*\*  
 WATER WELL ABANDONMENT-SEALING REPORT FORM  
 \*\*\*\*\*

SUBMIT COPIES OF COMPLETED FORM TO:

- \* COUNTY ENVIRONMENT AGENCY (contact MDE, WMA if address needed)
- \* WELL OWNER
- \* MDE, WATER MANAGEMENT ADMINISTRATION, WELL PROGRAM

OK  
 9/14/16SC

DATE WELL ABANDONED: 5-29-09 (month/day/year)

\* PERMIT NUMBER OF ABANDONED WELL (if any)

Ho - 88 - 1869 (165 Sand)

\* PERMIT NUMBER OF REPLACEMENT WELL

none - -


\* PERSON ABANDONING WELL: Stephen Saul

WELL DRILLERS LICENSE NUMBER: 421

CIRCLE: MWD/MSD/MGD

\* OWNER'S NAME: State of Maryland  
 Motor Fuel Testing Lab

SITE LOCATION MAP

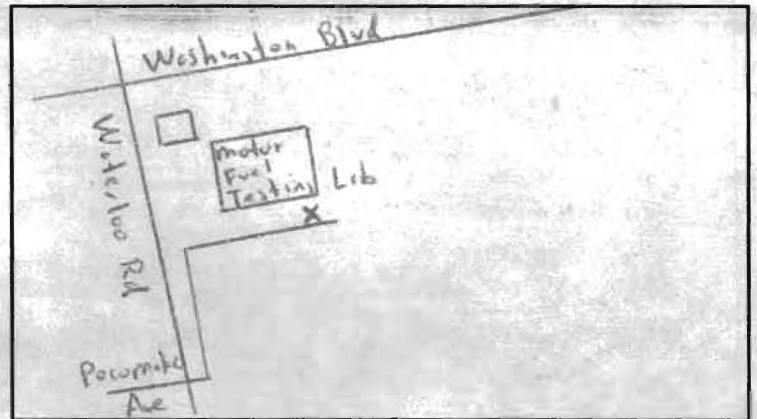

\* WELL LOCATION:  
 COUNTY: Howard  
 NEAREST TOWN: Jessup  
 TAX MAP \_\_\_\_\_ BLOCK \_\_\_\_\_ PARCEL \_\_\_\_\_  
 SUBDIVISION: \_\_\_\_\_  
 SECTION: \_\_\_\_\_ LOT: \_\_\_\_\_  
 NEAREST ROAD: 7275-B Waterloo Rd

\* TYPE OF WELL BEING ABANDONED:

- DRILLED \_\_\_\_\_ JETTED
- \_\_\_\_\_ BORED/AUGERED \_\_\_\_\_ HAND DUG
- \_\_\_\_\_ OTHER (specify) \_\_\_\_\_

\* USE CODE:

- \_\_\_\_\_ DOMESTIC \_\_\_\_\_ MUNICIPAL/PUBLIC
- \_\_\_\_\_ IRRIGATION \_\_\_\_\_ INDUSTRIAL
- TEST/OBSERVATION \_\_\_\_\_ GEOTHERMAL

\* TYPE OF CASING:

- \_\_\_\_\_ STEEL \_\_\_\_\_ PLASTIC
- \_\_\_\_\_ CONCRETE \_\_\_\_\_ OTHER (specify) \_\_\_\_\_

\* SIZE OF CASING: 4 INCHES IN DIAMETER

\* DEPTH OF WELL: 15 FEET DEEP

\* WAS ANY CASING REMOVED? \_\_\_\_\_ YES \_\_\_\_\_  NO  
 if yes, length removed, in feet: \_\_\_\_\_

\* WAS CASING RIPPED OR PERFORATED? \_\_\_\_\_ YES \_\_\_\_\_  NO

LOG OF SEALING MATERIAL

MATERIAL	FEET	
	FROM	TO
Cement Grout	0	7
Bentonite	7	15
VOLUME OF MATERIAL USED		
50 lb Portland Cement		
75 lb Bentonite Chips		

SIGNATURE-MASTER WELL DRILLER OR SUPERVISING SANITARIAN

LICENSE # 421

MWD/MSD/MGD 5-30-09  
 CIRCLE ONE DATE