

MARYLAND DEPARTMENT OF THE ENVIRONMENT, WATER MANAGEMENT ADMINISTRATION
1800 Washington Blvd., Baltimore, Maryland 21230 (410) 537-3784

WATER WELL ABANDONMENT-SEALING REPORT FORM

SUBMIT COPIES OF COMPLETED FORM TO:

- * COUNTY ENVIRONMENT AGENCY (contact MDE, WMA if address needed)
- * WELL OWNER
- * MDE, WATER MANAGEMENT ADMINISTRATION, WELL PROGRAM

DATE WELL ABANDONED: 7-29-11 (month/day/year)

OK
8/17/16 SC

* PERMIT NUMBER OF ABANDONED WELL (if any) _____

* PERMIT NUMBER OF REPLACEMENT WELL _____

* PERSON ABANDONING WELL: Jonathan Leatherman

WELL DRILLERS LICENSE NUMBER: _____

CIRCLE: MWD/MSD/MGD

* OWNER'S NAME: Sumoco

SITE LOCATION MAP

* WELL LOCATION:

COUNTY: Howard


NEAREST TOWN: Ellicott City

TAX MAP _____ BLOCK _____ PARCEL _____

SUBDIVISION: _____

SECTION: _____ LOT: _____

NEAREST ROAD: 4755 Dorsey Hall Rd

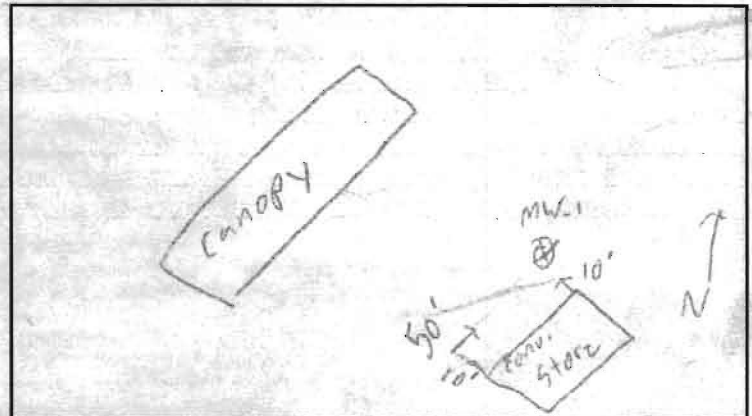

* TYPE OF WELL BEING ABANDONED:

☒ DRILLED _____ JETTED _____
_____ BORED/AUGERED _____ HAND DUG _____
_____ OTHER (specify) _____

* USE CODE:

_____ DOMESTIC _____ MUNICIPAL/PUBLIC
_____ IRRIGATION _____ INDUSTRIAL
☒ TEST/OBSERVATION _____ GEOTHERMAL _____

* TYPE OF CASING:

_____ STEEL _____ ☒ PLASTIC
_____ CONCRETE _____ OTHER (specify) _____

* SIZE OF CASING: 2" INCHES IN DIAMETER

* DEPTH OF WELL: 30 FEET DEEP

* WAS ANY CASING REMOVED? _____ YES _____ ☒ NO
if yes, length removed, in feet: _____

* WAS CASING RIPPED OR PERFORATED? _____ YES _____ ☒ NO

LOG OF SEALING MATERIAL

MATERIAL	FEET	
	FROM	TO
Portland cement	30'	0
VOLUME OF MATERIAL USED		
9.9 gallons		

SIGNATURE-MASTER WELL DRILLER OR SUPERVISING SANITARIAN

LICENSE #

CIRCLE ONE

DATE

DENV 828 JULY 1997

2) COUNTY ENVIRONMENTAL AGENCY

