

MARYLAND DEPARTMENT OF THE ENVIRONMENT, WATER MANAGEMENT ADMINISTRATION

1800 Washington Blvd., Baltimore, Maryland 21230 (410) 537-3784

WATER WELL ABANDONMENT-SEALING REPORT FORM

SUBMIT COPIES OF COMPLETED FORM TO:

- \* COUNTY ENVIRONMENT AGENCY (contact MDE, WMA if address needed)
- \* WELL OWNER
- \* MDE, WATER MANAGEMENT ADMINISTRATION, WELL PROGRAM

DATE WELL ABANDONED: 8/23/10 (month/day/year)

\* PERMIT NUMBER OF ABANDONED WELL (if any)

\* PERMIT NUMBER OF REPLACEMENT WELL

\* PERSON ABANDONING WELL: Jason Miller


WELL DRILLERS LICENSE NUMBER: M6D110

CIRCLE: MWD/MSD/MGD

\* OWNER'S NAME: Southside Oil LLC

SITE LOCATION MAP

\* WELL LOCATION:  
 COUNTY: Howard  
 NEAREST TOWN: Elkridge  
 TAX MAP 37 BLOCK        PARCEL 687  
 SUBDIVISION:         
 SECTION:        LOT: 118  
 NEAREST ROAD: 6070 W Marshalee Dr

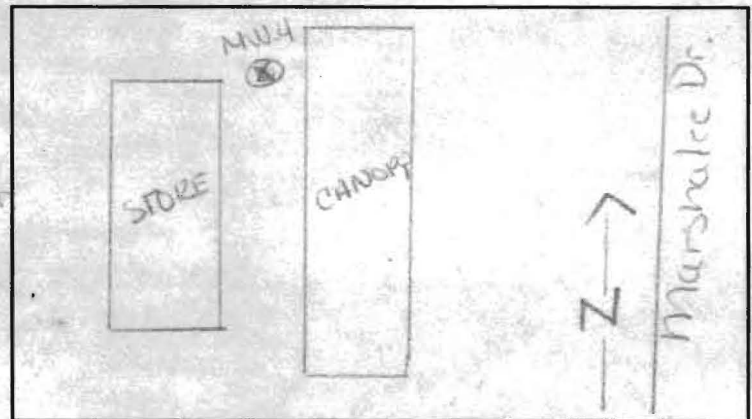

\* TYPE OF WELL BEING ABANDONED:

       DRILLED        JETTED  
X BORED/AUGERED        HAND DUG  
       OTHER (specify)       

\* USE CODE:

       DOMESTIC        MUNICIPAL/PUBLIC  
       IRRIGATION        INDUSTRIAL  
X TEST/OBSERVATION        GEOTHERMAL

\* TYPE OF CASING:

       STEEL X PLASTIC  
       CONCRETE        OTHER (specify)       

\* SIZE OF CASING: 2 INCHES IN DIAMETER

\* DEPTH OF WELL: 29 FEET DEEP

\* WAS ANY CASING REMOVED?        YES X NO  
 if yes, length removed, in feet:       

\* WAS CASING RIPPED OR PERFORATED?        YES X NO

LOG OF SEALING MATERIAL

MATERIAL	FEET	
	FROM	TO
Cement Bentonite grout	0 0 0	29
VOLUME OF MATERIAL USED		
1.45 cu. ft		

SIGNATURE-MASTER WELL DRILLER OR SUPERVISING SANITARIAN

LICENSE #

MWD/MSD/MSD 9/2/10

DATE

DENV 828 JULY 1997