

MW-5

MARYLAND DEPARTMENT OF THE ENVIRONMENT, WATER MANAGEMENT ADMINISTRATION
1800 Washington Blvd., Baltimore, Maryland 21230 (410) 537-3784

WATER WELL ABANDONMENT-SEALING REPORT FORM

SUBMIT COPIES OF COMPLETED FORM TO:

- * COUNTY ENVIRONMENT AGENCY (contact MDE, WMA if address needed)
- * WELL OWNER
- * MDE, WATER MANAGEMENT ADMINISTRATION, WELL PROGRAM

DATE WELL ABANDONED: 8/23/10 (month/day/year)

OK
8/18/10 SC

* PERMIT NUMBER OF ABANDONED WELL (if any) _____

* PERMIT NUMBER OF REPLACEMENT WELL _____

* PERSON ABANDONING WELL: Jason Miller


WELL DRILLERS LICENSE NUMBER: M60110

CIRCLE: MWD/MSD/MGD

* OWNER'S NAME: Southside Oil, Co.

SITE LOCATION MAP

* WELL LOCATION:
COUNTY: Howard
NEAREST TOWN: Elkridge
TAX MAP 37 BLOCK _____ PARCEL 687
SUBDIVISION: _____
SECTION: _____ LOT: A8
NEAREST ROAD: 6070 W. Marshalee Dr.

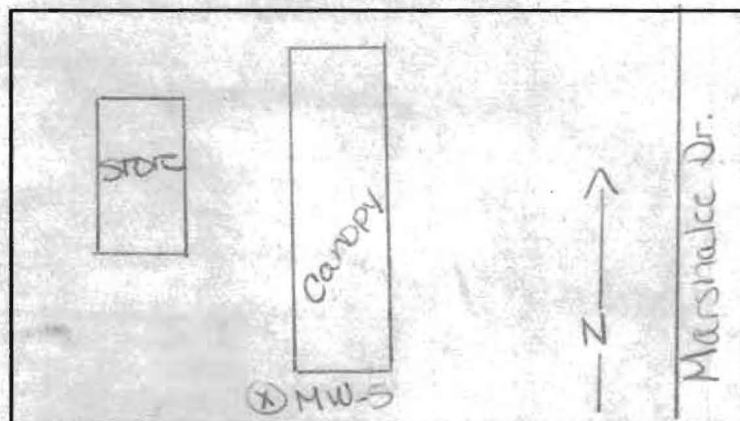

* TYPE OF WELL BEING ABANDONED:

_____☐ DRILLED _____☐ JETTED
X _____☒ BORED/AUGERED _____☐ HAND DUG
_____☐ OTHER (specify) _____

* USE CODE:

_____☐ DOMESTIC _____☐ MUNICIPAL/PUBLIC
_____☐ IRRIGATION _____☐ INDUSTRIAL
X _____☒ TEST/OBSERVATION _____☐ GEOTHERMAL

* TYPE OF CASING:

_____☐ STEEL _____☒ PLASTIC
_____☐ CONCRETE _____☐ OTHER (specify) _____

* SIZE OF CASING: 2 INCHES IN DIAMETER

* DEPTH OF WELL: 29 FEET DEEP

* WAS ANY CASING REMOVED? YES 20 NO
if yes, length removed, in feet: _____

* WAS CASING RIPPED OR PERFORATED? YES X NO

LOG OF SEALING MATERIAL

MATERIAL	FEET	
	FROM	TO
Cement Bentonite/ grout	0.00 1.00 - 0.02 0.02	29
VOLUME OF MATERIAL USED		
1.45 cu. ft.		

SIGNATURE-MASTER WELL DRILLER OR SUPERVISING SANITARIAN

LICENSE #

MWD/MSD/MGD

CIRCLE ONE

DATE