

Dr. Peter Beilenson, M.D., M.P.H., Health Officer

DEMOLITION REQUEST FORM

(Please fill in all blanks)

Information of Property to be Demolished:

Security Development
Current Owner's Name Kings Arms & etc

9536 Whiskey Bottom Rd
Property Address

Kings Arms & etc
Subdivision (if applicable)

Lot #

All Prior Owners' Names (if requested or known)

47
Tax Map

174
Parcel #

Tax ID #

SFH Development
Purpose/Reason for Demolition

SFH Development
Future plans of property after demo (i.e. subdivision, parking lot, re-build new house, etc...)

If a subdivision, SDP# _____ Has the structure(s) been deemed unsafe by DILP ☐ YES ☒ NO

UTILITY RECORDS:

Property currently connected to public water ☒ YES ☐ NO

Property currently connected to public sewer ☒ YES ☐ NO

Does the property currently have any wells and/or septic systems ☐ YES ☒ NO
→ Explain:

*Note: Any wells and/or septic systems that are to remain may require an approved percolation certification plan under *Howard County Code Sec. 3.805*

*Note: Any septic systems that are to be abandoned must be done by a septic contractor with documentation of the process.

*Note: All abandoned wells are to be sealed by a well driller licensed by the Maryland State Board of Well Drillers *COMAR Sec 26.04.04.11 Abandonment Standards D (3)*

COMMENTS:

Will Phippen
Applicant's Name (please print)

410-302-5436
Applicant's Phone #

W.phippen@sdcgroep.com
Applicant's Email

410-750-1947
Applicant's Fax #

[Signature]
Applicant's Signature

9/1/15
Date

MARYLAND DEPARTMENT OF THE ENVIRONMENT, WATER MANAGEMENT ADMINISTRATION
1800 Washington Blvd., Baltimore, Maryland 21230 (410) 537-3784

WATER WELL ABANDONMENT-SEALING REPORT FORM

SUBMIT COPIES OF COMPLETED FORM TO:

- * COUNTY ENVIRONMENTAL AGENCY (contact MDE, WMA if address needed)
- * WELL OWNER
- * MDE, WATER MANAGEMENT ADMINISTRATION, WELL PROGRAM

DATE WELL ABANDONED: 11/27/15 (month/day/year)

* PERMIT NUMBER OF ABANDONED WELL (if any) _____

* PERMIT NUMBER OF REPLACEMENT WELL: _____

* PERSON ABANDONING WELL: ROBERT COPSEY WELL DRILLER'S LICENSE NUMBER: 161

CIRCLE: MWD / MSD / MGD

* OWNER'S NAME: KINGS ARMS 6 LLC

* WELL LOCATION:

COUNTY: HOWARD COUNTY

NEAREST TOWN: LAUREL

TAX MAP 0047 BLOCK _____ PARCEL 0174

SUBDIVISION: 0000


SECTION: _____ LOT: _____

STREET ADDRESS: 9536 WHISKEY BOTTOM RD

LATITUDE 3 9 . 0 7 2 1 5 3

LONGITUDE 7 6 . 5 0 2 2 7 8

SITE LOCATION MAP

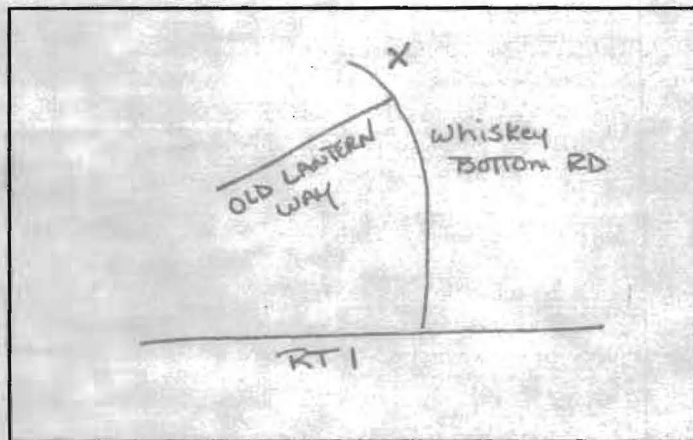

* TYPE OF WELL BEING ABANDONED:

DRILLED JETTED
BORED HAND DUG
OTHER (specify) _____

* USE CODE:

DOMESTIC MUNICIPAL/PUBLIC
IRRIGATION INDUSTRIAL
TEST/OBSERVATION GEOTHERMAL

* TYPE OF CASING:

STEEL PLASTIC
CONCRETE OTHER (specify)
TERRACOTTA

SIZE OF CASING: 24" INCHES IN DIAMETER

DEPTH OF WELL: 20' FEET DEEP

WAS ANY CASING REMOVED? YES NO

If yes, length removed, in feet: 5

WAS CASING RIPPED OR PERFORATED? YES NO

LOG OF SEALING MATERIAL

MATERIAL	FEET	
	FROM	TO
Clean gravel	20'	5'
CONCRETE	5'	2'
clean fill	2'	0
VOLUME OF MATERIAL USED		

SIGNATURE-MASTER WELL DRILLER OR SUPERVISING SANITARIAN LICENSE#

161 MWD / MSD / MGS

CIRCLE ONE

DATE

COUNTY

Security Development LLC
P.O. Box 417
Ellicott City, MD 21041

November 9, 2015

Brian Baker
Howard County Health Department
Environmental Sanitarian
Well and Septic Program

RE: Demo release — Single Family Home
9536 Whiskey Bottom Rd


Mr. Baker:

Security Development LLC formally requests a release from the Well and Septic Department of the Howard County Health Department for the existing single family home location on Whiskey Bottom Rd at the address below:

9536 Whiskey Bottom Road
Laurel, MD 20723

The house is on public water and sewer.
Please contact me with any questions or concerns. Thank you.

Sincerely,



William J. Pippen



Bureau of Environmental Health

8930 Stanford Blvd, Columbia, MD 21045
Main: 410-313-2640 | Fax: 410-313-2648
TDD 410-313-2323 | Toll Free 1-866-313-6300
www.hchealth.org
Facebook: www.facebook.com/hocohealth
Twitter: HowardCoHealthDep

Maura J. Rossman, M.D., Health Officer

December 21, 2015

MEMORANDUM

TO: Will Pippen
Security Development Corporation
8480 Baltimore National Pike
Suite 415
Ellicott City, Maryland 21043

FROM: Brian Baker, R.S.
(410) 313 - 2643
Well and Septic Program
Bureau of Environmental Health

RE: 9536 Whiskey Bottom Road
Laurel, MD 20723
Map: 47, Grid: 22, Parcel: 174
Tax ID: 06450091

The Howard County Health Department has no objection to the release of the demolition permit for the referenced property.

Documentation has been provided showing that the hand dug well has been sealed. There is no evidence of a septic system. The Health Department must be notified if any unknown well or septic system components are found during the demolition. They must be properly abandoned and/or sealed.

Cc: File

MARYLAND DEPARTMENT OF THE ENVIRONMENT, WATER MANAGEMENT ADMINISTRATION
1800 Washington Blvd., Baltimore, Maryland 21230 (410) 537-3784

WATER WELL ABANDONMENT-SEALING REPORT FORM

SUBMIT COPIES OF COMPLETED FORM TO:

- * COUNTY ENVIRONMENTAL AGENCY (contact MDE, WMA if address needed)
- * WELL OWNER
- * MDE, WATER MANAGEMENT ADMINISTRATION, WELL PROGRAM

DATE WELL ABANDONED: 11/27/15 (month/day/year)

* PERMIT NUMBER OF ABANDONED WELL (if any) _____

* PERMIT NUMBER OF REPLACEMENT WELL: _____

* PERSON ABANDONING WELL: ROBERT COPSEY WELL DRILLER'S LICENSE NUMBER: 161

* OWNER'S NAME: KINGS ARMS 6 LLC


CIRCLE: MWD MSD MGD

* WELL LOCATION:
COUNTY: HOWARD COUNTY
NEAREST TOWN: LAUREL
TAX MAP 0047 BLOCK _____ PARCEL 0174
SUBDIVISION: 0000
SECTION: _____ LOT: _____
STREET ADDRESS: 9536 WHISKEY BOTTOM RD

LATITUDE 39.072153

LONGITUDE 76.502278

SITE LOCATION MAP

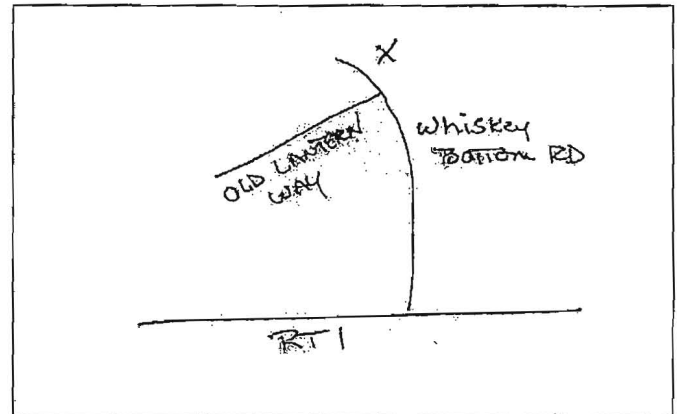

* TYPE OF WELL BEING ABANDONED:
_____DRILLED _____JETTED
_____BORED _____HAND DUG
_____OTHER (specify) _____

* USE CODE:
_____DOMESTIC _____MUNICIPAL/PUBLIC
_____IRRIGATION _____INDUSTRIAL
_____TEST/OBSERVATION _____GEOTHERMAL

* TYPE OF CASING:
_____STEEL _____PLASTIC
_____CONCRETE _____OTHER (specify)
TERRAZZOTA

SIZE OF CASING: 24" INCHES IN DIAMETER

DEPTH OF WELL: 20' FEET DEEP

WAS ANY CASING REMOVED? YES NO
If yes, length removed, in feet: 5

WAS CASING RIPPED OR PERFORATED? YES NO

SIGNATURE-MASTER WELL DRILLER OR SUPERVISING SANITARIAN Robert P. Copsey LICENSE# 161

MWD MSD MGS
CIRCLE ONE

11/27/15
DATE

ORIGINAL