

MARYLAND DEPARTMENT OF THE ENVIRONMENT, WATER MANAGEMENT ADMINISTRATION  
1800 Washington Blvd., Baltimore, Maryland 21230 (410) 537-3784

WATER WELL ABANDONMENT-SEALING REPORT FORM

SUBMIT COPIES OF COMPLETED FORM TO:

- \* COUNTY ENVIRONMENT AGENCY (contact MDE, WMA if address needed)
- \* WELL OWNER
- \* MDE, WATER MANAGEMENT ADMINISTRATION, WELL PROGRAM

DATE WELL ABANDONED: 4-29-09 (month/day/year)

OK  
9/14/16 SC

\* PERMIT NUMBER OF ABANDONED WELL (if any) \_\_\_\_\_

\* PERMIT NUMBER OF REPLACEMENT WELL \_\_\_\_\_

\* PERSON ABANDONING WELL: Allen Compton

WELL DRILLERS LICENSE NUMBER: 009


CIRCLE: MWD/MSD/MGD

\* OWNER'S NAME: Eddie Harrison

Arthur Lambert

\* WELL LOCATION:

SITE LOCATION MAP

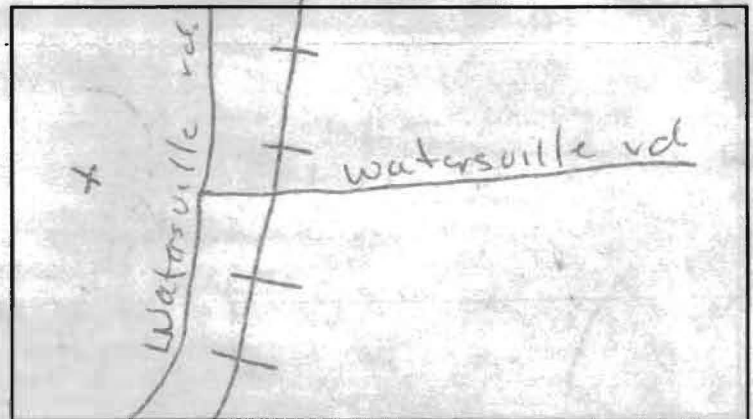

COUNTY: Howard

NEAREST TOWN: Mount Airy

TAX MAP \_\_\_\_\_ BLOCK \_\_\_\_\_ PARCEL \_\_\_\_\_

SUBDIVISION: \_\_\_\_\_

SECTION: \_\_\_\_\_ LOT: \_\_\_\_\_

NEAREST ROAD: 270 Watersville rd

\* TYPE OF WELL BEING ABANDONED:

☒ DRILLED ☐ JETTED  
☐ BORED/AUGERED ☐ HAND DUG  
☐ OTHER (specify) \_\_\_\_\_

\* USE CODE:

☒ DOMESTIC ☐ MUNICIPAL/PUBLIC  
☐ IRRIGATION ☐ INDUSTRIAL  
☐ TEST/OBSERVATION ☐ GEOTHERMAL

\* TYPE OF CASING:

☒ STEEL ☐ PLASTIC  
☐ CONCRETE ☐ OTHER (specify) Terracotta

\* SIZE OF CASING: 6 INCHES IN DIAMETER

\* DEPTH OF WELL: 70' FEET DEEP

\* WAS ANY CASING REMOVED? ☐ YES ☒ NO  
if yes, length removed, in feet: \_\_\_\_\_

\* WAS CASING RIPPED OR PERFORATED? ☐ YES ☒ NO

LOG OF SEALING MATERIAL

MATERIAL	FEET	
	FROM	TO
<u>Cement</u>	<u>0</u>	<u>70</u>
VOLUME OF MATERIAL USED		
<u>20 Bags</u>		

SIGNATURE-MASTER WELL DRILLER OR SUPERVISING SANITARIAN

LICENSE #

009 MWD/MSD/MGD

CIRCLE ONE

DATE

DENV 828 JULY 1997

2) COUNTY ENVIRONMENTAL AGENCY