

\*\*\*\*\*  
WATER WELL ABANDONMENT-SEALING REPORT FORM  
\*\*\*\*\*

SUBMIT COPIES OF COMPLETED FORM TO:

- \* COUNTY ENVIRONMENTAL AGENCY (contact MDE, WMA if address needed)
- \* WELL OWNER
- \* MDE, WATER MANAGEMENT ADMINISTRATION, WELL PROGRAM

OK  
9/14/16 SC

DATE WELL ABANDONED: 5-16-2014 (month/day/year)

\* PERMIT NUMBER OF ABANDONED WELL (if any) none — —

\* PERMIT NUMBER OF REPLACEMENT WELL: none — —

\* PERSON ABANDONING WELL: Joseph & Mayne WELL DRILLER'S LICENSE NUMBER: MSD024


CIRCLE: MWD / MSD / MGD

\* OWNER'S NAME: Landon Reep

\* WELL LOCATION:

SITE LOCATION MAP

COUNTY: Howard  
NEAREST TOWN: Reboon - (Mail address Woodbine)  
TAX MAP \_\_\_\_\_ BLOCK \_\_\_\_\_ PARCEL \_\_\_\_\_  
SUBDIVISION: \_\_\_\_\_  
SECTION: \_\_\_\_\_ LOT: \_\_\_\_\_  
STREET ADDRESS: 2600 Woodbine Rd

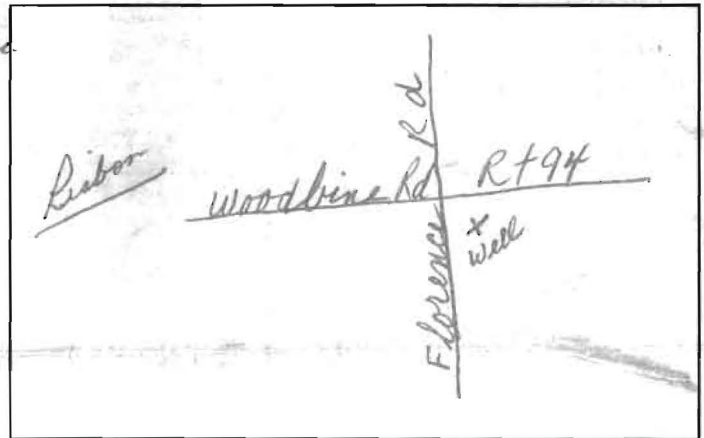

LATITUDE 3 9.31051 -

LONGITUDE 7 77.10890 -

- \* TYPE OF WELL BEING ABANDONED:
- DRILLED
  - BORED
  - OTHER (specify) \_\_\_\_\_
  - JETTED
  - HAND DUG

LOG OF SEALING MATERIAL

- \* USE CODE:
- DOMESTIC
  - IRRIGATION
  - TEST/OBSERVATION
  - MUNICIPAL/PUBLIC
  - INDUSTRIAL
  - GEOTHERMAL

MATERIAL	FEET	
	FROM	TO
<u>Cement + gravel mixed</u>	<u>0</u>	<u>39</u>

- \* TYPE OF CASING:
- STEEL
  - CONCRETE
  - PLASTIC
  - OTHER (specify) \_\_\_\_\_

SIZE OF CASING: 6ft INCHES IN DIAMETER

DEPTH OF WELL: 39 FEET DEEP

WAS ANY CASING REMOVED?  YES  NO  
If yes, length removed, in feet: \_\_\_\_\_

WAS CASING RIPPED OR PERFORATED?  YES  NO

VOLUME OF MATERIAL USED

32 yards cement -

SIGNATURE-Joseph & Mayne MASTER WELL DRILLER OR SUPERVISING SANITARIAN LICENSE# MSD024

MWD / MSD / MGS

CIRCLE ONE

DATE 5-16-2014

COUNTY