

MARYLAND DEPARTMENT OF THE ENVIRONMENT, WATER MANAGEMENT ADMINISTRATION  
2500 BROENING HIGHWAY, BALTIMORE, MARYLAND 21224, (410) 631-3784

WATER WELL ABANDONMENT-SEALING REPORT FORM

SUBMIT COPIES OF COMPLETED FORM TO:

- \* COUNTY ENVIRONMENT AGENCY (contact MDE, WMA if address needed)
- \* WELL OWNER
- \* MDE, WATER MANAGEMENT ADMINISTRATION, WELL PROGRAM

DATE WELL ABANDONED: April 13, 2011 (month/day/year)


OK  
9/14/16 SC

- \* PERMIT NUMBER OF ABANDONED WELL (if any)
- \* PERMIT NUMBER OF REPLACEMENT WELL
- \* PERSON ABANDONING WELL: Paul VanDoren
- \* OWNER'S NAME: First Evangelical Lutheran Church
- \* WELL LOCATION: Howard  
COUNTY: Howard  
NEAREST TOWN: Ellicott City  
TAX MAP 24 BLOCK 10 PARCEL 135  
SUBDIVISION: \_\_\_\_\_  
SECTION: \_\_\_\_\_ LOT: \_\_\_\_\_  
NEAREST ROAD: 3604 Chattam Road

HO 94 4430

WELL DRILLERS LICENSE NUMBER: WRO - 062  
CIRCLE: MWD/MSD/MGD

SITE LOCATION MAP

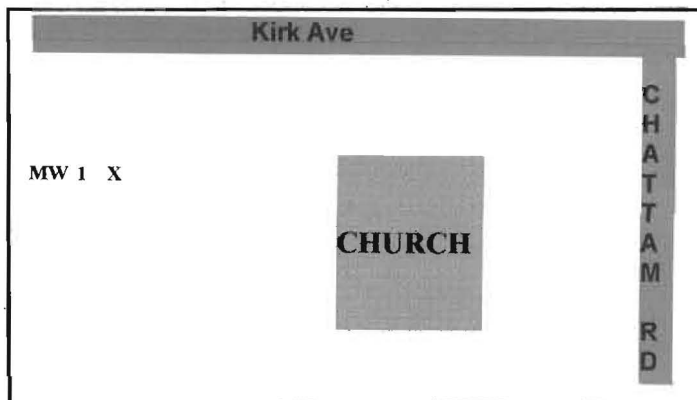

TYPE OF WELL BEING ABANDONED:

☒ DRILLED ☐ JETTED  
☐ BORED/AUGERED ☐ HAND DUG  
☐ OTHER (specify) \_\_\_\_\_

USE CODE:

☐ DOMESTIC ☐ MUNICIPAL/PUBLIC  
☐ IRRIGATION ☐ INDUSTRIAL  
☒ TEST/OBSERVATION ☐ GEOTHERMAL

TYPE OF CASING:

☐ STEEL ☒ PLASTIC  
☐ CONCRETE ☐ OTHER (specify) \_\_\_\_\_

SIZE OF CASING: 4 INCHES IN DIAMETER

DEPTH OF WELL: 42' FEET DEEP

WAS ANY CASING REMOVED? ☒ YES ☐ NO  
if yes, length removed, in feet: 2'

WAS CASING RIPPED OR PERFORATED? ☒ YES ☐ NO

LOG OF SEALING MATERIAL

MATERIAL	FEET	
	FROM	TO
ASPHALT	0'	1'
HYDRATED BENTONITE CHIPS	1'	42'
VOLUME OF MATERIAL USED		
BENTONITE 250 lbs 25 gal Water		

SIGNATURE - MASTER WELL DRILLER OR SUPERVISING SANITARIAN [Signature]

047

LICENSE #

MWD/MSD/ MGD April 27, 2011

CIRCLE ONE

DATE