

MARYLAND DEPARTMENT OF THE ENVIRONMENT, WATER MANAGEMENT ADMINISTRATION
 1800 Washington Blvd., Baltimore, Maryland 21230 (410) 537-3784

 WATER WELL ABANDONMENT-SEALING REPORT FORM

SUBMIT COPIES OF COMPLETED FORM TO:

- * COUNTY ENVIRONMENT AGENCY (contact MDE, WMA if address needed)
- * WELL OWNER
- * MDE, WATER MANAGEMENT ADMINISTRATION, WELL PROGRAM

OK
 9/14/16SC

DATE WELL ABANDONED: 5-29-09 (month/day/year)

* PERMIT NUMBER OF ABANDONED WELL (if any) _____

HO - 88 - 1868 no tag found

* PERMIT NUMBER OF REPLACEMENT WELL _____

none - -

* PERSON ABANDONING WELL: Stephen Saul


WELL DRILLERS LICENSE NUMBER: _____

CIRCLE: MWD/MSD/MGD

* OWNER'S NAME: State of Maryland Motor Fuel Testing Lab

SITE LOCATION MAP

* WELL LOCATION:
 COUNTY: Howard
 NEAREST TOWN: Jessup
 TAX MAP _____ BLOCK _____ PARCEL _____
 SUBDIVISION: _____
 SECTION: _____ LOT: _____
 NEAREST ROAD: 7775 B Waterloo Rd

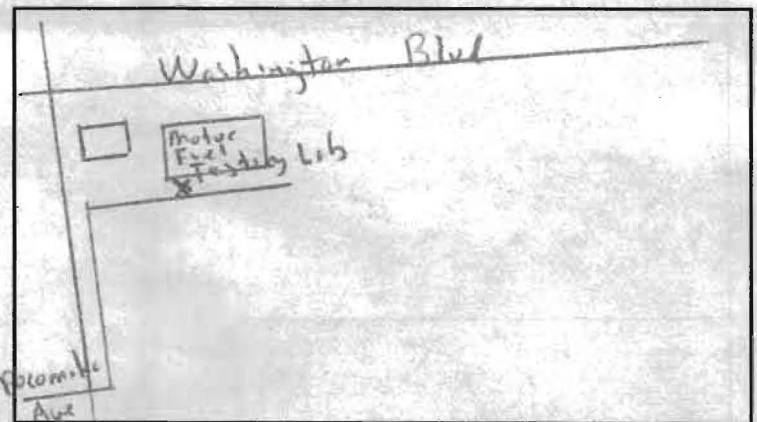

* TYPE OF WELL BEING ABANDONED:

- DRILLED JETTED
- BORED/AUGERED HAND DUG
- OTHER (specify) _____

LOG OF SEALING MATERIAL

MATERIAL	FEET	
	FROM	TO
Cement Grout	0	5
Bentonite	5	15
VOLUME OF MATERIAL USED		
40 lb Portland Cement		
90 lb Bentonite chips		

* USE CODE:

- DOMESTIC MUNICIPAL/PUBLIC
- IRRIGATION INDUSTRIAL
- TEST/OBSERVATION GEOTHERMAL

* TYPE OF CASING:

- STEEL PLASTIC
- CONCRETE OTHER (specify) _____

* SIZE OF CASING: 4 INCHES IN DIAMETER

* DEPTH OF WELL: 15 FEET DEEP

* WAS ANY CASING REMOVED? YES NO
 if yes, length removed, in feet: _____

* WAS CASING RIPPED OR PERFORATED? YES NO

SIGNATURE - MASTER WELL DRILLER OR SUPERVISING SANITARIAN _____

LICENSE # 421

MWD/MSD/MGD
 CIRCLE ONE

5-30-09
 DATE