



Howard County
Health Department

Bureau of Environmental Health

8930 Stanford Boulevard, Columbia, MD 21045

Main: 410-313-2640 | Fax: 410-313-2648

TDD 410-313-2323 | Toll Free 1-866-313-6300

www.hchealth.org

Facebook: www.facebook.com/hocohealth

Maura J. Rossman, M.D., Health Officer

RECEIPT DATE: 10/31/16

ONSITE SEWAGE DISPOSAL SYSTEM

P 559817

INSTALLATION

APPROVAL DATE: 11/14/16 

PERMIT

A _____

MINOR REPAIR

PROPERTY ADDRESS: 3715 Woodbine Road

SUBDIVISION: _____

LOT: _____

TAX ID: 04-319591

CONTRACTOR: Fogle's Septic Clean Inc.

EMAIL: zack@foglesinc.com

CONTRACTOR ADDRESS: 580 Obrecht Road, Sykesville, MD 21784

PHONE: 410-795-5670

PROPERTY OWNER: Barry Miller

EMAIL: _____

OWNER ADDRESS: 3715 Woodbine Road, Woodbine, MD 21797

PHONE: _____

NUMBER OF BEDROOMS: 3

SEPTIC TANK SIZE: _____

DRAINFIELD SIZE/TYPE: _____

LOCATION:

NOTES:

Install 2 x45' trenches on contour, 3 wide, 3' inlet, 8' bottom depth. Put D box at start of upper trench, port on D box and observation ports at trench ends. Run RO system discharge line from house to D box.

ISSUED BY: Sarah Collins

ISSUE DATE: 10/31/16

EXPIRATION DATE: 10/31/16

NOTE: CONTRACTOR MUST SCHEDULE AN INSPECTION AND GAIN APPROVAL OF ALL COMPONENTS PRIOR TO COVERING


NOTE: AN ELECTRICAL PERMIT IS REQUIRED FOR INSTALLATION OF ANY ELECTRICAL COMPONENTS OF THE SYSTEM

NOTE: MDE RECOMMENDS SEPTIC TANKS, BAT, AND OTHER PRETREATMENT UNITS BE PUMPED AT A FREQUENCY ADEQUATE TO ENSURE THAT SOLIDS ARE NOT DISCHARGED TO THE DISPOSAL AREA

**NEITHER THE HOWARD COUNTY COUNCIL NOR THE HEALTH DEPARTMENT IS RESPONSIBLE
FOR THE SUCCESSFUL OPERATION OF ANY SYSTEM.**

PERMITTEE RESPONSIBLE FOR OBTAINING FINAL APPROVAL ON THIS PERMIT.

CALL 410-313-1771 FOR INSPECTION OF SEPTIC SYSTEM.

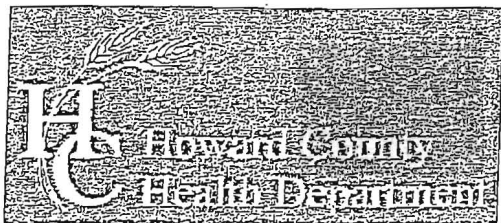

Bureau of Environmental Health

8930 Stanford Boulevard, Columbia, MD 21045

Main: 410-313-2640 | Fax: 410-313-2648

TDD 410-313-2323 | Toll Free 1-866-313-6300

www.hchealth.org

Facebook: www.facebook.com/hocohealth

Twitter: HowardCoHealthDep

Dr. Maura J. Rossman, M.D., Health Officer

FCB 10/31/16

INFORMATION FORM – SEPTIC SYSTEM REPAIR/UPGRADE

Reason for Request:

- ☒ Failing System
- ☐ System relocation for proposed addition
- ☐ System upgrade for proposed addition
- ☐ Inadequate treatment zone
- ☐ Collapsed septic tank
- ☐ Collapsed drywell

Has the septic tank been pumped within the last month?

- ☐ Yes Date pumped: _____
- ☐ No

Was a visual inspection of the septic tank and/or drain fields conducted?

- ☐ Yes Explain observations: _____
- ☐ No

Was a visual inspection of the sewage line conducted?

- ☐ Yes
- ☐ Blockage leading to the tank

☐ Yes Explain: _____

☐ No

Blockage leading to the field

☐ Yes Explain: _____

☐ No

Existing system design

- ☐ Drywell
- ☐ Trench
- ☐ Mound
- ☐ Unknown
- ☐ Other: _____

Is discharge surfacing on the ground?

- ☐ Yes
- ☐ No

☐ No

Additional Comments: _____

*For REPAIRS, are the owners proposing, or do they plan to add in the future, any additions or modifications to the property, i.e. pools, living space additions, garages, etc? This information must be disclosed at the time of this application. The Health Department will not be able to accommodate requests in the field for property modifications unrelated to the repair request. Such requests may require an additional fee, testing, and submittal of a Percolation Certification Plan, if the property does not meet current Code and Regulation.

Septic Contractor: Fogles Septic Clean Inc

Contractor's Phone: 410-795-5670

Contractor's Address: 580 Obrecht Rd.

Sykesville, MD 21784

Property Address: 3715 Woodbine Rd

County file: HL

Subdivision: _____

Lot: _____

Year Built: 1900

Owner's Name: Bina Miller

Owner's Phone: 410-675-0507

Name of previous owners: _____

Existing bedrooms: 3

Proposed bedrooms: _____

Has this request been previously discussed with a Sanitarian? (Name): _____

Public Sewer available/nearby: _____

*A Sanitarian will be in contact within three business days, depending upon the urgency of the situation, to coordinate the scheduling/review of the repair or upgrade.

Prior to scheduling inspections, scaled plans should be submitted to clarify the nature of the addition.

Print out a copy of Real Property Data via Dept. of Taxation website _____

Indexed file found _____

If public sewer may be nearby, verify whether sewer is technically "available" through the Bureau of Engineering.


If sewer is available and the property is within the Metropolitan District, connection to sewer is required. If the owner believes reason for exemption exists, the owner should justify the request in writing.

If soil/site conditions are limited and sewer and/or Metro District status is not conducive to connection, the Sanitarian may recommend pursuit of Emergency Sewer Extension or Emergency Metro District Inclusion. The Owner should contact the Bureau of Utilities for details.

No permit is to be issued nor inspection to be scheduled without prior fee collection at the office unless an emergency situation exists. The contractor is to notify office of the emergency situation as soon as possible.

A/P _____

8" (A)
 dk brown
 sch, slk,
 roots
 3'
 red brown
 sch, slk,
 10% pebbles
 Consistent
 ↓
 12'
 red br sl,
 75% saprolite
 13.5'

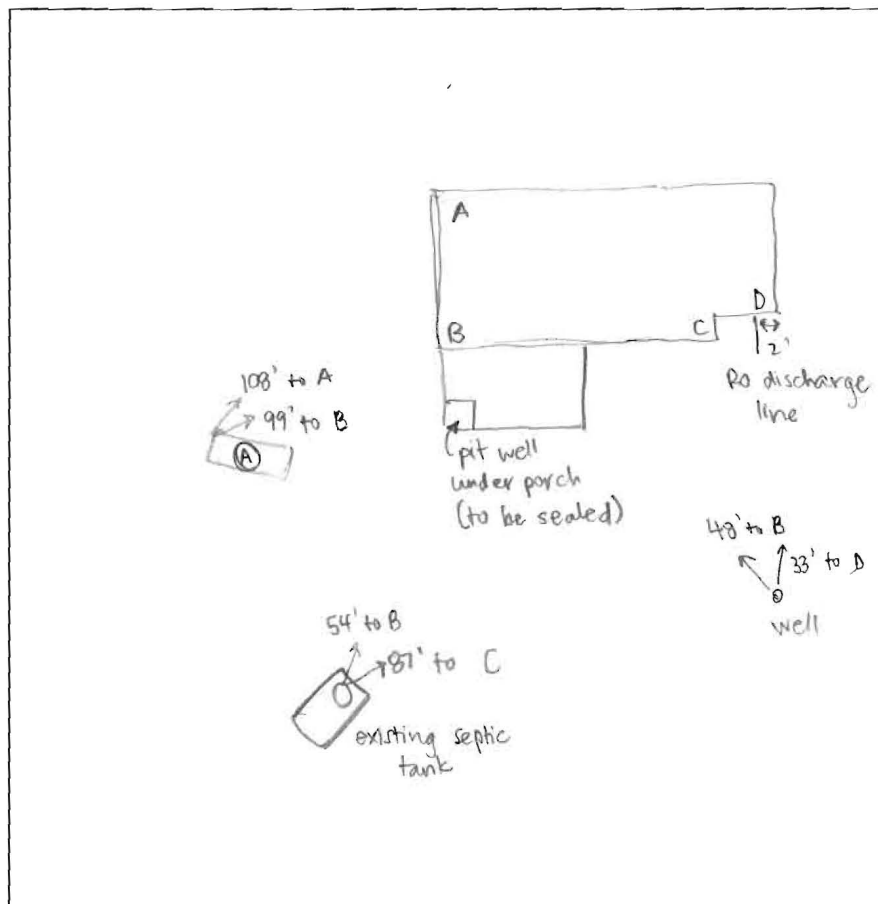

DATE	TEST #	DEPTH	START	BREAK 1" DROP	STOP 2" DROP	TIME OF 2ND INCH	P/F/H
5/31/16	A	4'/13.5'	11:03	11:13	11:31	18	P

REMARKS _____

SANITARIAN Sarah Collins BACKHOE Mike OTHERS Tom Seal + helper
 TEST HOLES USED IN SDA (A) AVG. PERC TIME 18 SQ. FT/BR 3 BR
 TRENCH WIDTH 3' INLET DEPTH 3' MAX. BOT DEPTH 8' EFFECTIVE SW 5'

SITE INSPECTION SHEET

OWNER: Miller PHONE #: _____


ADDRESS: 3715 Woodbine Rd. CONTRACTOR: _____

WELL TAG #: _____

SUBDIVISION: _____ LOT: _____ COUNTY #: _____

PROPOSAL: Install 2 x 45' trenches for discharge of waste from a whole-house reverse osmosis (RO) treatment system

LOCATION DIAGRAM

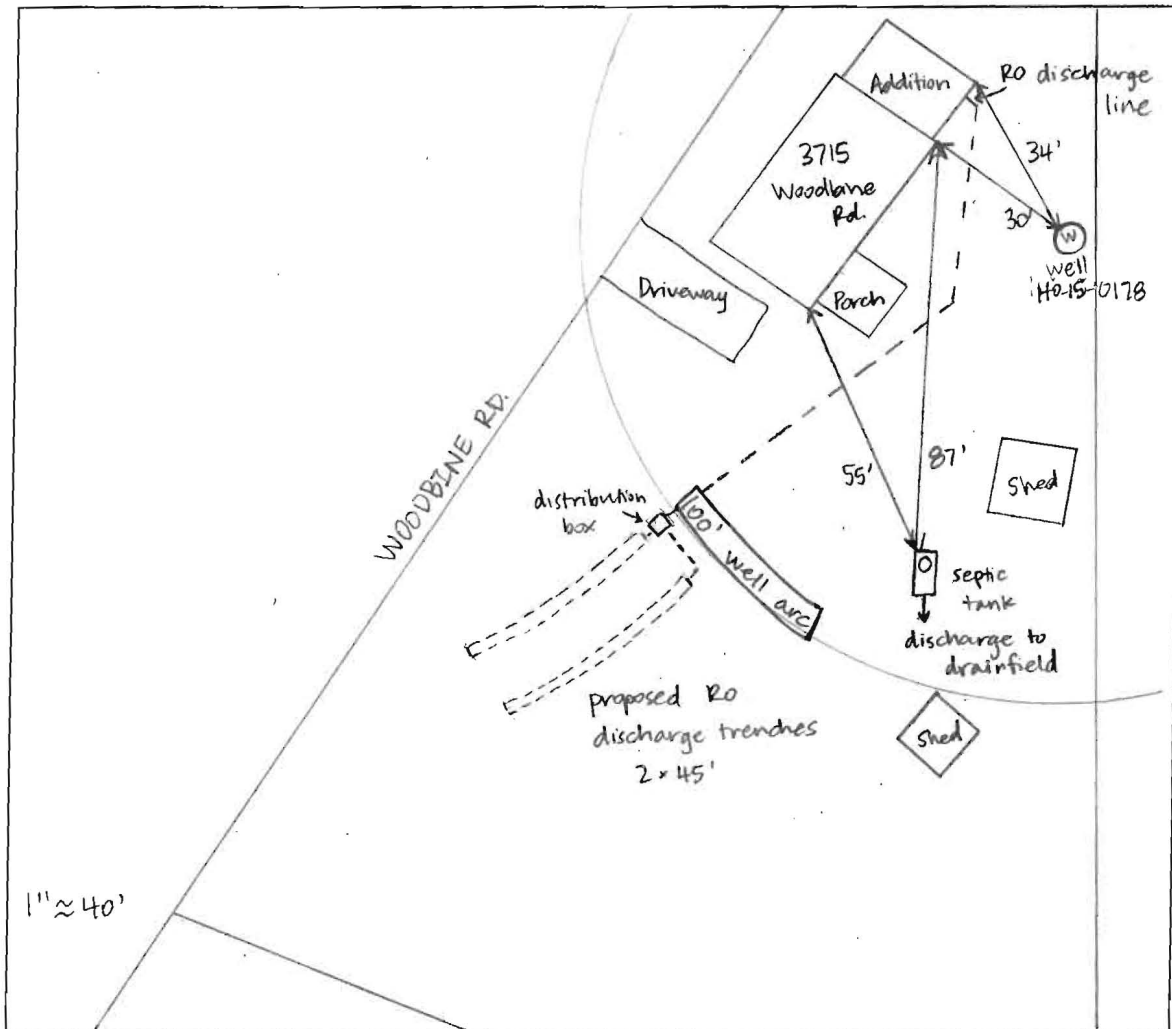

COMMENTS: _____

DATE: 6/21/16 INSPECTOR: Sarah Collins



Howard County
Health Department

Bureau of Environmental Health

8930 Stanford Boulevard, Columbia, MD 21045

Main: 410-313-2640 | Fax: 410-313-2648

TDD 410-313-2323 | Toll Free 1-866-313-6300

www.hchealth.org

Facebook: www.facebook.com/hocohealth

Maura J. Rossman, M.D., Health Officer

RECEIPT DATE: 5/10/16

ONSITE SEWAGE DISPOSAL SYSTEM

P 558711

INSTALLATION

PERMIT

APPROVAL DATE: _____

A _____

MINOR REPAIR

PROPERTY ADDRESS: 3715 Woodbine Road

SUBDIVISION: _____

LOT: _____

TAX ID: 04-319591

CONTRACTOR: Jet Septic

EMAIL: _____

CONTRACTOR ADDRESS: 2516 Marston Road, South New Windsor, MD 21776

PHONE: 410-875-2311

PROPERTY OWNER: Barry Miller

EMAIL: _____

OWNER ADDRESS: 3715 Woodbine Road, Woodbine, MD 21797

PHONE: _____

NUMBER OF BEDROOMS: 3

SEPTIC TANK SIZE: _____

DRAINFIELD SIZE/TYPE: _____

LOCATION: _____

NOTES:

Install 2 x 45' trenches on contours, 3' wide, 3' inlet, 8' bottom depth.
Put D-box at start of upper trench, port on D-box and observation ports
at trench ends. Run RO system discharge line from house to D-box

ISSUED BY: _____

Sarah Collins

ISSUE DATE: _____

5/31/16

EXPIRATION DATE: _____

5/31/17

NOTE: CONTRACTOR MUST SCHEDULE AN INSPECTION AND GAIN APPROVAL OF ALL COMPONENTS PRIOR TO COVERING

NOTE: AN ELECTRICAL PERMIT IS REQUIRED FOR INSTALLATION OF ANY ELECTRICAL COMPONENTS OF THE SYSTEM

NOTE: MDE RECOMMENDS SEPTIC TANKS, BAT, AND OTHER PRETREATMENT UNITS BE PUMPED AT A FREQUENCY ADEQUATE TO ENSURE THAT SOLIDS ARE NOT DISCHARGED TO THE DISPOSAL AREA

**NEITHER THE HOWARD COUNTY COUNCIL NOR THE HEALTH DEPARTMENT IS RESPONSIBLE
FOR THE SUCCESSFUL OPERATION OF ANY SYSTEM.**

PERMITTEE RESPONSIBLE FOR OBTAINING FINAL APPROVAL ON THIS PERMIT.

CALL 410-313-1771 FOR INSPECTION OF SEPTIC SYSTEM.

NOT TO SCALE

1" ≈ 40'

Driveway

Woodbine Rd.

ROAD NAME

H0-15-078

TRENCH/DRAINFIELD DATA

WIDTH INLET BOTTOM

NUMBER OF TRENCHES

TOTAL LENGTH

ABSORPTION AREA

DISTRIBUTION BOX LEVEL

DISTRIBUTION BOX BAFFLE

DISTRIBUTION BOX PORT

SEPTIC TANK DATA

SEPTIC TANK 1 LEVEL

MANUFACTURER

CAPACITY GAL

SEAM LOC

TANK LID DEPTH

BAFFLES

BAFFLE FILTER

MANHOLE LOC

6" PORT LOC

WATERTIGHT TEST

SLOTTED

DATE ON LID

PUMP/SEPTIC TANK LEVEL

MANUFACTURER

CAPACITY GAL

SEAM LOC

TANK LID DEPTH

BAFFLES

BAFFLE FILTER

MANHOLE LOC

6" PORT LOC

WATERTIGHT TEST

SLOTTED

DATE ON LID

PRE-CONSTRUCTION:

5/31/16 Found R0 discharge pipe at house addition. Shot contour in area of prospective new trench(es) and laid out 1x50' trench, left room above in case more trench length needed. Perc hole dug below 50' trench on contour. Perc = 0.6 application rate → install 2x45' trenches on contour outside 100' well arc. Put D-box at start of T1. (Sc)

INSTALLATION:

FINAL INSPECTOR DATE OF APPROVAL



Bureau of Environmental Health

8930 Stanford Boulevard, Columbia, MD 21045

Main: 410-313-2640 | Fax: 410-313-2648

TDD 410-313-2323 | Toll Free 1-866-313-6300

www.hchealth.org

Facebook: www.facebook.com/hocohealth

Twitter: HowardCoHealthDep

Maura J. Rossman, M.D., Health Officer

APPLICATION

FOR PERCOLATION TESTING AND SITE EVALUATION

PROPERTY LOCATION

SUBDIVISION/PROPERTY NAME _____

PROPERTY ADDRESS

3715 Woodbine Rd Woodbine Md 21787
STREET TOWN ZIP

TAX ACCOUNT # _____

TAX MAP _____

GRID _____

PARCEL _____

LOT NO. _____

PROPOSED LOT
SIZE (ACRES) _____

ZONING CATEGORY _____

TIER _____

PROPERTY OWNER(S)

Barry Miller

DAYTIME PHONE _____

CELL 443 677 5521 EMAIL _____

MAILING ADDRESS

3715 Woodbine Rd Woodbine Md 21787
STREET CITY, STATE ZIP

APPLICANT

Tom Seal / Jet Septic Inc.

RELATIONSHIP TO OWNER: _____

DAYTIME PHONE 410 875-2311

CELL 410 259 6905 EMAIL _____

MAILING ADDRESS

2516 Mayston Rd South New Windsor Md 21776
STREET CITY, STATE ZIP

I HEREBY APPLY FOR THE NECESSARY TESTING/EVALUATION PRIOR TO ISSUANCE OF SEWAGE DISPOSAL SYSTEM PERMIT(S):

PROPERTY:

☐ SUBDIVISION: NUMBER OF LOTS INCLUDING RESIDUE: _____

SUBDIVISION CLASSIFICATION (PER DEPT. OF PLANNING AND ZONING)

☐ MAJOR

☐ MINOR

☐ CONSTRUCT NEW OSDS ON UNDEVELOPED LOT

☐ REPAIR OR REPLACE FAILING OSDS

☐ UPGRADE EXISTING OSDS

perk by pit - Reverse Osmosis System.

BUILDING:

☒ RESIDENTIAL WITH 3 EXISTING OR PROPOSED BEDROOMS IN THE COMPLETED STRUCTURE

☐ COMMERCIAL (PROVIDE DETAIL OF TYPE OF USE AND NUMBERS OF EMPLOYEES/CUSTOMERS ON ACCOMPANYING PLAN)

IS THE PROPERTY WITHIN 2500 FEET OF ANY RESERVOIR?

☐ YES

☒ NO

AS APPLICANT, I UNDERSTAND THE FOLLOWING:

- THIS APPLICATION IS VALID FOR TWO(2) YEARS FROM DATE OF FEE PAYMENT AND APPROVAL IS BASED UPON HEALTH OFFICER SIGNATURE OF A PERC CERTIFICATION PLAN PRIOR TO EXPIRATION OF THIS PERMIT.
- THE APPLICATION FEE IS NON-REFUNDABLE
- THIS APPLICATION MUST BE ACCOMPANIED BY ALL APPLICABLE FEES AND A SUITABLE SITE PLAN IN ORDER TO BE PROCESSED
- THIS IS A PUBLIC DOCUMENT


I declare and affirm that to the best of my knowledge, the information contained herein is correct. I declare that I am the owner of the property or duly authorized to make this application on behalf of the owner. I agree to comply with all applicable state and county regulations.

By signature of this application, I hereby grant Howard County Health Department officials the right to enter onto the property for the purpose of inspecting the property as directly related to the requested permit/service.

5-11-16

SIGNATURE OF APPLICANT

DATE

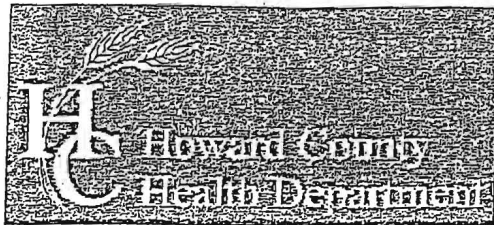

Bureau of Environmental Health

8930 Stanford Boulevard, Columbia, MD 21045

Main: 410-313-2640 | Fax: 410-313-2648

TDD 410-313-2323 | Toll Free 1-866-313-6300

www.hchealth.org

Facebook: www.facebook.com/hocohealth

Twitter: HowardCoHealthDep

Dr. Maura J. Rossman, M.D., Health Officer

INFORMATION FORM - SEPTIC SYSTEM REPAIR/UPGRADE

Reason for Request: 1 pump Test

- ☐ Failing System
- ☐ System relocation for proposed addition
- ☐ System upgrade for proposed addition
- ☐ Inadequate treatment zone
- ☐ Collapsed septic tank
- ☐ Collapsed drywell

Has the septic tank been pumped within the last month?

- ☒ Yes Date pumped: _____
- ☒ No

Was a visual inspection of the septic tank and/or drain fields conducted?

- ☒ Yes Explain observations: _____
- ☐ No

Existing system design

- ☐ Drywell
- ☐ Trench
- ☐ Mound
- ☐ Unknown whole House
- ☒ Other: REVERSE OSMOSIS System

Was a visual inspection of the sewage line conducted?

- ☒ Yes
 - ☐ No
- Blockage leading to the tank
- ☐ Yes. Explain: _____
 - ☒ No

Blockage leading to the field

- ☐ Yes Explain: _____
- ☒ No

Is discharge surfacing on the ground?

- ☐ Yes
- ☒ No

Additional Comments: _____

*For REPAIRS, are the owners proposing, or do they plan to add in the future, any additions or modifications to the property, i.e. pools, living space additions, garages, etc? This information must be disclosed at the time of this application. The Health Department will not be able to accommodate requests in the field for property modifications unrelated to the repair request. Such requests may require an additional fee, testing, and submittal of a Percolation Certification Plan, if the property does not meet current Code and Regulation.

Septic Contractor: Jet Septic Inc Contractor's Phone: 410 875 2311

Contractor's Address: 2516 Marston Rd South New Windsor Md 21776

Property Address: 3715 Woodbine Rd Woodbine Md County file: Howard Co.

Subdivision: _____ Lot: _____ Year Built: _____

Owner's Name: Barry Miller Owner's Phone: 443 677 5521

Name of previous owners: _____ Existing bedrooms: 3

Proposed bedrooms: _____

Has this request been previously discussed with a Sanitarian? (Name): Yes

Public Sewer available/nearby: No

*A Sanitarian will be in contact within three business days, depending upon the urgency of the situation, to coordinate the scheduling/review of the repair or upgrade.

Prior to scheduling inspections, scaled plans should be submitted to clarify the nature of the addition.


Print out a copy of Real Property Data via Dept. of Taxation website _____ Indexed file found _____

If public sewer may be nearby, verify whether sewer is technically "available" through the Bureau of Engineering.

If sewer is available and the property is within the Metropolitan District, connection to sewer is required: If the owner believes reason for exemption exists, the owner should justify the request in writing.

If soil/site conditions are limited and sewer and/or Metro District status is not conducive to connection, the Sanitarian may recommend pursuit of Emergency Sewer Extension or Emergency Metro District Inclusion. The Owner should contact the Bureau of Utilities for details.

No permit is to be issued nor inspection to be scheduled without prior fee collection at the office unless an emergency situation exists. The contractor is to notify office of the emergency situation as soon as possible.

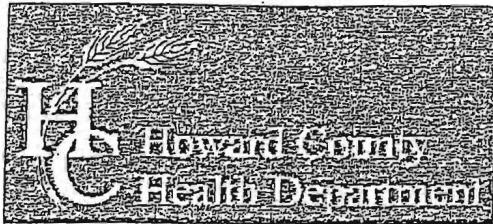

Bureau of Environmental Health

8930 Stanford Boulevard, Columbia, MD 21045

Main: 410-313-2640 | Fax: 410-313-2648

TDD 410-313-2323 | Toll Free 1-866-313-6300

www.hchealth.org

Facebook: www.facebook.com/hocohealth

Twitter: HowardCoHealthDep

Dr. Maura J. Rossman, M.D., Health Officer

INFORMATION FORM – SEPTIC SYSTEM REPAIR/UPGRADE

Reason for Request:

- ☐ Failing System
- ☐ System relocation for proposed addition
- ☐ System upgrade for proposed addition
- ☐ Inadequate treatment zone
- ☐ Collapsed septic tank
- ☐ Collapsed drywell

Has the septic tank been pumped within the last month?

- ☐ Yes Date pumped: _____
- ☒ No

Was a visual inspection of the septic tank and/or drain fields conducted?

- ☐ Yes Explain observations: _____
- ☒ No

Was a visual inspection of the sewage line conducted?

- ☐ Yes
 - ☒ No
- Blockage leading to the tank
- ☐ Yes. Explain: _____
 - ☒ No

Blockage leading to the field

- ☐ Yes. Explain: _____
- ☒ No

Existing system design

- ☐ Drywell
- ☐ Trench
- ☐ Mound
- ☐ Unknown
- ☐ Other: _____

Is discharge surfacing on the ground?

- ☐ Yes
- ☒ No

☐ No

Additional Comments: Replace septic line from house to existing tank

*For REPAIRS, are the owners proposing, or do they plan to add in the future, any additions or modifications to the property, i.e. pools, living space additions, garages, etc? This information must be disclosed at the time of this application. The Health Department will not be able to accommodate requests in the field for property modifications unrelated to the repair request. Such requests may require an additional fee, testing, and submittal of a Percolation Certification Plan, if the property does not meet current Code and Regulation.

Septic Contractor: Michael Bunk Plumbing Contractor's Phone: 410-781-6791
Contractor's Address: P.O. Box 1453 Sykesville, MD 21284

Property Address: 3715 Woodbine Rd. County file: _____

Subdivision: _____ Lot: _____ Year Built: _____

Owner's Name: Barry Miller Owner's Phone: 410-675-0507

Name of previous owners: _____ Existing bedrooms: _____
Proposed bedrooms: _____

Has this request been previously discussed with a Sanitarian? (Name): No
Public Sewer available/nearby: No

*A Sanitarian will be in contact within three business days, depending upon the urgency of the situation, to coordinate the scheduling/review of the repair or upgrade.

Prior to scheduling inspections, scaled plans should be submitted to clarify the nature of the addition.

Print out a copy of Real Property Data via Dept. of Taxation website _____ Indexed file found _____

If public sewer may be nearby, verify whether sewer is technically "available" through the Bureau of Engineering.

If sewer is available and the property is within the Metropolitan District, connection to sewer is required. If the owner believes reason for exemption exists, the owner should justify the request in writing.

If soil/site conditions are limited and sewer and/or Metro District status is not conducive to connection, the Sanitarian may recommend pursuit of Emergency Sewer Extension or Emergency Metro District Inclusion. The Owner should contact the Bureau of Utilities for details.

No permit is to be issued nor inspection to be scheduled without prior fee collection at the office unless an emergency situation exists. The contractor is to notify office of the emergency situation as soon as possible.



Howard County
Health Department

Bureau of Environmental Health

8930 Stanford Boulevard, Columbia, MD 21045

Main: 410-313-2640 | Fax: 410-313-2648

TDD 410-313-2323 | Toll Free 1-866-313-6300

www.hchealth.org

Facebook: www.facebook.com/hocohealth

Maura J. Rossman, M.D., Health Officer

RECEIPT DATE: 4/21/16

ONSITE SEWAGE DISPOSAL SYSTEM

P 558089

INSTALLATION

APPROVAL DATE: 4/26/16 SEC

PERMIT

MINOR REPAIR

A _____

PROPERTY ADDRESS: 3115
3175 Woodbine Road

SUBDIVISION: _____ LOT: _____ TAX ID: 04-329627

CONTRACTOR: Michael Runk Plumbing EMAIL: _____

CONTRACTOR ADDRESS: P.O. Box 1453, Sykesville, MD 21784 PHONE: 410-781-6791

PROPERTY OWNER: Barry Miller EMAIL: _____

OWNER ADDRESS: 3175 Woodbine Road, Woodbine, MD 21797 PHONE: _____

NUMBER OF BEDROOMS: _____ SEPTIC TANK SIZE: _____ DRAINFIELD SIZE/TYPE: _____

LOCATION:	
NOTES:	Tie in from new house connection at addition to existing septic tank. New sewer house connection for whole house at addition.

ISSUED BY: Sarah Collins ISSUE DATE: 4/26/16 EXPIRATION DATE: 4/26/17

NOTE: CONTRACTOR MUST SCHEDULE AN INSPECTION AND GAIN APPROVAL OF ALL COMPONENTS PRIOR TO COVERING

NOTE: AN ELECTRICAL PERMIT IS REQUIRED FOR INSTALLATION OF ANY ELECTRICAL COMPONENTS OF THE SYSTEM

NOTE: MDE RECOMMENDS SEPTIC TANKS, BAT, AND OTHER PRETREATMENT UNITS BE PUMPED AT A FREQUENCY ADEQUATE TO ENSURE THAT SOLIDS ARE NOT DISCHARGED TO THE DISPOSAL AREA


**NEITHER THE HOWARD COUNTY COUNCIL NOR THE HEALTH DEPARTMENT IS RESPONSIBLE
FOR THE SUCCESSFUL OPERATION OF ANY SYSTEM.**

PERMITTEE RESPONSIBLE FOR OBTAINING FINAL APPROVAL ON THIS PERMIT.

CALL 410-313-1771 FOR INSPECTION OF SEPTIC SYSTEM.

1" x 30'

NOT TO SCALE

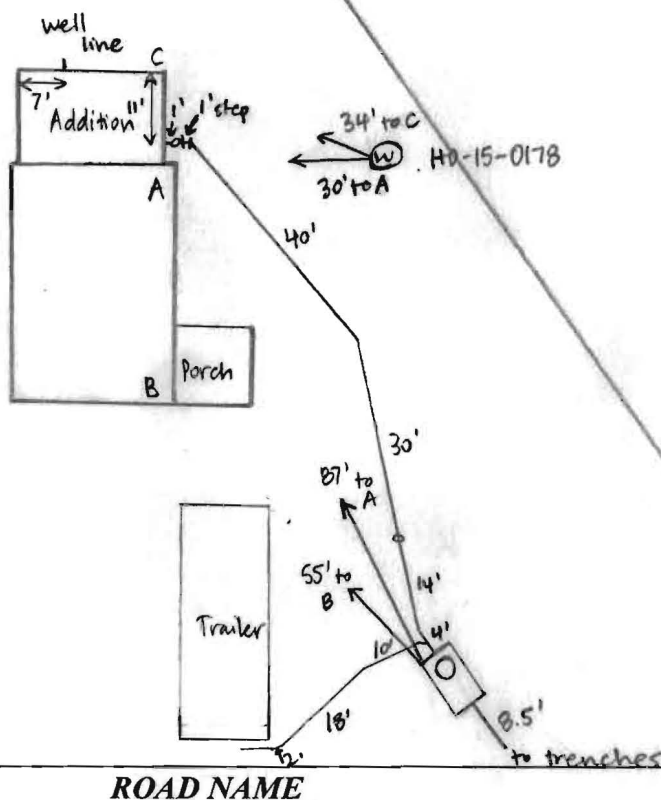**TRENCH/DRAINFIELD DATA**

WIDTH INLET BOTTOM

NUMBER OF TRENCHES

TOTAL LENGTH

ABSORPTION AREA

DISTRIBUTION BOX LEVEL

DISTRIBUTION BOX BAFFLE

DISTRIBUTION BOX PORT

SEPTIC TANK DATA

SEPTIC TANK 1 LEVEL

MANUFACTURER Mayer Bros?CAPACITY 1000/1250? GALSEAM LOC MidTANK LID DEPTH 2'BAFFLES FRONT + REARBAFFLE FILTER NOMANHOLE LOC FRONT6" PORT LOC NONEWATERTIGHT TEST NOSLOTTED NODATE ON LID -~~PUMP/SEPTIC TANK LEVEL~~~~MANUFACTURER~~~~CAPACITY~~ GAL~~SEAM LOC~~~~TANK LID DEPTH~~~~BAFFLES~~~~BAFFLE FILTER~~~~MANHOLE LOC~~~~6" PORT LOC~~~~WATERTIGHT TEST~~~~SLOTTED~~~~DATE ON LID~~

PRE-CONSTRUCTION:

INSTALLATION: 4/26/16 House connection complete. Replaced front manhole cover and rear baffle (broken). Originally orangenburg pipe in sewer house connection. Trailer temporarily tied in to septic - homeowners living in trailer while house is remodeled after fire damage. (59)

FINAL INSPECTOR Sarah Collins DATE OF APPROVAL 4/26/16