

MARYLAND DEPARTMENT OF THE ENVIRONMENT, WATER MANAGEMENT ADMINISTRATION
1800 Washington Blvd., Baltimore, Maryland 21230 (410) 537-3784

WATER WELL ABANDONMENT-SEALING REPORT FORM

SUBMIT COPIES OF COMPLETED FORM TO:

- * COUNTY ENVIRONMENT AGENCY (contact MDE, WMA if address needed)
- * WELL OWNER
- * MDE, WATER MANAGEMENT ADMINISTRATION, WELL PROGRAM

DATE WELL ABANDONED: 12/23/09 (month/day/year)

* PERMIT NUMBER OF ABANDONED WELL (if any) _____

* PERMIT NUMBER OF REPLACEMENT WELL _____

* PERSON ABANDONING WELL: Allen Compton

WELL DRILLERS LICENSE NUMBER: 009
CIRCLE: MWD/MSD/MGD

* OWNER'S NAME: Gary R. Robbins

* WELL LOCATION:

COUNTY: Howard

NEAREST TOWN: Ellicott City


TAX MAP 17 BLOCK 16 PARCEL 71

SUBDIVISION: _____

SECTION: _____ LOT: _____

NEAREST ROAD: 2774 St. Johns Lane

SITE LOCATION MAP

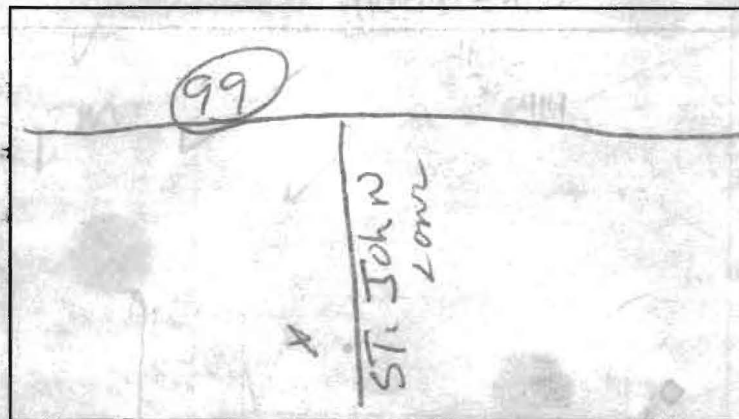

* TYPE OF WELL BEING ABANDONED:

☒ DRILLED ☐ JETTED
☐ BORED/AUGERED ☐ HAND DUG
☐ OTHER (specify) _____

* USE CODE:

☒ DOMESTIC ☐ MUNICIPAL/PUBLIC
☐ IRRIGATION ☐ INDUSTRIAL
☐ TEST/OBSERVATION ☐ GEOTHERMAL

* TYPE OF CASING:

☒ STEEL ☐ PLASTIC
☐ CONCRETE ☐ OTHER (specify) _____

* SIZE OF CASING: 6 INCHES IN DIAMETER

* DEPTH OF WELL: 60 FEET DEEP

* WAS ANY CASING REMOVED? ☐ YES ☒ NO
if yes, length removed, in feet: _____

* WAS CASING RIPPED OR PERFORATED? ☐ YES ☒ NO

LOG OF SEALING MATERIAL

MATERIAL	FEET	
	FROM	TO
Cement	10	60
VOLUME OF MATERIAL USED		
24 bags		

SIGNATURE-MASTER WELL DRILLER OR SUPERVISING SANITARIAN Allen Compton

LICENSE # 009

CIRCLE ONE 009

DATE 1-4-10

-76°50'22"



39°17'39"

39°17'39"

-76°50'22"



Disclaimer: Howard County, Maryland assumes no responsibility for the accuracy of this report or the information contained herein or derived therefrom. The user assumes all risks and liabilities whatsoever resulting from or arising out of the use of this information. There are no oral agreements or warranties relating to the use of this report.



By:
Office:
Map Width: 910.00 ft.
Print Date: 8/16/2010
Scale: 1 in. = 100 ft.