



# Building Permit Application

Howard County Maryland  
Department of Inspections, Licenses and Permits  
3430 Court House Drive  
Permits: 410-313-2455  
www.howardcountymd.gov

Date Received: \_\_\_\_\_

Permit No.: B17000501

Building Address: 11321 Willow Ridge Ln.  
City: Ellicott City State: md Zip Code: 21043  
Suite/Apt. # \_\_\_\_\_ SDP/WP/BA #: \_\_\_\_\_  
Census Tract: \_\_\_\_\_ Subdivision: \_\_\_\_\_  
Section: \_\_\_\_\_ Area: \_\_\_\_\_ Lot: \_\_\_\_\_  
Tax Map: \_\_\_\_\_ Parcel: \_\_\_\_\_ Grid: \_\_\_\_\_  
Zoning: \_\_\_\_\_ Map Coordinates: \_\_\_\_\_ Lot Size: \_\_\_\_\_

Existing Use: Residence  
Proposed Use: Residence

Estimated Construction Cost: \$ 50,000  
Description of Work: SFD Construct 27x16' open deck w/ landing & steps to grade to Rear of Home

Occupant/Tenant Name: \_\_\_\_\_  
Was tenant space previously occupied?  Yes  No  
Contact Name: \_\_\_\_\_  
Address: \_\_\_\_\_  
City: \_\_\_\_\_ State: \_\_\_\_\_ Zip Code: \_\_\_\_\_  
Phone: \_\_\_\_\_ Fax: \_\_\_\_\_  
Email: \_\_\_\_\_

Property Owner's Name: Bala & Vidya Sridhar  
Address: 11321 Willow Ridge Ln.  
City: Ellicott City State: md Zip Code: 21042  
Phone: 410 461-6746 Fax: \_\_\_\_\_  
Email: \_\_\_\_\_

**Applicant's Name & Mailing Address, (If other than stated herein)**  
Applicant's Name: \_\_\_\_\_  
Address: \_\_\_\_\_  
City: \_\_\_\_\_ State: \_\_\_\_\_ Zip Code: \_\_\_\_\_  
Phone: \_\_\_\_\_ Fax: \_\_\_\_\_  
Email: \_\_\_\_\_

Contractor Company: All State Home Imp Co  
Contact Person: Stephen Snyder  
Address: 583 Frederick Rd Ste 6C  
City: Catonville State: md Zip Code: 21028  
License No.: 71268  
Phone: 410 788-0015 Fax: \_\_\_\_\_  
Email: myallstate@comcast.net

Engineer/Architect Company: \_\_\_\_\_  
Responsible Design Prof.: \_\_\_\_\_  
Address: \_\_\_\_\_  
City: \_\_\_\_\_ State: \_\_\_\_\_ Zip Code: \_\_\_\_\_  
Phone: \_\_\_\_\_ Fax: \_\_\_\_\_  
Email: \_\_\_\_\_

| Commercial Building Characteristics                                     | Residential Building Characteristics  |  |
|---|---|--|
| Height:   | <input checked="" type="checkbox"/> SF Dwelling <input type="checkbox"/> SF Townhouse |  |
| No. of stories:   | <b>Depth</b> <b>Width</b>   |  |
| Gross area, sq. ft./floor:  | 1 <sup>st</sup> floor:  |  |
|   | 2 <sup>nd</sup> floor:  |  |
| Area of construction (sq. ft.):   | Basement:   |  |
|   | <input type="checkbox"/> Finished Basement  |  |
| Use group:  | <input type="checkbox"/> Unfinished Basement  |  |
|   | <input type="checkbox"/> Crawl Space  |  |
| <b>Construction type:</b>   | <input type="checkbox"/> Slab on Grade  |  |
| <input type="checkbox"/> Reinforced Concrete                            | No. of Bedrooms:  |  |
| <input type="checkbox"/> Structural Steel                               | <b>Multi-family Dwelling</b>  |  |
| <input type="checkbox"/> Masonry  | No. of efficiency units:  |  |
| <input type="checkbox"/> Wood Frame                                     | No. of 1 BR units:  |  |
| <input type="checkbox"/> State Certified Modular                        | No. of 2 BR units:  |  |
|   | No. of 3 BR units:  |  |
|   | Other Structure:  |  |
|   | Dimensions:   |  |
| <input checked="" type="checkbox"/> <b>Roadside Tree Project Permit</b> | Footings:   |  |
| <input type="checkbox"/> Yes <input checked="" type="checkbox"/> No     | Roof:   |  |
| <b>Roadside Tree Project Permit #</b>                                   | <input type="checkbox"/> State Certified Modular                                      |  |
|   | <input type="checkbox"/> Manufactured Home  |  |

| Utilities   |  |
|---|--|
| Electric:   | <input type="checkbox"/> Yes <input type="checkbox"/> No |
| Gas:  | <input type="checkbox"/> Yes <input type="checkbox"/> No |
| Water Supply  |  |
| <input type="checkbox"/> Public   |  |
| <input type="checkbox"/> Private  |  |
| Sewage Disposal   |  |
| <input type="checkbox"/> Public   |  |
| <input type="checkbox"/> Private  |  |
| Heating System  |  |
| <input type="checkbox"/> Electric <input type="checkbox"/> Oil            |  |
| <input type="checkbox"/> Natural Gas <input type="checkbox"/> Propane Gas |  |
| <input type="checkbox"/> Other:   |  |
| Sprinkler System:   |  |
| <input type="checkbox"/> Yes <input type="checkbox"/> No                  |  |
| Grading Permit Number:  |  |
| Building Shell Permit Number:   |  |

THE UNDERSIGNED HEREBY CERTIFIES AND AGREES AS FOLLOWS: (1) THAT HE/SHE IS AUTHORIZED TO MAKE THIS APPLICATION; (2) THAT THE INFORMATION IS CORRECT; (3) THAT HE/SHE WILL COMPLY WITH ALL REGULATIONS OF HOWARD COUNTY WHICH ARE APPLICABLE THERETO; (4) THAT HE/SHE WILL PERFORM NO WORK ON THE ABOVE REFERENCED PROPERTY NOT SPECIFICALLY DESCRIBED IN THIS APPLICATION; (5) THAT HE/SHE GRANTS COUNTY OFFICIALS THE RIGHT TO ENTER ONTO THIS PROPERTY FOR THE PURPOSE OF INSPECTING THE WORK PERMITTED AND POSTING NOTICES.

Applicant's Signature: [Signature]  
Email Address: myallstate@comcast.net  
Title/Company: President / All State Home Imp Co

Print Name: Stephen Snyder  
Date: 2-10-17

Checks Payable to: DIRECTOR OF FINANCE OF HOWARD COUNTY

\*\*PLEASE WRITE NEATLY & LEGIBLY\*\*

-FOR OFFICE USE ONLY-


| AGENCY               | DATE             | SIGNATURE OF APPROVAL |
|----------------------|------------------|-----------------------|
| State Highways       |                  |                       |
| Building Officials   |                  |                       |
| PSZA ( Zoning )      |                  |                       |
| PSZA ( Engineering ) |                  |                       |
| Health               | <u>2/10/2017</u> | <u>R. Bricker</u>     |

Is Sediment Control approval required for issuance?  Yes  No  
 CONTINGENCY CONSTRUCTION START

| DPZ SETBACK INFORMATION   |
|---|
| Front:  |
| Rear:   |
| Side:   |
| Side St.:   |
| All minimum setbacks met? <input type="checkbox"/> Yes <input type="checkbox"/> No    |
| Is Entrance Permit Required? <input type="checkbox"/> Yes <input type="checkbox"/> No |
| Historic District? <input type="checkbox"/> Yes <input type="checkbox"/> No           |
| Lot Coverage for New Town Zone:   |
| SDP/Red-line approval date:   |

|                 |    |
|-----------------|----|
| Filing Fee      | \$ |
| Permit Fee      | \$ |
| Tech Fee        | \$ |
| Excise Tax      | \$ |
| PSFS            | \$ |
| Guaranty Fund   | \$ |
| Add'l per Fee   | \$ |
| Total Fees      | \$ |
| Sub- Total Paid | \$ |
| Balance Due     | \$ |
| Check           | #  |

Distribution of Copies: White: Building Officials Green: PSZA,Zoning Yellow: PSZA,Engineering Pink: Health Gold: SHA

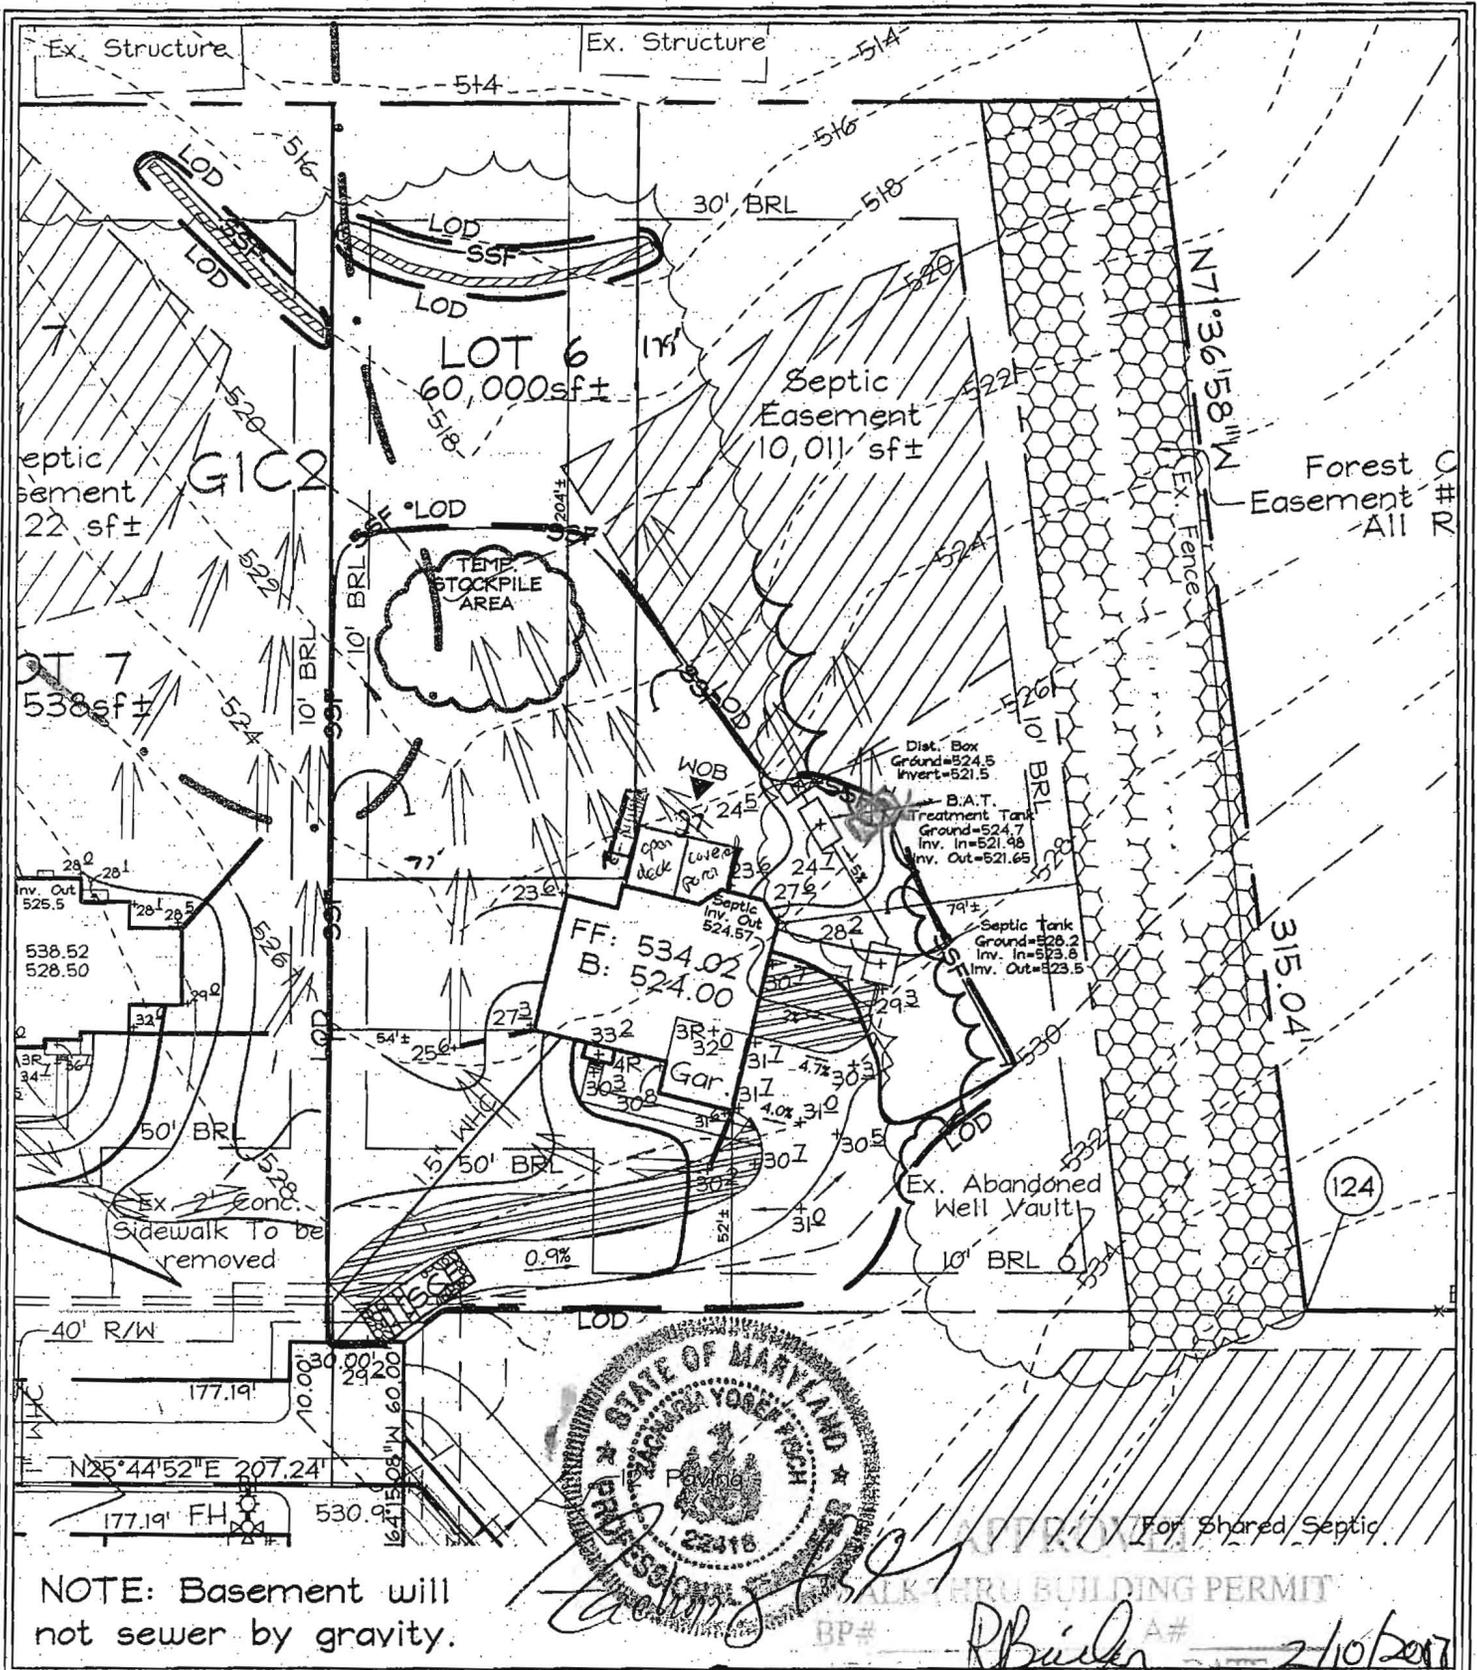

NOTE: Basement will not sewer by gravity.

For Shared/Septic  
 WALK THRU BUILDING PERMIT  
 BP# \_\_\_\_\_ RBuiler A# \_\_\_\_\_ 2/10/2017

DESIGN BY: CRH2  
 DRAWN BY: CRH2  
 CHECKED BY: ZYF  
 SCALE: 1" = 50'  
 DATE: June 6, 2013  
 W.O. No.: 3033  
 SHEET No. 1 OF 1

11321 Willow Ridge Ln.  
 OK [Signature]  
**FSH Associates**  
 Engineers Planners Surveyors  
 6339 Howard Lane Elkridge, MD 21075  
 Tel: 410-567-5200 Fax: 410-796-1562  
 E-mail: info@fshen.com

RESITE #2 27' x 16' Deck w/Steps To grade  
**WILLOW RIDGE**  
 LOT 6  
 GP-13-065 & Plat #22030-22033  
 TAX MAP 16, GRID 15 PARCELS 89, 91 & 201  
 3RD ELECTION DISTRICT HOWARD CO., MD