

**COMPLETE THIS FORM WHEN DROPPING OFF ANY
CORRESPONDENCE AND/OR PLANS TO THE HOWARD COUNTY
DEPARTMENT OF INSPECTIONS, LICENSES AND PERMITS COUNTER:**

Date: 3-8-17

To: Annette Merison Sack
(Person's Name and Division)

From: David Mathias INEX Const LLC (410) 371-1261
(Your Name, Company Name and Telephone Number)

Subject: Project name Queen / Homeowner

Project site address 904 Watersville Rd

Permit # B17000815 SDP # _____

Other information pertinent to this project _____

RECEIVED

MAR 13 2017

PLAN REVIEW DIVISION

Please check the attachments below that you are submitting with this transmittal:

- Letter of response to address plan review comment letter
- Revised plans and/or revised details: When submitting for a complete re-review, duplicate sets shall be submitted.

Letter Summarizing Changes

Size decreased but may need to go to Health Dept calculations (be specific).

for review

Health Department Request DPZ/ DED Request _____ Applicant's Request _____

family dwelling model plans to be placed on permanent file: Model name and/or # _____

Contact Person Information: (Required)

DAVID MATHIAS
Please Print Name

Telephone No: 410-371-1261

E-Mail Address: inexconstruction@comcast.net

PLEASE ASSURE ALL DOCUMENTS AND/OR REVISIONS ARE APPROPRIATELY SIGNED AND SEALED, IF NECESSARY, BY A LICENSED ARCHITECT OR ENGINEER. PLEASE BE ADVISED THAT INSUFFICIENT INFORMATION MAY RESULT IN THE DELAY OF REVIEW BY THE PLANS EXAMINER. THE DEPARTMENT OF INSPECTIONS, LICENSES AND PERMITS WILL CONTACT YOU IF THERE IS A PROBLEM. IN ADDITION, ONCE THE BUILDING PERMIT IS APPROVED BY THE PLAN REVIEW DIVISION AND ALL OTHER REQUIRED SIGNATORY AGENCIES, AND THE BUILDING PERMIT IS READY FOR ISSUANCE, THE PERMIT DIVISION WILL NOTIFY THE APPROPRIATE CONTACT PERSON FOR PERMIT PICK UP. ALL PERMIT STATUS INQUIRIES SHALL BE DIRECTED TO THE PERMIT DIVISION AT 410-313-2455. CODE RELATED QUESTIONS AND PLAN REVIEW INQUIRIES SHALL BE DIRECTED TO THE PLAN REVIEW DIVISION AT 410-313-2436. PLEASE ALLOW A MINIMUM OF FIVE (5) WORKING DAYS FOR ANY PLAN SUBMITTALS TO BE REVIEWED. THANK YOU.

Received by [Signature]


Revision #2

cc: Bidd
DET
Health

REVISED

Date: 3-8-17



Comments: Decrease Barn size to 30 x 36
LOT-3

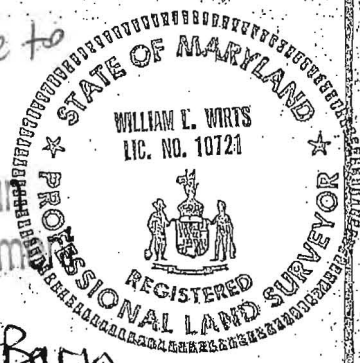

STOOD UNDER DECK 4.0 x 4.0
revised Septic System Plan
Howard County Health Department

Revision
as 30' x 36' Pole Barn
approved
Signature: R. Wirts
Date: 3/17/2017

APPROVED
WALK-THRU BUILDING PERMIT
BP# B17000815 IA#
APP. SAN R. Wirts DATE: 2/15/2017
DESC. OF WORK: 30' x 36' Pole Barn
as illustrated

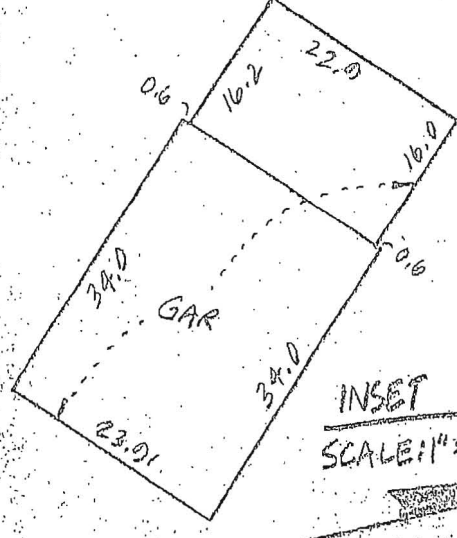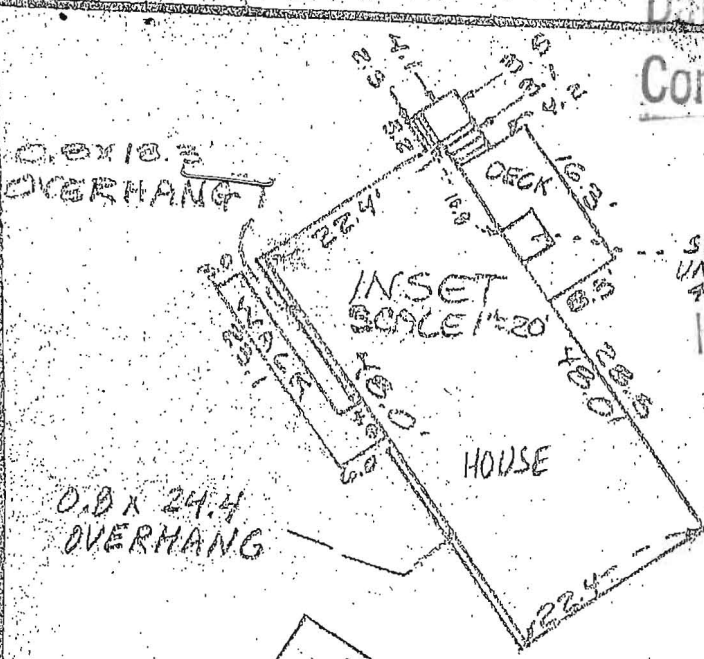


LOT-2

PROPOSED
INSET 30' x 36' BARN
SCALE: 1"=20'

* SDA added per Health Dept. records 2/15/2017 RB

NOTE
106 FEET OF DRIVEWAY BEING USED AS A COMMON DRIVE WITH LOT #2. APPROX 12-15 WIDE

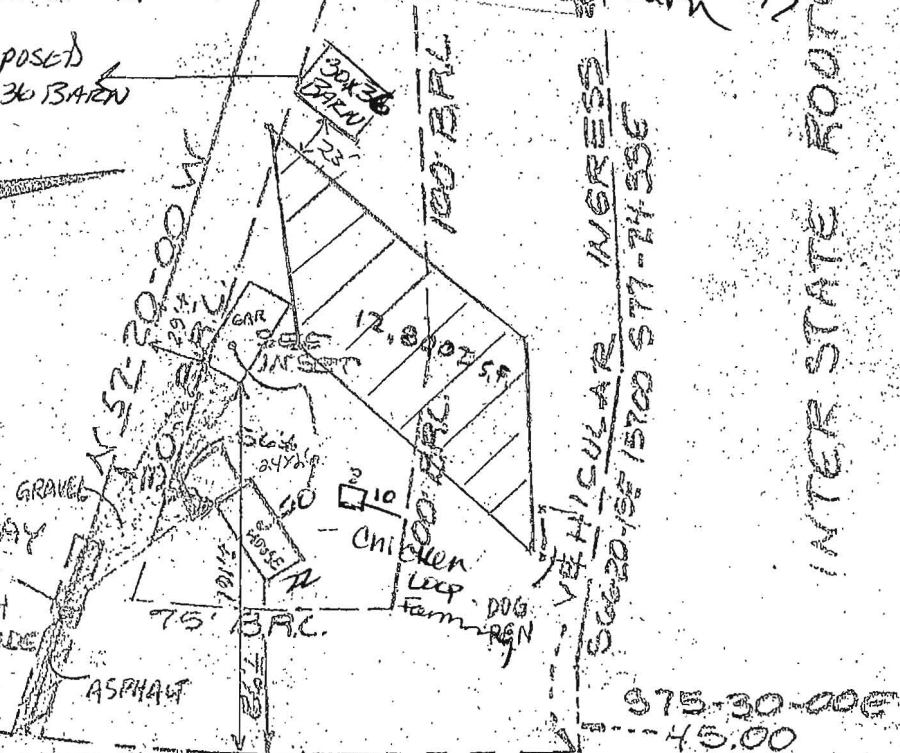

HOUSE LOCATION
LOT 1
POPLAR SPRINGS
4th ELECTION DISTRICT
HOWARD COUNTY, MARYLAND

WATERSVILLE ROAD

INTER STATE ROUTE 70

RECERTIFIED CORRECT
William L. Wirts 6/11/01
WILLIAM L. WIRTS DATE
MD. NO. 10721 - R.P.L.S.

SURVEYOR'S CERTIFICATE

I hereby certify that the position of all existing improvements on the above described property have been carefully established by a transit-tape survey and that unless otherwise shown there are no encroachments. THE HOUSE DOES NOT LIE WITHIN A FLOOD HAZARD AREA

William L. Wirts
WILLIAM L. WIRTS - Registered Land Surveyor - Maryland No. 10721

Tri-County Surveys, Inc.

BOX 55 • DAMASCUS, MARYLAND 20872 (301) 283-3601
LAND PLANNING CONSULTANTS • SUBDIVISIONS • LOT & BOUNDARIES

REFERENCE	Drawn by <u>WNF</u>	Checked by <u>WLV</u>
Plot Book	Date <u>5/20/05</u>	Record No. <u>REC. Bk 75</u>
Plot No. <u>4849</u>	Scale <u>1"=100'</u>	BK# <u>36</u>

NOTE: This drawing is not intended or represented to be a lot stake out survey; no lot corners were set; and is not to be used, or relied upon, for the establishment of any fence, building or other improvements. The responsibility is extended herein to future purchasers.