



APPLICATION

FOR PERCOLATION TESTING AND SITE EVALUATION

TEST DATE(S) _____ TEST TIME _____

AP 520078-L

AGENCY REVIEW: _____

DATE 3/2/04

DO NOT WRITE ABOVE THIS LINE

I HEREBY APPLY FOR THE NECESSARY TESTING/EVALUATION PRIOR TO ISSUANCE OF SEWAGE DISPOSAL SYSTEM PERMIT(S) TO:

CHECK AS NEEDED:

- CONSTRUCT NEW SEPTIC SYSTEM(S)
- REPAIR/ADD TO AN EXISTING SEPTIC SYSTEM
- REPLACE AN EXISTING SEPTIC SYSTEM

CHECK AS NEEDED:

- NEW STRUCTURE(S)
- ADDITION TO AN EXISTING STRUCTURE
- REPLACE AN EXISTING STRUCTURE

CHECK ONE:

- CREATE NEW LOT(S)
- BUILD ON AN EXISTING LOT IN A SUBDIVISION
- BUILD ON AN EXISTING PARCEL OF RECORD

IS THE PROPERTY WITHIN 2500' OF ANY RESERVOIR?

- YES
- NO

THE TYPE OF STRUCTURE IS:

- RESIDENTIAL WITH UNKNOWN PROPOSED BEDROOMS IN THE COMPLETED STRUCTURE (NOTE UNKNOWN IF APPROPRIATE)
- COMMERCIAL (PROVIDE DETAIL OF NUMBERS AND TYPES OF EMPLOYEES/ CUSTOMERS ON ACCOMPANYING PLAN)
- INSTITUTIONAL/GOVERNMENT (PROVIDE DETAIL OF NUMBERS AND TYPES OF EMPLOYEES/USERS ON ACCOMPANYING PLAN)

PROPERTY OWNER(S) LDG, Inc.

DAYTIME PHONE (301) 585-7000 CELL _____ FAX (301) 585-4604

MAILING ADDRESS Lee Plaza, Suite 200 8601 Georgia Avenue Silver Spring MD 20910-3437
STREET CITY/TOWN STATE ZIP

APPLICANT VanMar Associates, Inc.

DAYTIME PHONE (301) 829-2890 CELL _____ FAX (301) 831-5603

MAILING ADDRESS 310 South Main St. Mt. Airy MD 21771
STREET CITY/TOWN STATE ZIP

APPLICANT'S ROLE: DEVELOPER BUILDER BUYER RELATIVE/FRIEND REALTOR CONSULTANT

PROPERTY LOCATION
SUBDIVISION/PROPERTY NAME Datapsco Overlook LOT NO. 13

PROPERTY ADDRESS Old Frederick Road Lisbon
STREET TOWN/POST OFFICE

TAX MAP PAGE(S) 2 GRID 24 PARCEL(S) 32 PROPOSED LOT SIZE 1.14 Ac ±

AS APPLICANT, I UNDERSTAND THE FOLLOWING: THE SYSTEM INSTALLED SUBSEQUENT TO THIS APPLICATION IS ACCEPTABLE ONLY UNTIL PUBLIC SEWERAGE IS AVAILABLE. THIS APPLICATION IS COMPLETE WHEN ALL APPLICABLE FEES AND A SUITABLE SITE PLAN HAVE BEEN RECEIVED. I ACCEPT THE RESPONSIBILITY FOR COMPLIANCE WITH ALL M.O.S.H.A. AND "MISS UTILITY" REQUIREMENTS. APPROVAL IS BASED UPON SATISFACTORY REVIEW OF A PERC CERTIFICATION PLAN.


TEST RESULTS WILL BE MAILED TO APPLICANT. Melanie Repp
SIGNATURE OF APPLICANT

HOWARD COUNTY HEALTH DEPARTMENT, BUREAU OF ENVIRONMENTAL HEALTH, WELL AND SEPTIC PROGRAM
3525-H ELLICOTT MILLS DRIVE, ELLICOTT CITY, MARYLAND 21043-4544 (410) 313-1771 FAX (410) 313-2648
TDD (410) 313-2323 TOLL FREE 1-877-4MD-DHMH

562
 strong org brn, y brn, CL L - hvy loam 5'
 wk org wk yellow v. fine SL-L
 Trace Rock
 Bottom 13'

563 565
 wk rd sil - compact 4 1/4'
 Light brn wk org Tan loam - SL loam sm saps rock frags ~20% near bottom
 Bottom 13'


561
 strong org, yellow dense sil 3'
 Red Sil ?
 yellow brn wk red v. fine SL-L Rx ~5%
 Bottom 14'

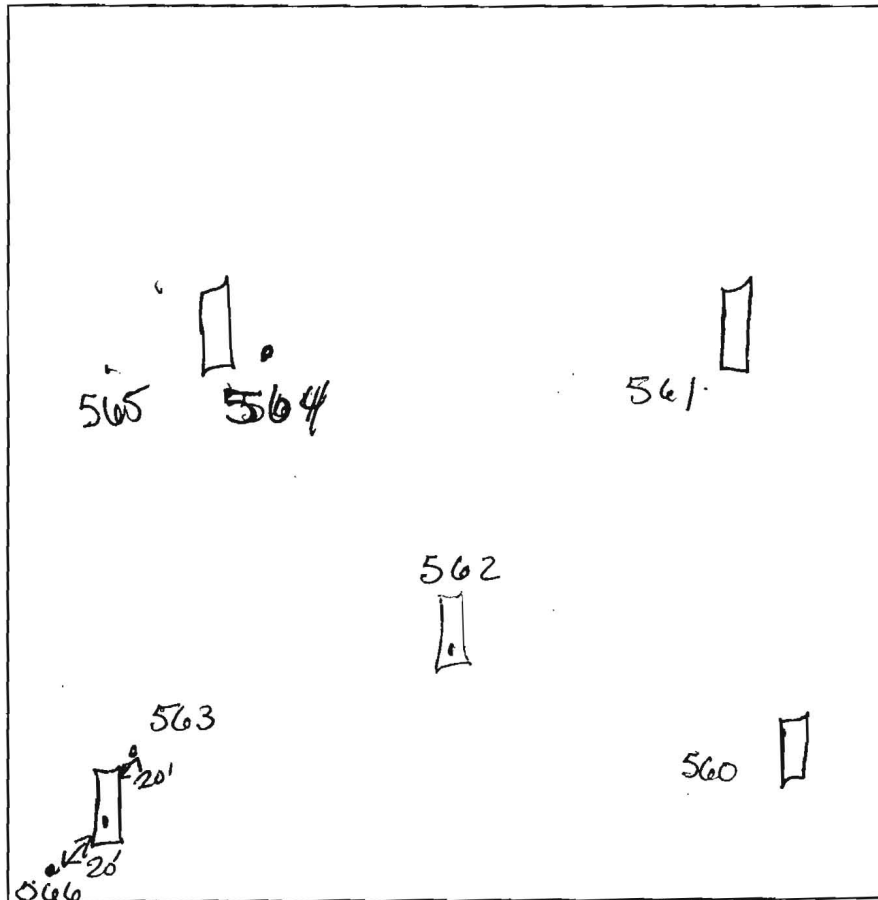

560
 1" Topsoil tan sCLL
 2" str r org wk rd silt-sil Qtz frags 5-10% 5'
 magenta Brn wk red fine SL platy struct. sm saps Rx frags ~20%
 Bottom 13'

DATE	TEST #	DEPTH	START	BREAK 1" DROP	STOP 2" DROP	TIME OF 2ND INCH	P/F/H
6/16/04	562	5'3"	6:05	6:11	6:21	11min	P
	561	4'	5:55	6:05	6:15	10min	P
	560	6'3"	5:46	5:50	6:00	10min	P
	566/568	4 1/2'	6:19	6:22	6:26	4min	P
	565/564	Visual				EST 4min	P

REMARKS: Holes staked & dug per plan; STAKED HOLES: 563/566, 565/564
 SANITARIAN Kacie BACKHOE J. Brendel OTHERS _____
 TEST HOLES USED IN SDA _____ AVG. PERC TIME _____ SQ. FT/BR _____
 TRENCH WIDTH _____ INLET DEPTH _____ MAX. BOT DEPTH _____ EFFECTIVE S/W _____

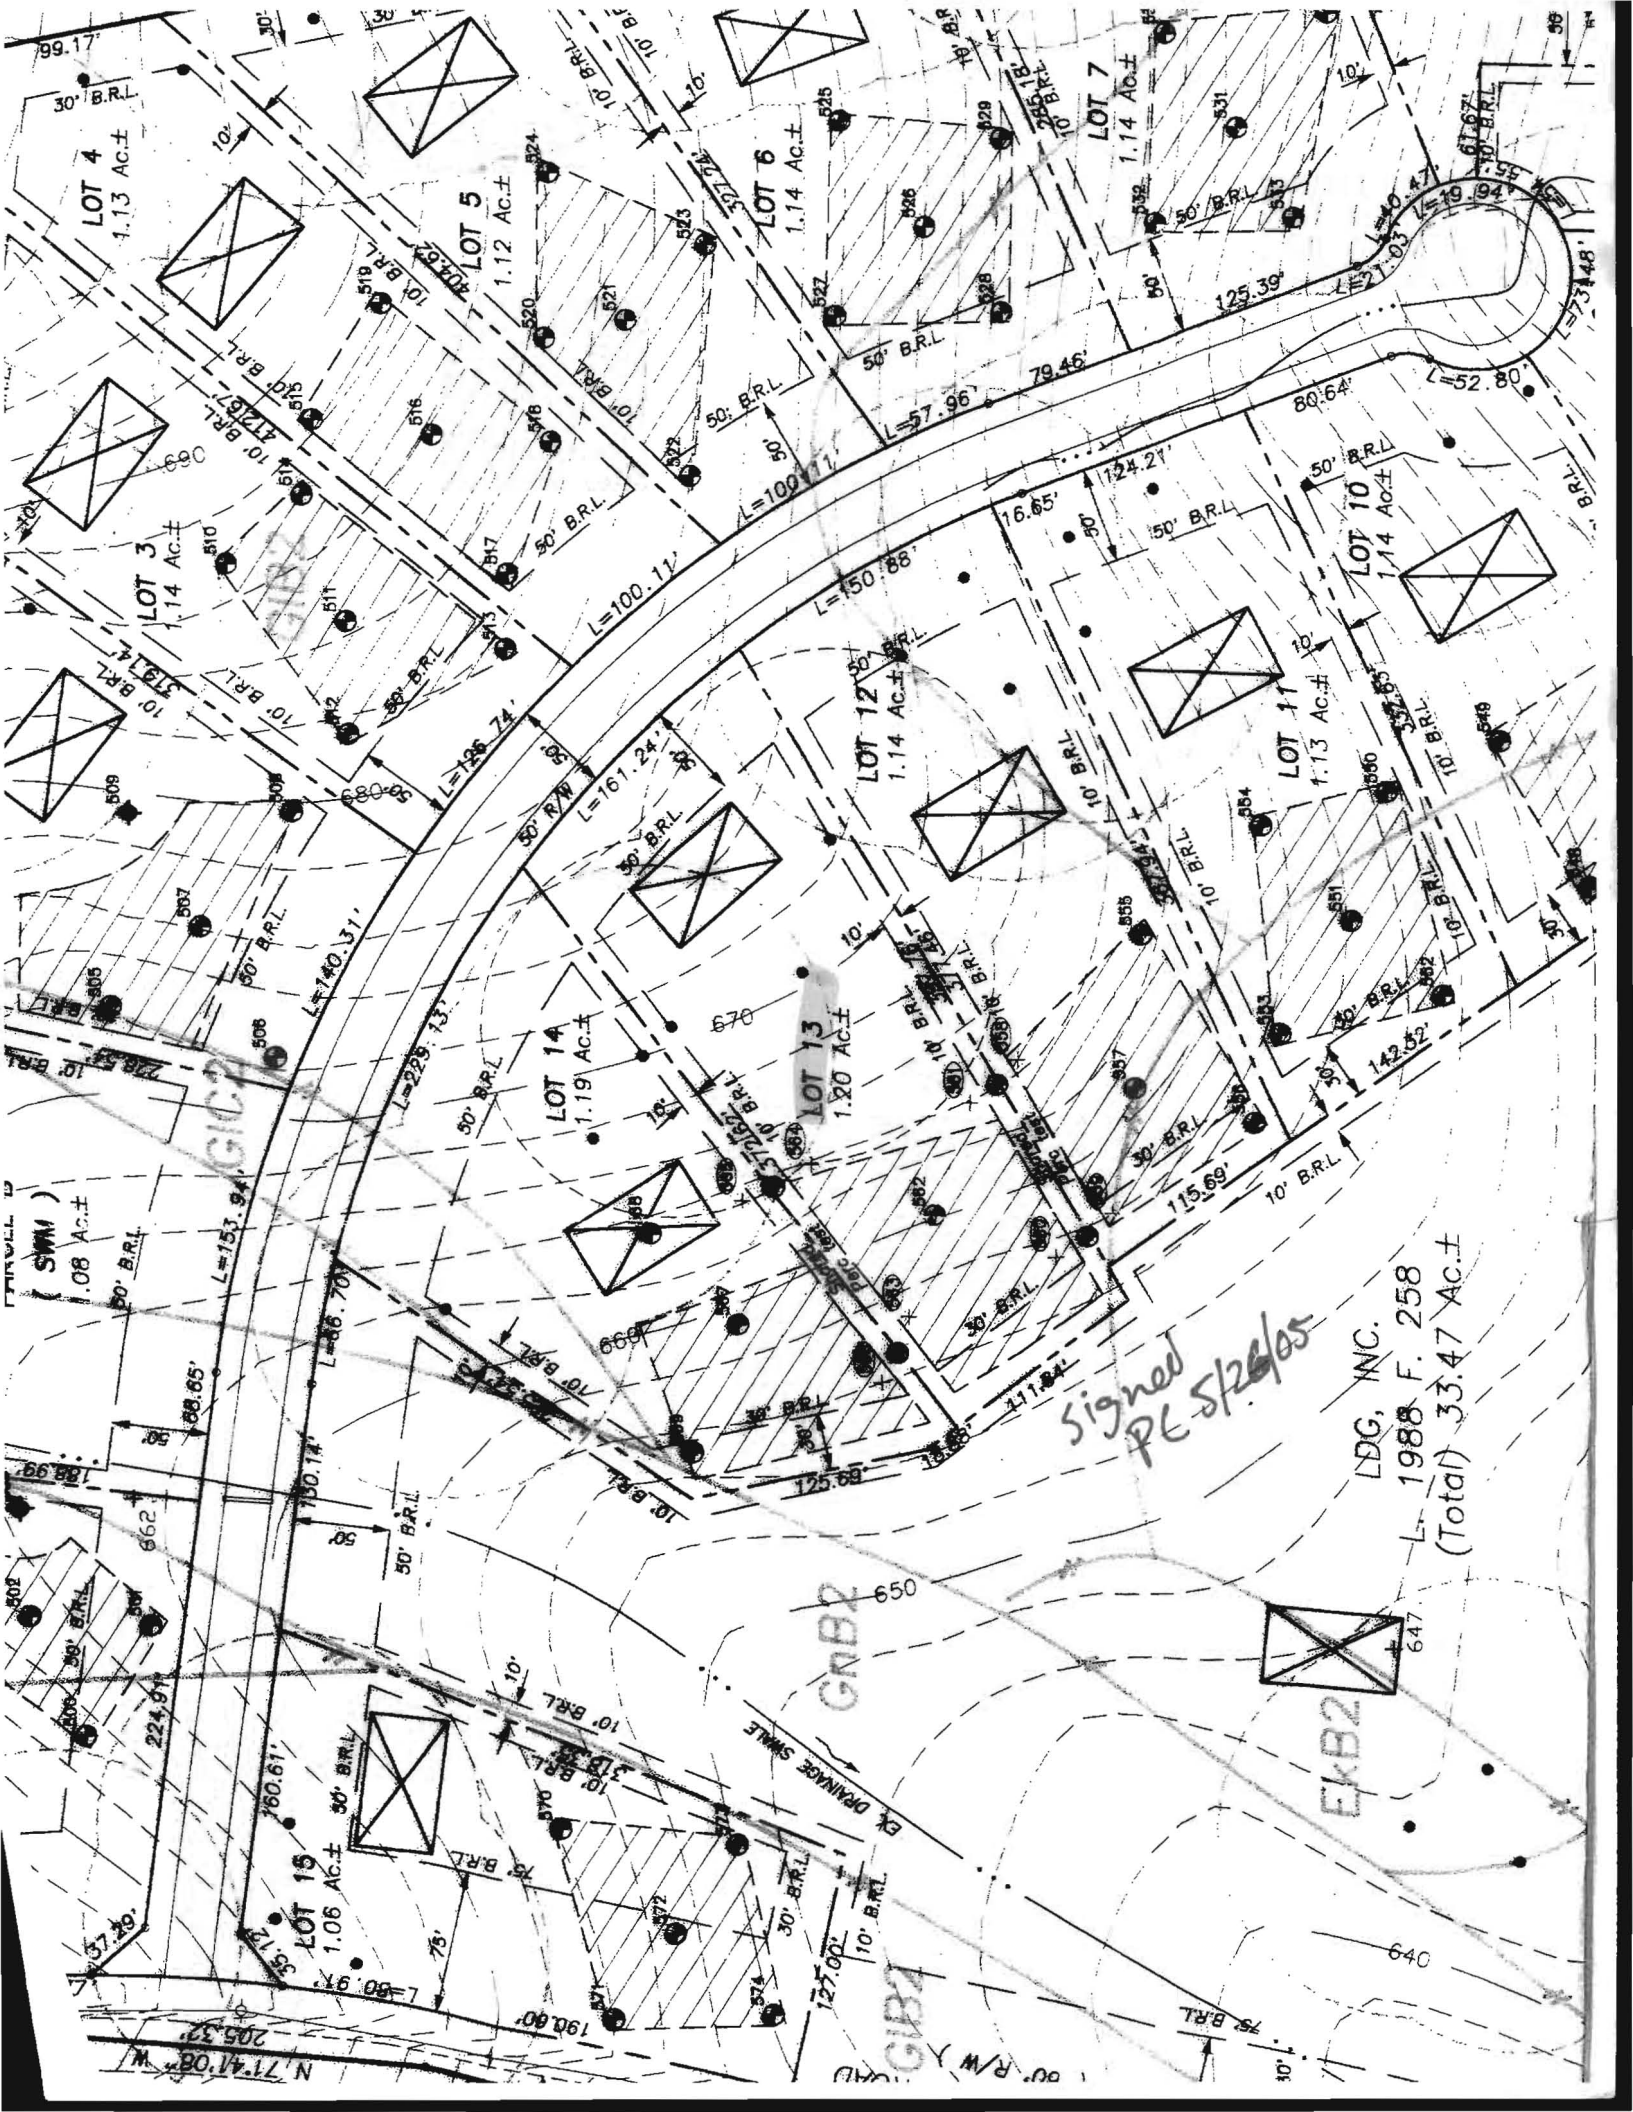

LOT 4
1.13 Ac.±

LOT 5
1.12 Ac.±

LOT 6
1.14 Ac.±

LOT 7
1.14 Ac.±

LOT 3
1.14 Ac.±

LOT 12
1.14 Ac.±

LOT 10
1.14 Ac.±

LOT 14
1.19 Ac.±

LOT 13
1.20 Ac.±

LOT 11
1.13 Ac.±

LOT 15
1.06 Ac.±

signed PE 5/26/05

L 1988 F. 258
(Total) 33.47 Ac.±

L 1988 F. 258

GIB2

EKb2

EX DRAINAGE SWALE

GIB2

99.17'

30' B.R.L.

10' B.R.L.

10' B.R.L.

(SWM)

1.08 Ac.±

50' B.R.L.

50' B.R.L.

10' B.R.L.

10' B.R.L.

N 71.41' 08" W

205.37'

L=80.97'

35.72'

75'

198.00'

127.00'

10' B.R.L.

10' B.R.L.

66.65'

188.99'

662'

750.14'

L=86.70'

L=1753.94'

L=228.73'

L=140.371'

L=228.73'

L=161.24'

L=100.11'

L=150.88'

L=124.21'

L=16.65'

L=57.96'

L=79.46'

L=80.64'

L=52.80'

L=21.03'

L=19.94'

30'

30'

10'

10'

50'

50'

75'

75'

100'

100'

125'

125'

150'

150'

175'

175'

200'

200'

225'

225'

250'

250'

275'

275'

