

PUB. SEWER STATUS VERIFIED BY _____

ISSUE DATE:

6/9/08

MINOR REPAIR

P 528983

APPROVAL DATE:

PERMIT

A REPAIR

6/12/08

Logged Into Permit
Tax ID # 04-365518 *Manager*

ON-SITE SEWAGE DISPOSAL SYSTEM
HOWARD COUNTY HEALTH DEPARTMENT
BUREAU OF ENVIRONMENTAL HEALTH

K & K Excavating

ADDRESS: PO Box 280, Lisbon, MD 21765

PHONE NUMBER: 410-442-1336

SUBDIVISION: Windridge Farm

LOT NUMBER: 24

ADDRESS: 14511 Windridge Court

PROPERTY OWNER: Sue Conklin

SEPTIC TANK CAPACITY (GALLONS): 1250

PUMP CHAMBER CAPACITY (GALLONS): 1250

NUMBER OF BEDROOMS: 4

SQUARE FEET PER BEDROOM: _____

LINEAR FEET OF TRENCH REQUIRED: _____

| | |
|-----------|---------------------------------------|
| TRENCHES: | |
| LOCATION: | |
| PURPOSE: | To replace broken line to septic tank |

PLANS APPROVED: _____

DATE: _____

NOTE: PERMIT VOID AFTER 2 YEARS

NOTE: CONTRACTOR RESPONSIBLE FOR SCHEDULING A PRE-CONSTRUCTION INSPECTION FOR ALL INSTALLATIONS

NOTE: WATERTIGHT SEPTIC TANKS REQUIRED


NOTE: ALL PARTS OF SEPTIC SYSTEM SHALL BE 100 FEET FROM ANY WATER WELL

NOTE: MANHOLE RISERS REQUIRED ON ALL SEPTIC TANKS AND PUMP CHAMBERS

**NEITHER THE HOWARD COUNTY COUNCIL OR THE HEALTH DEPARTMENT IS
RESPONSIBLE FOR THE SUCCESSFUL OPERATION OF ANY SYSTEM
PERMITTEE RESPONSIBLE FOR OBTAINING FINAL APPROVAL ON THIS PERMIT
CALL 410-313-1771 FOR INSPECTION OF SEPTIC SYSTEM**

NOT TO SCALE

HO-94-2810

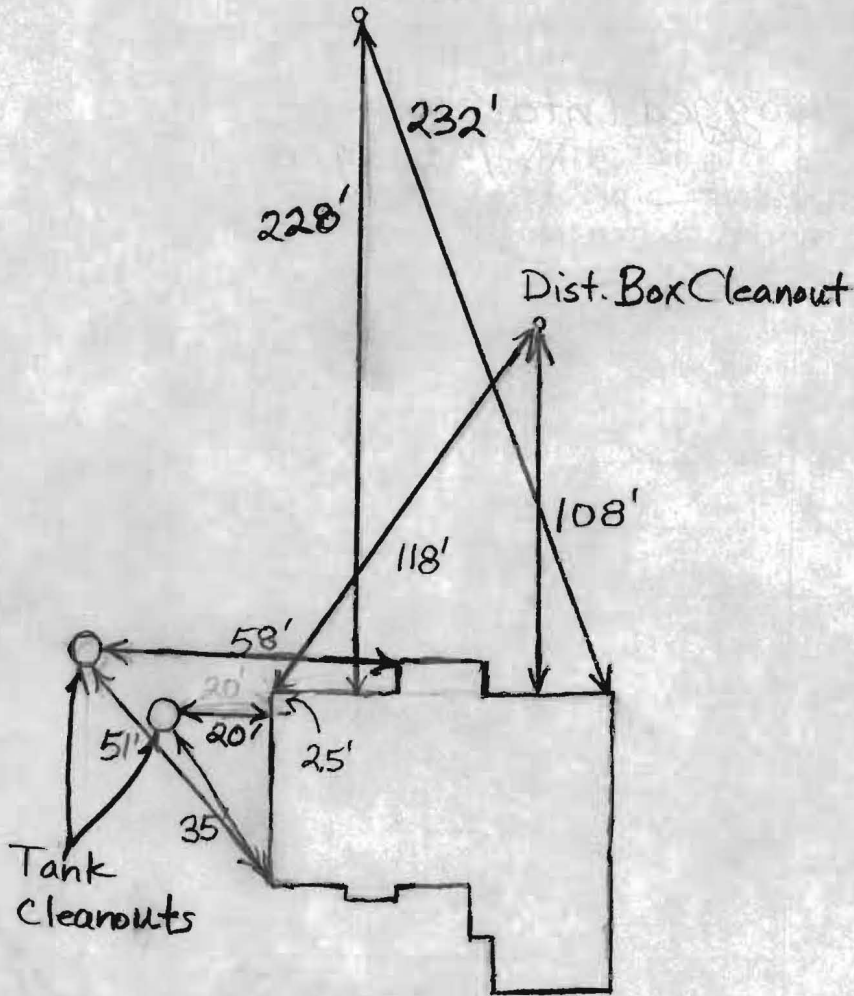

ROAD

TRENCH/DRAINFIELD DATA

| WIDTH | INLET | BOTTOM |
|-------|-------|--------|
| 10 | 10 | 10 |
| 20 | 20 | 20 |
| 30 | 30 | 30 |
| 40 | 40 | 40 |
| 50 | 50 | 50 |
| 60 | 60 | 60 |
| 70 | 70 | 70 |
| 80 | 80 | 80 |
| 90 | 90 | 90 |
| 100 | 100 | 100 |

NUMBER OF TRENCHES _____

TOTAL LENGTH _____

ABSORPTION AREA _____

DISTRIBUTION BOX LEVEL _____

DISTRIBUTION BOX BAFFLE _____

DISTRIBUTION BOX PORT _____

SEPTIC TANK DATA

SEPTIC TANK 1 LEVEL _____

CAPACITY _____ GAL

SEAM LOC _____

TANK LID DEPTH _____

BAFFLES _____

BAFFLE FILTER _____

MANHOLE LOC _____

6" PORT LOC _____

WATERTIGHT TEST _____

SEPTIC TANK 2 LEVEL _____

CAPACITY _____ GAL

SEAM LOC _____

TANK LID DEPTH _____

BAFFLES _____

BAFFLE FILTER _____

MANHOLE LOC _____

6" PORT LOC _____

WATERTIGHT TEST

PRE-CONSTRUCTION

INSTALLATION 6/12/08 Bowed section of pipe between house and tank replaced. (BB)

FINAL INSPECTOR

DATE OF APPROVAL

6/12/08