

DEPARTMENT OF INSPECTIONS, LICENSES AND PERMITS 3430 COURT HOUSE DRIVE ELLICOTT CITY, MD 21043 PERMITS (410) 313-2455 INSPECTIONS (410) 313-1810 AUTOMATED INFORMATION (410) 313-3800	HOWARD COUNTY PERMIT APPLICATION	PERMIT NUMBER B000129747
---	---	---

Building Address <u>14511 Windridge Ct</u> <u>Glenwood MD 21738</u> Suite/Apt. #: _____ SDP/WP/Petition #: _____ Census Tract <u>60110</u> Subdivision <u>Windridge</u> Section <u>2</u> Area <u>2</u> Lot <u>24</u> Tax Map <u>21</u> Parcel <u>31</u> Grid <u>17</u> Zoning <u>REDEP</u> Map Coordinates <u>91310</u> Lot size <u>1.0A</u> Existing Use <u>VACANT LOT</u> Proposed Use <u>SFD</u> Estimated Construction Cost \$ <u>350,000</u> Description of Work <u>to construct a 4800sq, 4FB</u> <u>1-11B, SFD with 1 FP, 3 car garage, front</u> <u>porch and 34x12 rear deck, partial finish</u> <u>basement</u> Occupant or Tenant _____ Contact Name _____ Address _____ City _____ State _____ Zip Code _____ Phone _____ Fax _____	Property Owner's Name <u>Selfridge Bldg</u> Address <u>14045 GARD DRIVE</u> City <u>Glenwood</u> State <u>MD</u> Zip Code <u>21738</u> Home Phone <u>410-531-8913</u> Work Phone _____ Applicant's Name & Mailing Address, (if other than stated hereon): _____ Phone _____ Fax _____ Contractor Company <u>Selfridge Bldg</u> Contact Person <u>Tim Logan</u> Address <u>14045 GARD DRIVE</u> City <u>Glenwood</u> State <u>MD</u> Zip Code <u>21738</u> License No. <u>729</u> Phone _____ Fax _____ Engineer or Architect Company _____ Contact Person _____ Address _____ City _____ State _____ Zip Code _____ Phone _____ Fax _____
---	--

BUILDING DESCRIPTION - <u>COMMERCIAL</u>		BUILDING DESCRIPTION - <u>RESIDENTIAL</u>	
Building Characteristics Height: _____ No. of stories: _____ Gross area, sq. ft. per floor: _____ Use group: _____ Construction type: ☐ Reinforced Concrete ☐ Structural Steel ☐ Masonry ☐ Wood Frame ☐ State Certified Modular	Utilities Water Supply: _____ ☐ Public ☐ Private Sewage Disposal: _____ ☐ Public ☐ Private Electric Yes ☐ No ☐ Gas Yes ☐ No ☐ Heating System: Electric ☐ Oil ☐ Natural Gas ☐ Propane Gas ☐ Sprinkler system: N/A ☐ ☐ Full ☐ Partial ☐ Other Suppression ☐ # of Heads	Building Characteristics SF Dwelling ☐ SF Townhouse ☐ <u>Depth</u> <u>Width</u> 1st floor: _____ 2nd floor: _____ Basement: _____ Finished Basement ☒ Unfinished Basement ☐ Crawl space ☐ Slab on Grade ☐ No. of Bedrooms <u>4</u> Multi-family dwellings: No. of efficiency units: _____ No. of 1 BR units: _____ No. of 2 BR units: _____ No. of 3 BR units: _____ Other Structure: _____ Dimensions: _____ Footings: _____ Roof: _____ ☐ State Certified Modular ☐ Manufactured Home	Utilities Water Supply: _____ ☐ Public ☒ Private Sewage Disposal: _____ ☐ Public ☒ Private Electric Yes ☐ No ☐ Gas Yes ☒ No ☐ Heating System: Electric ☐ Oil ☐ Natural Gas ☒ Propane Gas ☐ Sprinkler system: N/A ☐ ☐ NFPA #13D ☐ NFPA #13R ☐ Other:

THE UNDERSIGNED HEREBY CERTIFIES AND AGREES AS FOLLOWS: (1) THAT HE/SHE IS AUTHORIZED TO MAKE THIS APPLICATION; (2) THAT THE INFORMATION IS CORRECT; (3) THAT HE/SHE WILL COMPLY WITH ALL REGULATIONS OF HOWARD COUNTY WHICH ARE APPLICABLE THEREIN; (4) THAT HE/SHE WILL PERFORM NO WORK ON THE ABOVE REFERENCED PROPERTY NOT SPECIFICALLY DESCRIBED IN THIS APPLICATION; (5) THAT HE/SHE GRANTS COUNTY OFFICIALS THE RIGHT TO ENTER ONTO THIS PROPERTY FOR THE PURPOSE OF INSPECTING THE WORK PERMITTED AND POSTING NOTICES.


Applicant's Signature <u>Cindy DelZoppo</u> <u>Associate</u> Title/Company	Print Name <u>Cindy DelZoppo</u> Date <u>4/30/01</u>
--	---

Checks payable to: DIRECTOR OF FINANCE OF HOWARD COUNTY

PLEASE WRITE NEATLY AND LEGIBLY.

FOR OFFICE USE ONLY


AGENCY ☒ Land Development, DPZ ☐ State Highways ☐ Building Official ☒ Dev. Engineering, DPZ ☐ Health ☐ Fire Protection ☒ Is Sediment Control approval required prior to issuance? YES ☒ NO ☐	DATE <u>5/9/01</u> SIGNATURE APPROVAL <u>Mark Deffen</u> CONTINGENCY CONSTRUCTION START: ☐ ONE STOP SHOP: ☐	DPZ SETBACK INFORMATION Front: _____ Rear: _____ Side: _____ Side St.: _____ All minimum setbacks met? YES ☐ NO ☐ Is Entrance Permit required? YES ☐ NO ☐ Historic District? YES ☐ NO ☐ Lot Coverage for NewTown Zone _____ SDP/Red-line approval date _____	PROPERTY ID# <u>50411</u> Filing fee \$ <u>25</u> Permit fee \$ _____ Excise tax \$ _____ Sub-total paid \$ _____ Add'l permit fee \$ _____ TOTAL FEES \$ _____ Balance due \$ _____ Check # <u>17447</u> Validation # <u>200151</u>
--	---	---	---

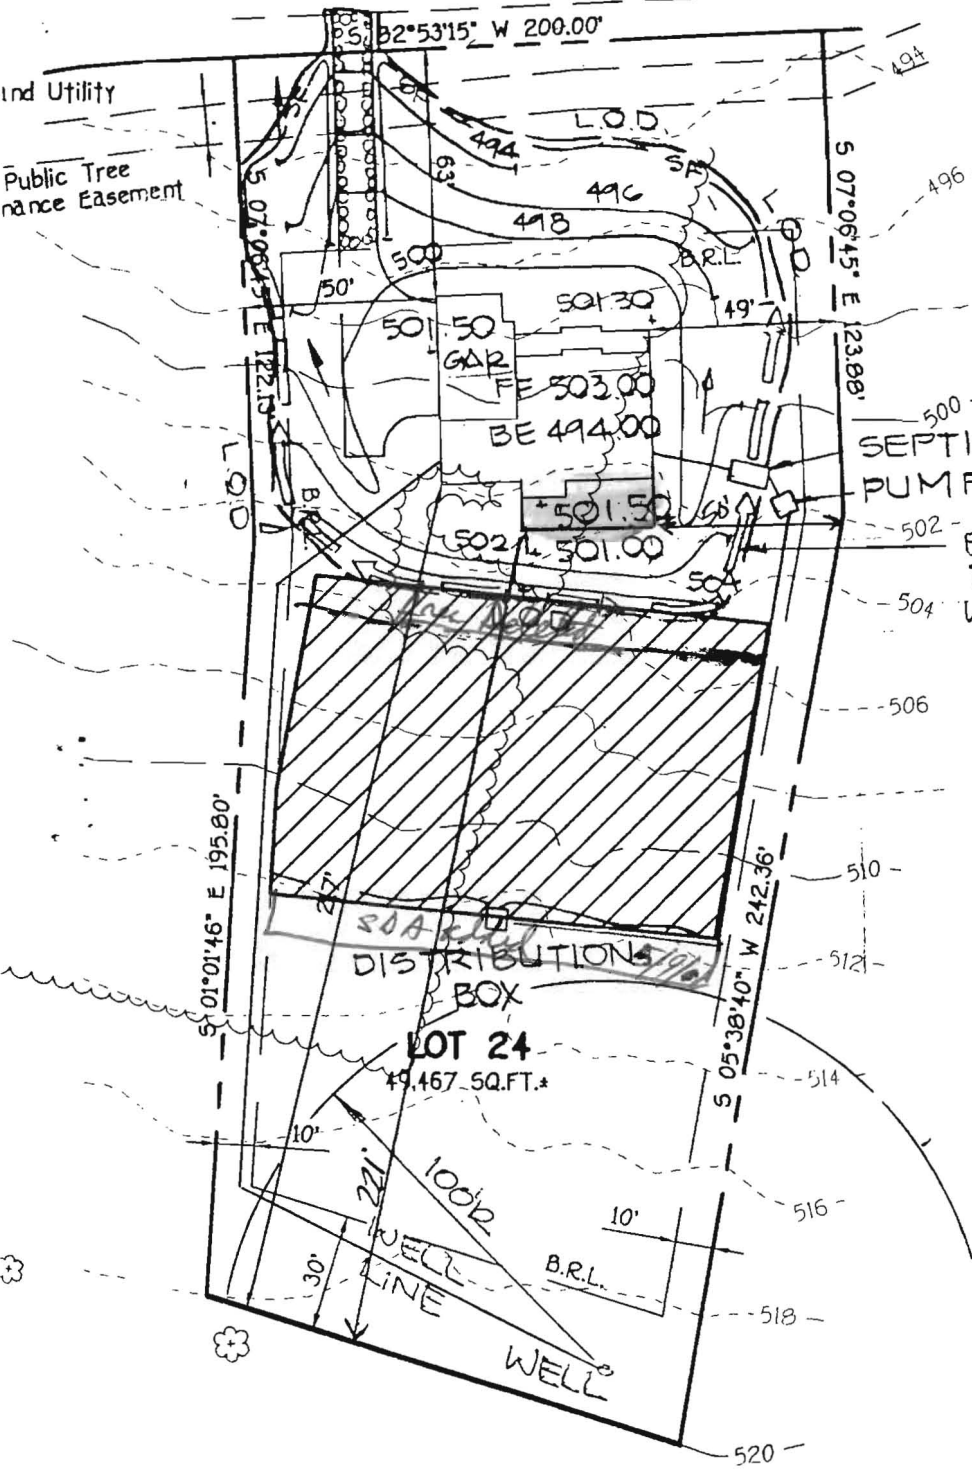

SEPTIC TANK
PUMP TANK

EARTH DIKE TYPE A-1
TO DIVERT CLEAN
WATER.

B00132360
14511 Windridge Ct
BP (check) addition is for
enough from Lenard SDA.
Recommend approval. 4/9/12/01

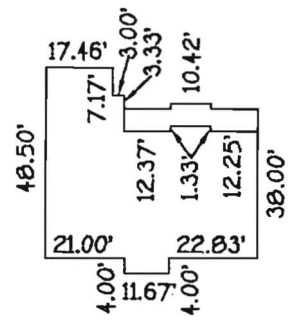

WINDRIDGE FARMS

Section 2 Area 2

Lot 24

Tax Map 21 Parcel 31 Gr
Fourth Election District Howard C
Scale 1"=50' Date April

GP.01-169