

APPLICATION

PERCOLATION TESTING

A 58947 T

P _____

HOWARD COUNTY HEALTH DEPARTMENT
BUREAU OF ENVIRONMENTAL HEALTH
3525-H ELLICOTT MILLS DRIVE/ELLICOTT CITY, MARYLAND 21043
TELEPHONE: 313-2640

DISTRICT 04

DATE _____

TO: THE COUNTY HEALTH OFFICER
ELLICOTT CITY, MARYLAND

I HEREBY APPLY FOR THE NECESSARY TEST PRIOR TO APPLICATION FOR PERMIT TO CONSTRUCT (OR RECONSTRUCT) A SEWAGE DISPOSAL SYSTEM.

PROPERTY OWNER Ray J. JANE Cabbage

ADDRESS 14504 Dorsey Mill Rd. Glenelg MD PHONE 410-489-7017

AGENT OR PROSPECTIVE BUYER Susquehanna LAND 21738 Holding Co.

ADDRESS 1814 Hyman Ln Crofton, MD 21114 PHONE 410-451-3916

PROPERTY LOCATION:

SUBDIVISION Cabbage Sub. LOT NO. 20 (16)

ROAD AND DESCRIPTION _____

TAX MAP 21 PARCEL # 31

SIZE OF LOT 1 ± Ac. TYPE BLDG. SFD
(SINGLE FAMILY DWELLING OR COMMERCIAL)

THE SYSTEM INSTALLED UNDER THIS APPLICATION IS ACCEPTABLE ONLY UNTIL PUBLIC FACILITIES BECOME AVAILABLE. I FULLY UNDERSTAND THE FEE CONNECTED WITH THE FILING OF THIS PERC TEST APPLICATION IS NON-REFUNDABLE UNDER ANY CIRCUMSTANCES. I ALSO AGREE TO COMPLY WITH ALL M.O.S.H.A. REQUIREMENTS IN TESTING THIS LOT.

(SIGNATURE OF APPLICANT)

APPROVED BY _____ FOR _____ DATE _____

DISAPPROVED BY _____ FOR _____ DATE _____

HOLD PENDING FURTHER TESTS _____

REASONS FOR REJECTION OR HOLDING _____

PERCOLATION TEST PLAT/PRELIMINARY PLAT - TITLE OR I.D. # _____ DATE _____

SITE DEVELOPMENT PLAN/FINAL PLAT - TITLE OR I.D. # _____ DATE _____

THIS IS NOT A PERMIT

58947 T

COUNTY #

SOIL PROFILE

20A

or/br
clay
loamtan/or
silty
sand
loam
10-20%
rock frags

20B

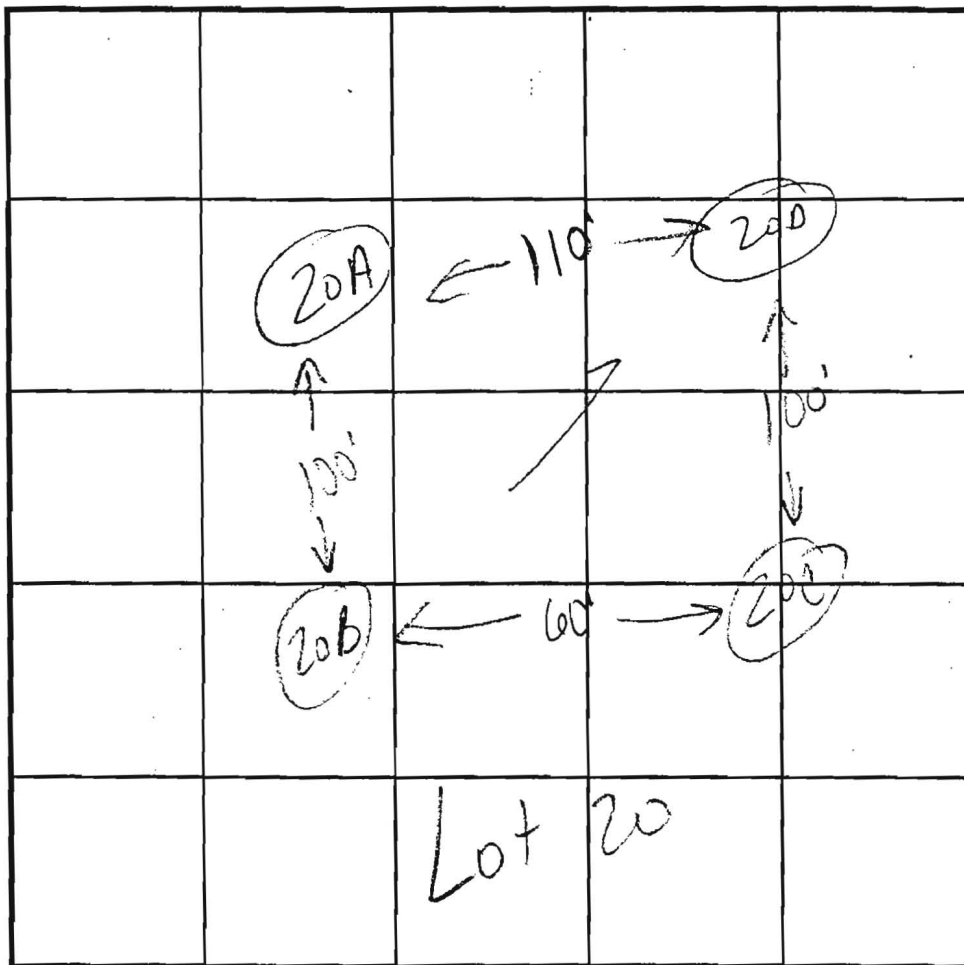
or/br
clay
lmsr/yellow
brown
silty
loam
30%
rock
frags

(20C)

or/br
clay
loamlt. tan
pink
silty
sand
loam10%
shale
frags

SOIL PROFILE

(20D)

or/br
clay
loamlt tan/
pink
silty
loam
20%
rock
frags

INDICATE NORTH - NAME ADJOINING ROADWAY AS BASE LINE.

DATE	TEST NO.	DEPTH	PRE-WET		TEST - 1" DROP		TIME
			START	STOP	START	STOP	
10-7-97	20A	3.0'S	11:48	11:49	11:49	11:52	3min
		11.0'D	Visual	ok			
	20B	3.0'S	11:40	11:42	11:42	11:45	3min
		11.0'D	Visual	ok			
	20C	3.0'S	2:15	2:17	2:17	2:19	2min
		6.0'S	2:1630	2:20	2:20	2:24	4min
		10.0'D	Visual	ok	- see profile		
	20D	3.0'S	2:27	2:2830	2:2830	2:3030	2min
		11.0'D	Visual	ok	- see profile		

REMARKS test holes staked

TYPE OF SOIL

TESTED BY

Kim Maute / Kim Soe

ALSO PRESENT

Huan + Jeff

TRENCH DESIGN DATA: AVERAGE PERCOLATION TIME

2-3 minutes

TRENCH WIDTH

3

INLET DEPTH

3

MAXIMUM BOTTOM DEPTH

5

SQ. FT./BEDROOM

180

58947T

COUNTY #

P/O LOT 16

SOIL PROFILE

20E

or/br
clay lmbr/tan
silt lm
10-15%
shale
frags

20G

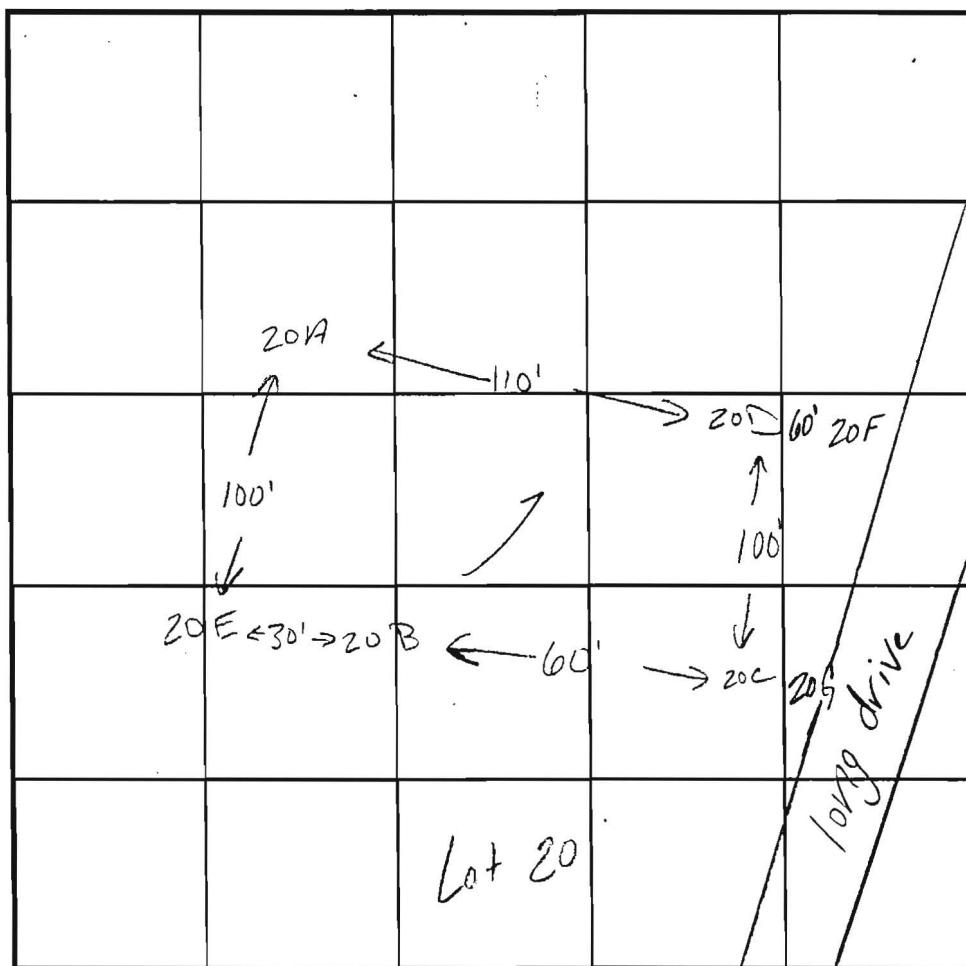
orange
cl lmorange/
brown/
gray
silt lm10%
shale
frags

20F

orange
cl lmorange/
beige
silt lm10%
shale
frags

SOIL PROFILE

21A

orge
br
cl lmlt. tan
orge
silt lm
10-15%
Rx

INDICATE NORTH - NAME ADJOINING ROADWAY AS BASE LINE.

DATE	TEST NO.	DEPTH	PRE-WET		TEST - 1" DROP		TIME
			START	STOP	START	STOP	
4.28.98	20E	12.0'D	visual	only	-see profile		
9.16.98	20G	4.0'S	1:31	1:31:30	1:31:30	1:32:30	1 min
		12.0'D	visual	ok	-see profile		
		(repour)	1:34	1:35:20	1:35:20	1:37	1:40
	20F	12.0'D	visual	only	-ok see profile		
10/7/97	21A	2.5					2 1/2
		11.5					

REMARKS test holes staked

TYPE OF SOIL

TESTED BY

Kim Wilkoste

ALSO PRESENT

Chuck Zepp

TRENCH DESIGN DATA: AVERAGE PERCOLATION TIME

2-3 min

TRENCH WIDTH

3

INLET DEPTH

3

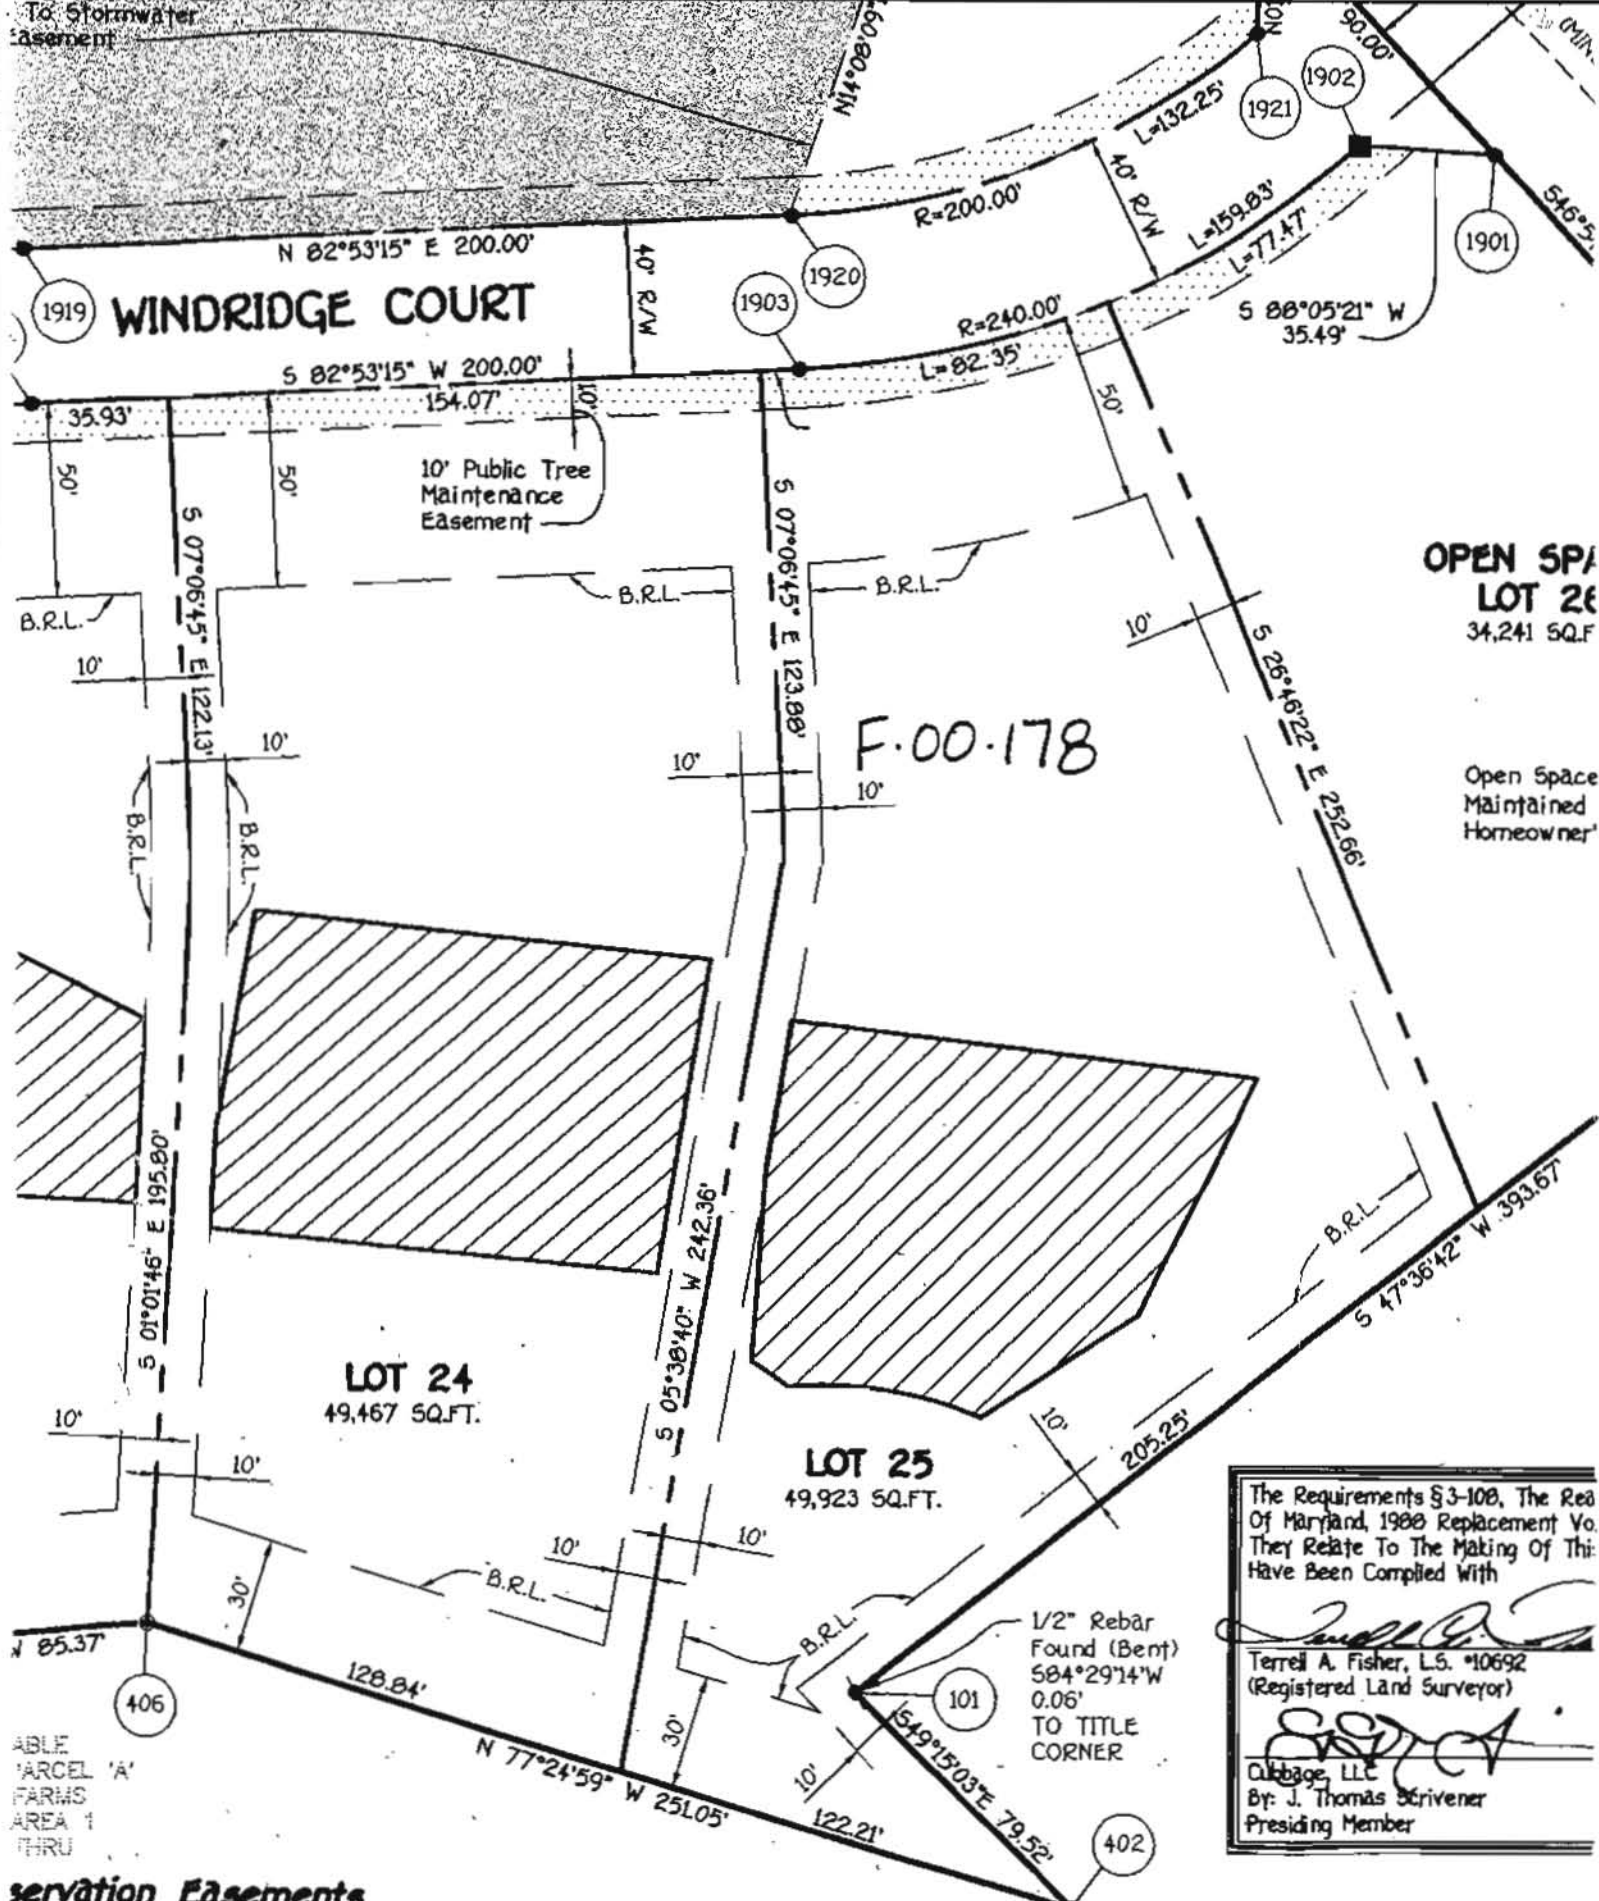
MAXIMUM BOTTOM DEPTH

5

SQ. FT./BEDROOM

180

To Stormwater
Easement



OPEN SPACE
LOT 26
34,241 SQ.F

Open Space
Maintained
Homeowner

F.00.178

The Requirements §3-108, The Real Property Code of Maryland, 1988 Replacement Volume, They Relate To The Making Of This Map Have Been Complied With

Terrell A. Fisher, L.S. #10692
(Registered Land Surveyor)

Cubbage, LLC
By: J. Thomas Scrivener
Presiding Member

Conservation Easements

This Plan For Water, Sewer, Storm Drainage, Other Easements Located In, On, Over, And Through Lots 8 Through 26, Any Easements, Whether Or Not Expressly Stated In The Deeds(s) Herein Reserved To Howard County, With A Metes And Bounds Description And Their Acceptance By Howard County, And The Developer's Obligations Under The Forest Conservation Act, The Release Of Conveyance County Deeded 12th, 2014

OWNER/DEVELOPER

CUBBAGE, LLC
c/o MR. J. THOMAS SCRIVENER
8808 CENTRE PARK DRIVE

