

7/18/73  
OK - File  
WNF

# PERMIT

SEWAGE DISPOSAL SYSTEM

MARYLAND STATE DEPARTMENT OF HEALTH  
HOWARD COUNTY

P 19360

A 14723

ELLICOTT CITY

DISTRICT 3

DATE 12/10/73

INDEXED

Walter Shank IS PERMITTED TO INSTALL X ALTER

ADDRESS 13194 Sky Way, Ellicott City, Maryland PHONE 531-5631

A SEWAGE DISPOSAL SYSTEM LOCATED AT \_\_\_\_\_

SUBDIVISION Woodmark, Inc. ROAD Pan Spring Court LOT 51, Blk. B, Sec. 6

PROPERTY OWNER Herbert Arnold

ADDRESS \_\_\_\_\_

SPECIFICATIONS - 4 bedrooms

DRAIN FIELD \_\_\_\_\_ DEPTH \_\_\_\_\_ FEET, BOTTOM AREA \_\_\_\_\_ SQ. FT.

SEEPAGE PITS \_\_\_\_\_ ABSORBENT SIDE-WALL AREA \_\_\_\_\_ SQ. FT.

SEPTIC TANK CAPACITY 1,250 GALLONS

FOR GARBAGE GRINDER, INCREASE DISPOSAL AREA 22% & TANK CAPACITY 50%.

OTHER Dry well 400 sq. ft. sidewall area below inlet. Maximum depth of dry well is 11 ft.

and maximum depth of inlet is 5 ft. Place the dry well 60 ft. from the back lot line and

105 ft. from the right side of the lot as seen when facing the lot from Pan's Spring Court.

NOTE: ALL PIPE FROM HOUSE TO DRY WELL MUST BE CAST IRON.

PERMIT VOID AFTER THREE YEARS.

NOTE: INSTALL STAND PIPE ON SEPTIC TANK AND DRY WELL.


PLANS APPROVED BY Raymond Hodgas DATE 8/11/71

FILL SEPTIC TANK AND DISTRIBUTION BOX WITH WATER BEFORE CALLING FOR AN INSPECTION. COVER NO WORK UNTIL INSPECTED AND APPROVED.

NEITHER THE HOWARD COUNTY COMMISSIONERS NOR THE HEALTH DEPARTMENT IS RESPONSIBLE FOR THE SUCCESSFUL OPERATION OF ANY SYSTEM.

A 14723

\_\_\_\_\_  
INSPECTOR DATE SYSTEM APPROVED

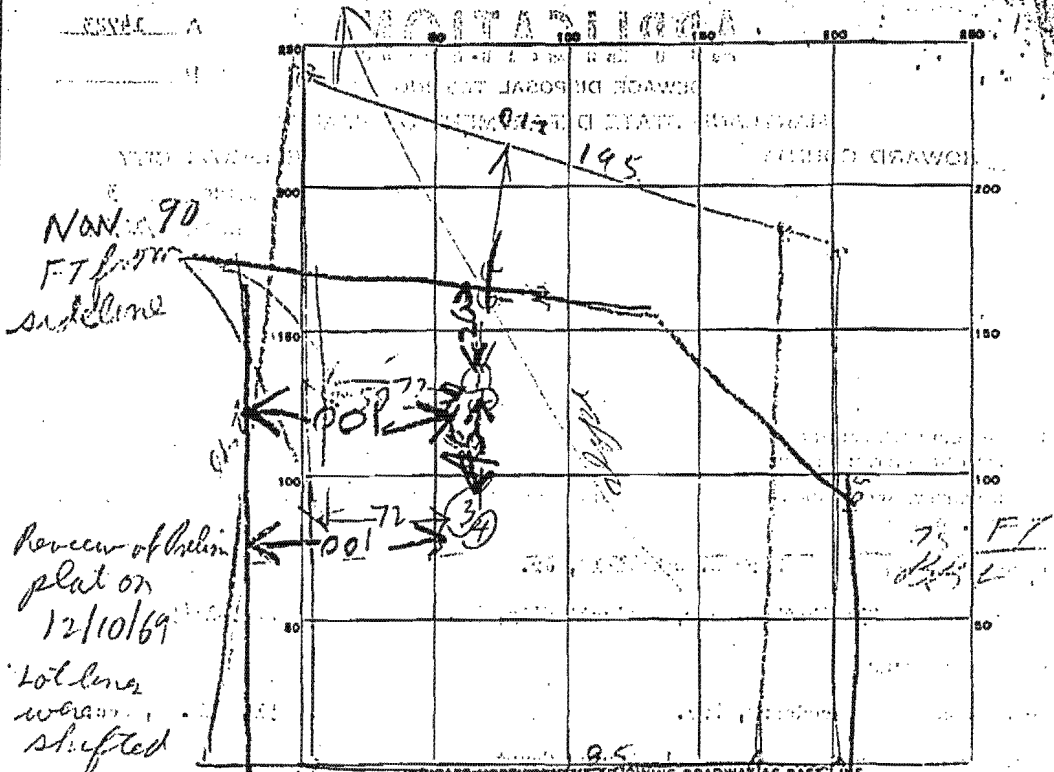

Review of helix plot on 12/10/69

12/17/69

Very Great change in back line & also side RH

Lot had to be altered to include the [unclear] [unclear]

PANS MARKING CORNER

DATE	TEST NO.	DEPTH	PRE-WET		TEST 1" DROP		TIME
			START	STOP	START	STOP	
1/1/69	1	11"	299	301	301	305	4
1	2	5"	299	302	302	306	4
1	3	5 1/2"	307	314	314	328	4
1	4	10 1/2"	307	312	312	322	10

Lot size & depth size  
May 1969  
5 FT

SOIL AUGER FINDING  
TESTED BY *M. [unclear]*

REMARKS 2/13/69. Must get location of holes from [unclear]

**Fogle's Septic Clean, Inc.**  
**580 Obrecht Road**  
**Sykesville, MD 21784**

**Invoice Date**      **Invoice #**  
 11/9/2015              271031

**INVOICE**

*PLEASE PAY*  
*THIS AMOUNT*                      \$240.00

Make checks payable to: **Fogle's Septic Clean, Inc.**

**Bill To:**

OBI NDU  
 12336 PANS SPRING CT  
 ELLICOTT CITY, MD 21042

**Service Address**

OBI NDU  
 12336 PANS SPRING CT  
 ELLICOTT CITY, MD 21042

**Phone #**              410-795-5670

Fogle's Septic Clean, Inc.  
 580 Obrecht Road  
 Sykesville, MD 21784

**PLEASE DETACH AND RETURN TOP PORTION WITH PAYMENT**

P.O. #	Due Date	Rep	Ship Date
	11/9/2015	HLK	11/6/2015

Qty	Description	Rate	Amount
	PUMP SEPTIC HEAVY SOLIDS	240.00	240.00

Thank you for your business.  1.5% interest will be charged monthly on all unpaid balances after 30 days. \$30 CHARGE FOR RETURNED CHECK. RECEIPT DATE STAMPS ARE STRICTLY ENFORCED for ALL DISCOUNTS.	<b>Subtotal</b>	\$240.00
	<b>Total</b>	\$240.00
	<b>Payments/Credits</b>	\$0.00
	<b>Customer Total Balance</b>	\$246.27
<b>Billing Questions Call</b>	410-795-5670	

December 8<sup>th</sup>, 2016

Adora Ndu  
12336 Pans Spring Ct  
Ellicott City, MD 21042

Dear Mike David (or whom it may concern),

I am the homeowner currently residing at 12336 Pans Spring Ct, Ellicott City, MD, 21042. I waive the waive percolation certification release plan. My current septic system is in good working order and is serviced regularly.

Respectfully,



---

Adora Ndu, Homeowner

12/15/16  
Approved  
Michael J. Davis