



Bureau of Environmental Health

8930 Stanford Boulevard, Columbia, MD 21045

Main: 410-313-2640 | Fax: 410-313-2648

TDD 410-313-2323 | Toll Free 1-866-313-6300

www.hchealth.org

Facebook: www.facebook.com/hocohealth

Twitter: HowardCoHealthDep

Maura J. Rossman, M.D., Health Officer

A 562302

APPLICATION

FOR PERCOLATION TESTING AND SITE EVALUATION

PROPERTY LOCATION

SUBDIVISION/PROPERTY NAME _____

PROPERTY ADDRESS 14050 Tridelpia Rd Glenridge MD 21737
STREET TOWN ZIP

TAX ACCOUNT # _____ TAX MAP DD21 GRID 0018 PARCEL 0162 LOT NO. _____ PROPOSED LOT
SIZE (ACRES) 6.13 AC

ZONING CATEGORY _____ TIER _____

PROPERTY OWNER(S) ADELEKE A OGUNMEFUN

DAYTIME PHONE _____ CELL 1410 295 4589 EMAIL _____

MAILING ADDRESS 14050 Tridelpia Rd Glenridge MD 21737
STREET CITY, STATE ZIP

APPLICANT Mara D Hereta RELATIONSHIP TO OWNER: contractor

DAYTIME PHONE 301 580 5977 CELL _____ EMAIL maradhereta@Gmail.com

MAILING ADDRESS 2551 Florence Rd Woodbine MD 21797
STREET CITY, STATE ZIP

I HEREBY APPLY FOR THE NECESSARY TESTING/EVALUATION PRIOR TO ISSUANCE OF SEWAGE DISPOSAL SYSTEM PERMIT(S):

PROPERTY:

- ☐ SUBDIVISION: NUMBER OF LOTS INCLUDING RESIDUE: _____
SUBDIVISION CLASSIFICATION (PER DEPT. OF PLANNING AND ZONING) ☐ MAJOR ☐ MINOR
- ☐ CONSTRUCT NEW OSDS ON UNDEVELOPED LOT
- ☒ REPAIR OR REPLACE FAILING OSDS
- ☐ UPGRADE EXISTING OSDS

BUILDING:

- ☒ RESIDENTIAL WITH 4 1/2 EXISTING OR PROPOSED BEDROOMS IN THE COMPLETED STRUCTURE
- ☐ COMMERCIAL (PROVIDE DETAIL OF TYPE OF USE AND NUMBERS OF EMPLOYEES/CUSTOMERS ON ACCOMPANYING PLAN)

IS THE PROPERTY WITHIN 2500 FEET OF ANY RESERVOIR?

- ☐ YES
- ☒ NO

AS APPLICANT, I UNDERSTAND THE FOLLOWING:

- THIS APPLICATION IS VALID FOR TWO(2) YEARS FROM DATE OF FEE PAYMENT AND APPROVAL IS BASED UPON HEALTH OFFICER SIGNATURE OF A PERC CERTIFICATION PLAN PRIOR TO EXPIRATION OF THIS PERMIT.
- THE APPLICATION FEE IS NON-REFUNDABLE
- THIS APPLICATION MUST BE ACCOMPANIED BY ALL APPLICABLE FEES AND A SUITABLE SITE PLAN IN ORDER TO BE PROCESSED
- THIS IS A PUBLIC DOCUMENT

I declare and affirm that to the best of my knowledge, the information contained herein is correct. I declare that I am the owner of the property or duly authorized to make this application on behalf of the owner. I agree to comply with all applicable state and county regulations.

By signature of this application, I hereby grant Howard County Health Department officials the right to enter onto the property for the purpose of inspecting the property as directly related to the requested permit/service.

Mara D Hereta


SIGNATURE OF APPLICANT

10/16/17

DATE

A

0	dk brn loam msbk roots
8'	red brn cl loam msbk roots 10% rock
3.5'	brn scl weak platy many mica roots 10% rock
7'	red brn / gel brn fol weak platy 20% rock many mica roots
14'	

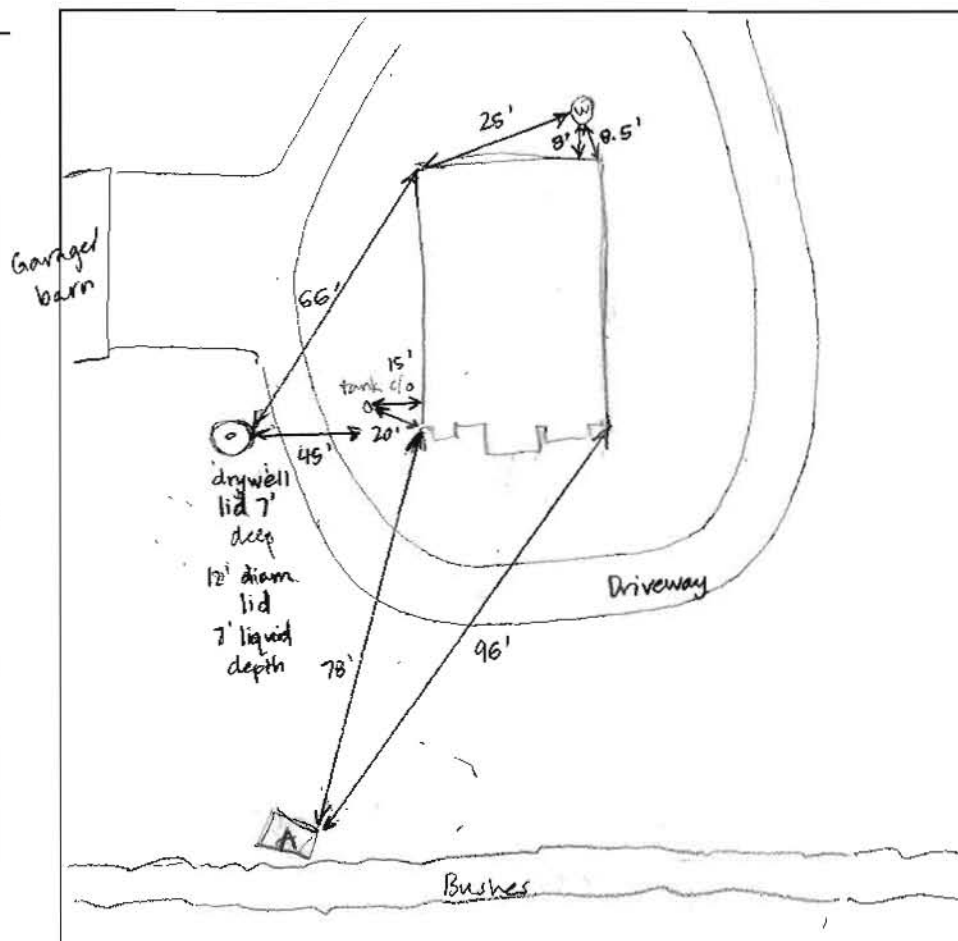

DATE	TEST #	DEPTH	START	BREAK 1" DROP	STOP 2" DROP	TIME OF 2ND INCH	P/F/H
	A	6' / 14'	0:00	12:10	37:59	25 mins	P
		H ₂ O poured @ bottom				110 mins / inch	
		8' / 14'	0:00	8:43	16:51	8 mins	P

REMARKS Existing tank is deep - liquid @ 6'3". New tank + trench inlet will
 SANITARIAN Sarah Collins BACKHOE Marc Hereth OTHERS Clyde (helper) be
 TEST HOLES USED IN SDA A AVG. PERC TIME SQ. FT/BR 5 BR deep
 TRENCH WIDTH 3' INLET DEPTH 5.5-6' MAX. BOT DEPTH 10' EFFECTIVE S/W 7'