



APPLICATION

FOR PERCOLATION TESTING AND SITE EVALUATION

TEST DATE(S) _____ TEST TIME _____

AP5200784

AGENCY REVIEW: _____

DATE 3/2/04

DO NOT WRITE ABOVE THIS LINE

I HEREBY APPLY FOR THE NECESSARY TESTING/EVALUATION PRIOR TO ISSUANCE OF SEWAGE DISPOSAL SYSTEM PERMIT(S) TO:

CHECK AS NEEDED:

- CONSTRUCT NEW SEPTIC SYSTEM(S)
- REPAIR/ADD TO AN EXISTING SEPTIC SYSTEM
- REPLACE AN EXISTING SEPTIC SYSTEM

CHECK AS NEEDED:

- NEW STRUCTURE(S)
- ADDITION TO AN EXISTING STRUCTURE
- REPLACE AN EXISTING STRUCTURE

CHECK ONE:

- CREATE NEW LOT(S)
- BUILD ON AN EXISTING LOT IN A SUBDIVISION
- BUILD ON AN EXISTING PARCEL OF RECORD

IS THE PROPERTY WITHIN 2500' OF ANY RESERVOIR?

- YES
- NO

THE TYPE OF STRUCTURE IS:

- RESIDENTIAL WITH unknown PROPOSED BEDROOMS IN THE COMPLETED STRUCTURE (NOTE **UNKNOWN** IF APPROPRIATE)
- COMMERCIAL (PROVIDE DETAIL OF NUMBERS AND TYPES OF EMPLOYEES/ CUSTOMERS ON ACCOMPANYING PLAN)
- INSTITUTIONAL/GOVERNMENT (PROVIDE DETAIL OF NUMBERS AND TYPES OF EMPLOYEES/USERS ON ACCOMPANYING PLAN)

PROPERTY OWNER(S) LDB, Inc.

DAYTIME PHONE (301) 585-7000 CELL _____ FAX (301) 585-4604

MAILING ADDRESS Lee Plaza Suite 200 8001 Georgia Avenue Silver Spring MD 20910-3437

APPLICANT VanMar Associates, Inc.

DAYTIME PHONE (301) 829-2890 CELL _____ FAX (301) 831-5603

MAILING ADDRESS 310 South Main St. Mt. Airy MD 21771

APPLICANT'S ROLE: DEVELOPER BUILDER BUYER RELATIVE/FRIEND REALTOR CONSULTANT

PROPERTY LOCATION SUBDIVISION/PROPERTY NAME Patapsco Overlook LOT NO. 8

PROPERTY ADDRESS Old Frederick Rd. Lisbon

TAX MAP PAGE(S) 2 GRID 24 PARCEL(S) 32 PROPOSED LOT SIZE 1.14 Ac ±

AS APPLICANT, I UNDERSTAND THE FOLLOWING: THE SYSTEM INSTALLED SUBSEQUENT TO THIS APPLICATION IS ACCEPTABLE ONLY UNTIL PUBLIC SEWERAGE IS AVAILABLE. THIS APPLICATION IS COMPLETE WHEN ALL APPLICABLE FEES AND A SUITABLE SITE PLAN HAVE BEEN RECEIVED. I ACCEPT THE RESPONSIBILITY FOR COMPLIANCE WITH ALL M.O.S.H.A. AND "MISS UTILITY" REQUIREMENTS. APPROVAL IS BASED UPON SATISFACTORY REVIEW OF A PERC CERTIFICATION PLAN.

TEST RESULTS WILL BE MAILED TO APPLICANT. Melanie Rapp SIGNATURE OF APPLICANT


HOWARD COUNTY HEALTH DEPARTMENT, BUREAU OF ENVIRONMENTAL HEALTH, WELL AND SEPTIC PROGRAM
3525-H ELLICOTT MILLS DRIVE, ELLICOTT CITY, MARYLAND 21043-4544 (410) 313-1771 FAX (410) 313-2648
TDD (410) 313-2323 TOLL FREE 1-877-4MD-DHMH

AP

527
 Red wk' red org CLL
 4'
 yellow tan Loamy silt
 6'
 wk yellow wk org lt brn
 Loamy SAND
 sm Rxfraags ~10-15%
 BOTTOM 12'

526
 str org CLL
 1'
 org silt MASSIVE struct
 platy struct, org ybrn
 4'
 SAP begins
 v. fine S-Si
 v. v. weak sm frag
 sap. light blue, light org
 ~15-20%
 BOTTOM 12 1/2'

528
 Dense org CLL - silt
 4 1/2 - 5'
 lt brn S loam
 Rxfraags ~10-15%
 BOTTOM 12 1/2'

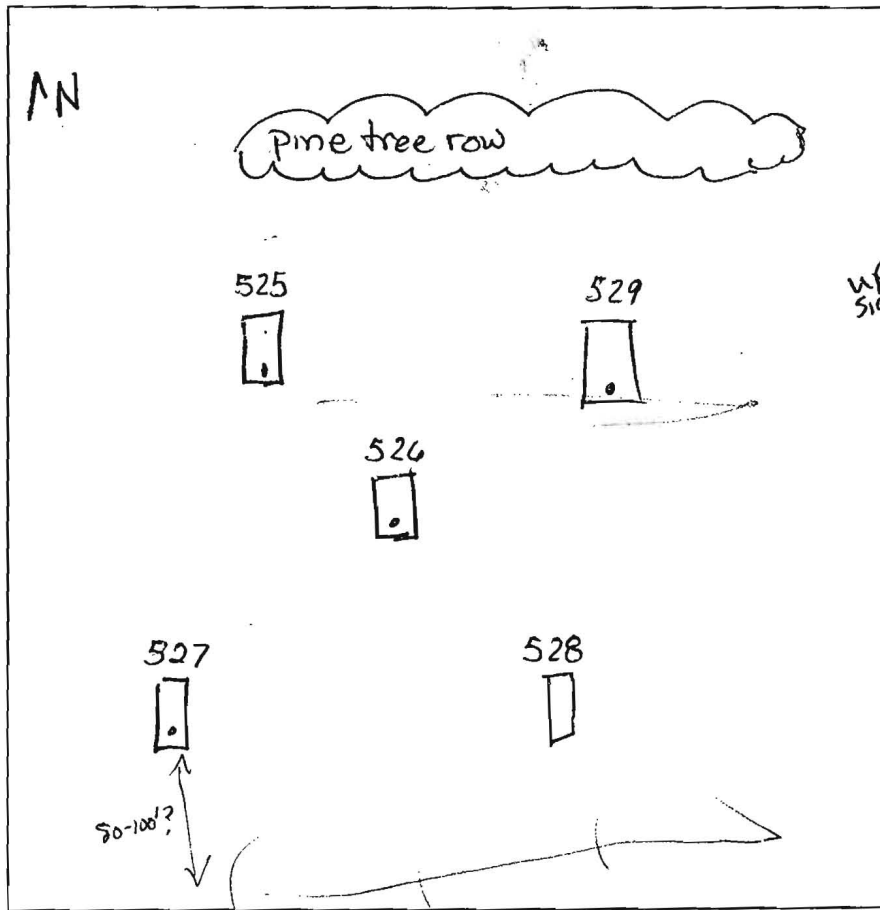

529
 Strong ybrn silt
 5'
 strong org L SAND
 4'
 w/kill side 7 1/2' to 9'
 ← 35-40% 2' x 2 1/2' pocket
 12' Bottom
525
 str ybrn packed silt
 4 1/2'
 lt brn brn fine LS-S
 SAP (solid) (sm. med) ~15% ±
 14' Bottom

DATE	TEST #	DEPTH	START	BREAK 1" DROP	STOP 2" DROP	TIME OF 2ND INCH	P/F/H
6/15/04	527	5 1/2'				22	P
	528	4 1/2'	9:21	9:26	9:38	12	P
	529	4' 8" S	9:28	9:31	9:36	5	P
	525	5' B	10:14	10:16	10:20	4	P

REMARKS Holes staked & dug per plan
 SANITARIAN Kacie BACKHOE Justin Brendel OTHERS _____
 TEST HOLES USED IN SDA _____ AVG. PERC TIME _____ SQ. FT/BR _____
 TRENCH WIDTH _____ INLET DEPTH _____ MAX. BOT DEPTH _____ EFFECTIVE SW _____

AGE &
SEMENT

LOT 9

GH B2

3.46'

R.L.

ATION

L B

()

±

GIC 2

PATAPSCO OVERLOOK
SECTION 1
LOTS 1 THRU 11
PLAT # 6718

LOT B



LOT 2
1.18 Ac±

LOT 3
1.14 Ac±

LOT 4
1.13 Ac±

LOT 5
1.12 Ac±

LOT 14
1.19 Ac±

LOT 13
1.20 Ac±

LOT 12
1.14 Ac±

LOT 6
1.14 Ac±

LOT 7
1.14 Ac±

PATAPSCO OVERLOOK
SECTION 2
LOTS 12 THRU 31
PLAT # 6733

5019257 & 5212105

EX. WELL

EX. WELL
HO-81-2085

EX. WELL

