

Building Permit Application

Howard County Maryland

Department of Inspections, Licenses and Permits

3430 Court House Drive

Permits: 410-313-2455

www.howardcountymd.gov

Date Received:	

	www.howardo	countymd.gov Permit No.:
uilding Address: 171 9/16	' Wheav wind CT	The second of th
	^	Property Owner's Name: SEFF + STLUITH MCKCCC Address: 12180 Studies DCT
ity: Execut at the tate:	<u>unD</u> Zip Code: 2100	City: (Citystate: UI) Zip Code: City
uite/Apt. #SDP	/WP/BA #:	Phone: Alo. 33 (143) Fax:
Census Tract:		Email:
	:Lot:	Applicant/s Name 9 Mailing Address (If ather they stated housin)
		Applicant's Name & Mailing Address, (If other than stated herein) Applicant's Name:
ax Map: Parcel:_	Grid:	Address:
oning: Map Coordinat	res: Lot Size:	City: State: Zip Code:
12-		Phone:Fax:
xisting Use: PHS Ferry		Email:
roposed Use: XSF	MENOT	Contractor Company: THE PAYLLEN DISHULYLLES
stimated Construction Cost: \$		Contact Person: PRFU SCHOOLING
	DEC EX. PAKEUFUTS	Address: 5305 MULLAGE CHATELDE.
<u> </u>		City: CLUMPIN State: UN Zip Code: ZICHCE
Cemorice 11 0107	GOUGF-W	License No. : 21664
Ex BATH		Phone: 410,645 Lug C4 Fax:
Occupant or Tenant:		Email:
Vas tenant space previously occupied?	Yes □No	Engineer/Architect Company:
		Responsible Design Prof.:
Address:		Address:
	State: Zip Code:	City:State:Zip Code:
hone:	_Fax:	Phone: Fax:
Email:		Email:
Commercial Building Characteristics	Residential Building Characteristics	Utilities
Height:		Water Supply
No. of stories:	Depth Width	Public Public
Gross area, sq. ft./floor:	1 st floor:	N Private
	2 nd floor:	
Area of construction (sq. ft.):	Basement: 1600 ST-	Sewage Disposal
	Finished Basement	Public
Use group:	☐ Unfinished Basement	☐ Private
	☐ Crawl Space	Electric: ☑Ýes □ No
Construction type:	☐ Slab on Grade	Gas: Yes 12/No
Reinforced Concrete	No. of Bedrooms:	300 S 100 S
☐ Structural Steel	Multi-family Dwelling	Heating System
☐ Masonry	No. of efficiency units:	☐ Électric ☐ Oil
□ Wood Frame	No. of 1 BR units:	☐ Natural Gas ☐ Propane Gas
State Certified Modular	No. of 2 BR units:	☐ Other:
	No. of 3 BR units:	Sprinkler System:
	Other Structure:	☐ Yes ☐ No
	Dimensions:	
Roadside Tree Project Permit	Footings:	Grading Permit Number:
□Yes □4No	Roof:	- Graung Ferritt Number:
Roadside Tree Project Permit #	State Certified Modular	All Public Claup with
	☐ Manufactured Home	Building Shell Permit Number:
THE UNDERSIGNED HEREBY CERTIFIES AND AGRI	EES AS FOLLOWS: (1) THAT HE/SHE IS AUTHORIZED T WHICH ARE APPLICABLE THERETO; (4) THAT HE/SHE	TO MAKE THIS APPLICATION; (2) THAT THE INFORMATION IS CORRECT; (3) THAT HE/SHE WILL COMP E WILL PERFORM NO WORK ON THE ABOVE REFERENCED PROPERTY NOT SPECIFICALLY DESCRIBED ROPERTY FOR THE PURPOSE OF INSPECTING THE WORK PERMITTED AND POSTING NOTICES.
THIS APPLICATION (15) THAT HE SHE GONNES CO		Print Name 1 1 -
Miller		
Madret	S,CEW	
Applicant's Signature Diet Suf NGC.	S,CEW	Print Name LISIT

PLEASE WRITE NEATLY & LEGIBLY
-FOR OFFICE USE ONLY-


AGENCY	DATE	SIGNATURE OF APPROVAL
State Highways		
Building Officials		8
PSZA (Zoning)		
PSZA (Engineering)	, , ,	0 0 0
Health	4/20/1	7 KBuck
Is Sediment Control app	roval require	ed for issuance? Yes No
☐ CONTINGENCY CONST	TRUCTION S	TART

ng)	11		۸	1
4	1/00/1	7 /	Buch	2.1
trol appro	val require	d for issua	ance? 🗆 Ye	s 🖸 No
Y CONSTR	UCTION ST	TART		

DPZ SETBACK INFORMATION				
Front:				
Rear:				
Side:				
Side St.:				
All minimum setbacks met?	☐ Yes	□No		
Is Entrance Permit Required?	☐ Yes	□No		
Historic District?	☐ Yes	□No		
Lot Coverage for New Town Zone:				
SDP/Red-line approval date:				

Filing Fee	\$
Permit Fee	\$
Tech Fee	\$
Excise Tax	\$
PSFS	\$
Guaranty Fund	\$
Add'l per Fee	\$
Total Fees	\$
Sub-Total Paid	\$
Balance Due	\$
Check	#



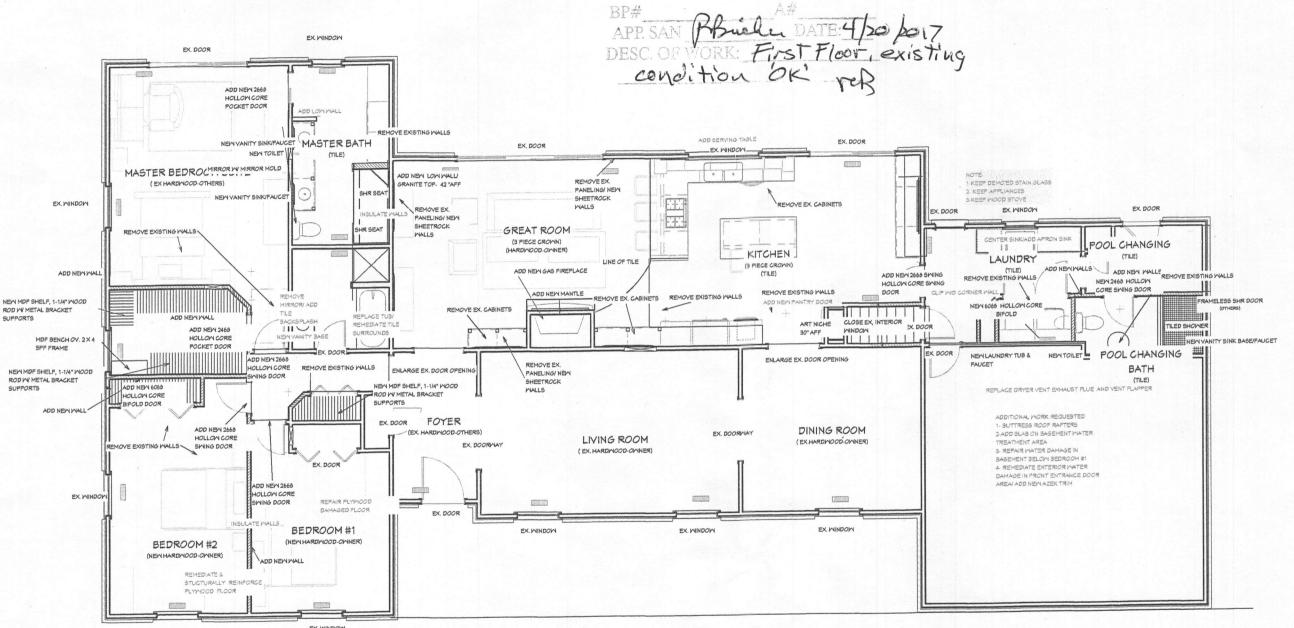

GLOBAL PLAN VIEW- 1/8"

3/16"= 1'-0"

BAYWOOD

