



Building Permit Application

Howard County Maryland
Department of Inspections, Licenses and Permits
3430 Court House Drive
Permits: 410-313-2455
www.howardcountymd.gov

Date Received: _____

Permit No.: _____

Building Address: 17535 Woodcamp Road
 City: Mount Airy State: MD Zip Code: 21771
 Suite/Apt. # _____ SDP/WP/BA #: _____
 Census Tract: _____ Subdivision: 0000
 Section: _____ Area: _____ Lot: 12
 Tax Map: 0007 Parcel: 0489 Grid: 0007
 Zoning: RL Map Coordinates: _____ Lot Size: 3.03 AC

Property Owner's Name: Jennifer & Richard Lawhorne
 Address: 17535 Woodcamp Road
 City: Mount Airy State: MD Zip Code: 21771
 Phone: 410-432-0528 Fax: _____
 Email: ADEYLA13@yahoo.com
 Applicant's Name & Mailing Address, (If other than stated herein)
 Applicant's Name: Same
 Address: _____
 City: _____ State: _____ Zip Code: _____
 Phone: _____ Fax: _____
 Email: _____

Existing Use: _____
 Proposed Use: horse shelter, storage
 Estimated Construction Cost: \$ 15,000
 Description of Work: 12' x 36' Barn with 10' x 36' Lean-to/overhang. (pre-built & dropped off)
 Occupant/Tenant Name: _____
 Was tenant space previously occupied? Yes No
 Contact Name: _____
 Address: _____
 City: _____ State: _____ Zip Code: _____
 Phone: _____ Fax: _____
 Email: _____

Contractor Company: Amish Customs
 Contact Person: Dave Bingham
 Address: 13109 Old National Pike
 City: Mount Airy State: MD Zip Code: 21771
 License No.: _____
 Phone: 301-607-8284 Fax: _____
 Email: _____

Engineer/Architect Company: _____
 Responsible Design Prof.: _____
 Address: _____
 City: _____ State: _____ Zip Code: _____
 Phone: _____ Fax: _____
 Email: _____

Commercial Building Characteristics	Residential Building Characteristics	
Height:	<input type="checkbox"/> SF Dwelling <input type="checkbox"/> SF Townhouse	
No. of stories:	Depth	Width
Gross area, sq. ft./floor:	1 st floor:	
	2 nd floor:	
Area of construction (sq. ft.):	Basement:	
	<input type="checkbox"/> Finished Basement	
Use group:	<input type="checkbox"/> Unfinished Basement	
	<input type="checkbox"/> Crawl Space	
Construction type:	<input type="checkbox"/> Slab on Grade	
<input type="checkbox"/> Reinforced Concrete	No. of Bedrooms:	
<input type="checkbox"/> Structural Steel	Multi-family Dwelling	
<input type="checkbox"/> Masonry	No. of efficiency units:	
<input checked="" type="checkbox"/> Wood Frame	No. of 1 BR units:	
<input type="checkbox"/> State Certified Modular	No. of 2 BR units:	
	No. of 3 BR units:	
	Other Structure:	
	Dimensions:	
<input checked="" type="checkbox"/> Roadside Tree Project Permit	Footings:	
<input type="checkbox"/> Yes <input type="checkbox"/> No	Roof:	
Roadside Tree Project Permit #	<input type="checkbox"/> State Certified Modular	
	<input type="checkbox"/> Manufactured Home	

Utilities		
Electric:	<input checked="" type="checkbox"/> Yes <input type="checkbox"/> No	
Gas:	<input type="checkbox"/> Yes <input type="checkbox"/> No	
Water Supply		
<input type="checkbox"/> Public		
<input checked="" type="checkbox"/> Private		
Sewage Disposal		
<input type="checkbox"/> Public		
<input checked="" type="checkbox"/> Private		
Heating System		
<input type="checkbox"/> Electric <input type="checkbox"/> Oil		
<input type="checkbox"/> Natural Gas <input type="checkbox"/> Propane Gas		
<input type="checkbox"/> Other:		
Sprinkler System:		
<input type="checkbox"/> Yes <input type="checkbox"/> No		
Grading Permit Number:		
Building Shell Permit Number:		

* No utilities to Barn *

THE UNDERSIGNED HEREBY CERTIFIES AND AGREES AS FOLLOWS: (1) THAT HE/SHE IS AUTHORIZED TO MAKE THIS APPLICATION; (2) THAT THE INFORMATION IS CORRECT; (3) THAT HE/SHE WILL COMPLY WITH ALL REGULATIONS OF HOWARD COUNTY WHICH ARE APPLICABLE THERETO; (4) THAT HE/SHE WILL PERFORM NO WORK ON THE ABOVE REFERENCED PROPERTY NOT SPECIFICALLY DESCRIBED IN THIS APPLICATION; (5) THAT HE/SHE GRANTS COUNTY OFFICIALS THE RIGHT TO ENTER ONTO THIS PROPERTY FOR THE PURPOSE OF INSPECTING THE WORK PERMITTED AND POSTING NOTICES.

Applicant's Signature: Jennifer Lawhorne
 Email Address: AdeyLA13@yahoo.com
 Title/Company: _____

Print Name: Jennifer Lawhorne
 Date: 5/30/17

Checks Payable to: DIRECTOR OF FINANCE OF HOWARD COUNTY
 PLEASE WRITE NEATLY & LEGIBLY
 FOR OFFICE USE ONLY

AGENCY	DATE	SIGNATURE OF APPROVAL
State Highways		
Building Officials		
PSZA (Zoning)		
PSZA (Engineering)		
Health	<u>5/30/17</u>	<u>H. Oswald</u>

Is Sediment Control approval required for issuance? Yes No
 CONTINGENCY CONSTRUCTION START


DPZ SETBACK INFORMATION
Front:
Rear:
Side:
Side St.:
All minimum setbacks met? <input type="checkbox"/> Yes <input type="checkbox"/> No
Is Entrance Permit Required? <input type="checkbox"/> Yes <input type="checkbox"/> No
Historic District? <input type="checkbox"/> Yes <input type="checkbox"/> No
Lot Coverage for New Town Zone:
SDP/Red-line approval date:

Filing Fee	\$
Permit Fee	\$
Tech Fee	\$
Excise Tax	\$
PSFS	\$
Guaranty Fund	\$
Add'l per Fee	\$
Total Fees	\$
Sub- Total Paid	\$
Balance Due	\$
Check	#

17535 WOODCAMP ROAD

1" = 100' scale

PLOT PLAN

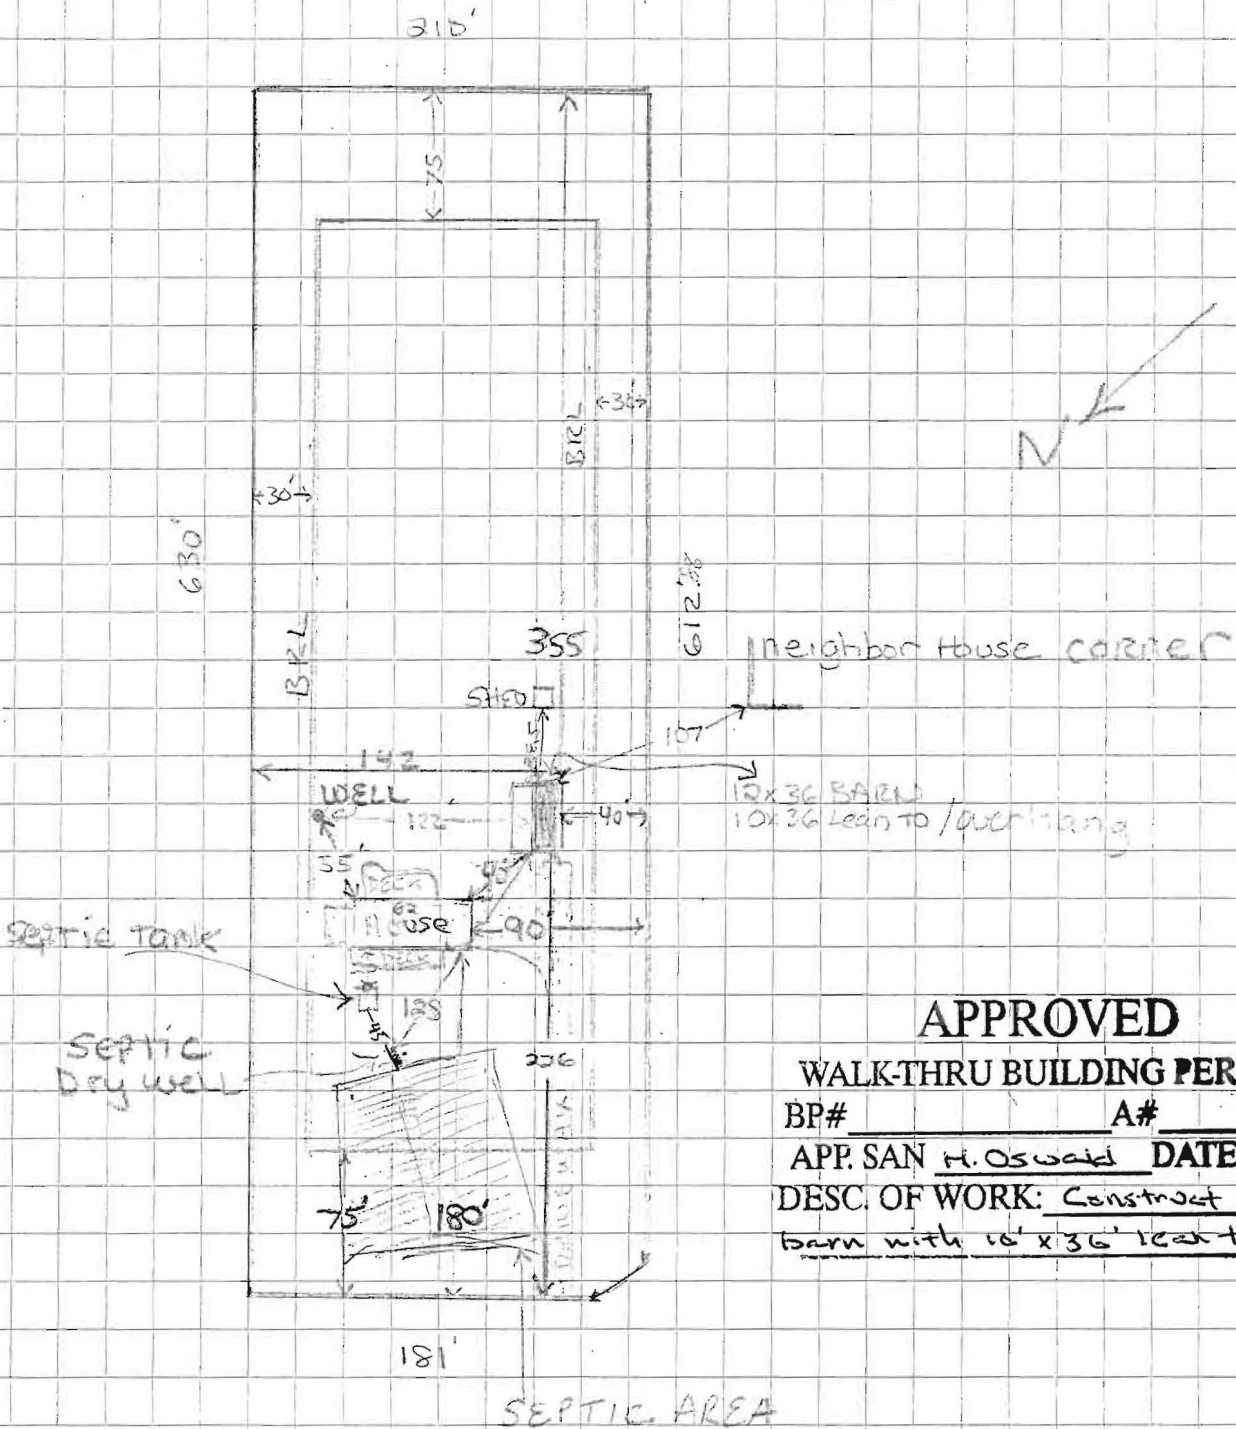

APPROVED

WALK-THRU BUILDING PERMIT

BP# _____ A# _____

APP. SAN H. Oswald DATE: 5/31/17

DESC. OF WORK: Construct 12' x 36'
barn with 10' x 36' lean to / overhang

COORDINATE SCHEDULE		
NO.	NORTH	EAST
1	3115.040	6701.939
2	3457.347	7372.136
3	3201.282	7904.686
4	3174.541	7892.100
5	2413.466	7536.712
6	1902.948	7298.259
7	1640.193	7189.716
8	805.338	6819.776
9	544.083	6705.887
10	805.337	6637.879
11	1476.025	6463.255
12	2065.913	5935.392
13	2465.278	6024.204
14	2811.783	6256.150
15	3751.581	6695.114
16	3644.541	6898.104
17	3475.831	7254.238
18	3442.651	7266.263
19	2701.239	6920.602
20	2537.214	6843.092
21	1523.859	6828.556
22	2447.333	6802.911
23	1425.645	6888.960
24	2516.054	6889.293


CURVE DATA											
NO.	RADIUS	LENGTH	TANGENT	Δ	CHORD BEARING & DISTANCE	NO.	RADIUS	LENGTH	TANGENT	Δ	CHORD BEARING & DISTANCE
15-16	2630.00'	229.56'	114.85'	05°00'24"	S62°11'47"E 229.48'						
20-21	25.00'	21.03'	11.18'	48°11'24"	N45°08'02"E 20.41'						
21-23	50.00'	24.11'	11.18'	27°22'48"	S76°22'48"E 20.41'						
23-24	25.00'	21.03'	11.18'	48°11'24"	S00°56'04"W 20.41'						

25	2634.456	6888.000
26	3421.067	7312.006
27	3433.988	7945.343

LOT 1
WOODCAMP FARM
PLAT 4243

AREA TABULATIONS

TOTAL NUMBER OF LOTS : 13
 TOTAL AREA OF LOTS : 66.449 AC.
 TOTAL AREA OF RIGHT OF WAY DED. : 2.413 AC.
 TOTAL AREA OF FLOOD PLAIN : 10.758 AC.
 TOTAL AREA OF SUBDIVISION : 68.862 AC.

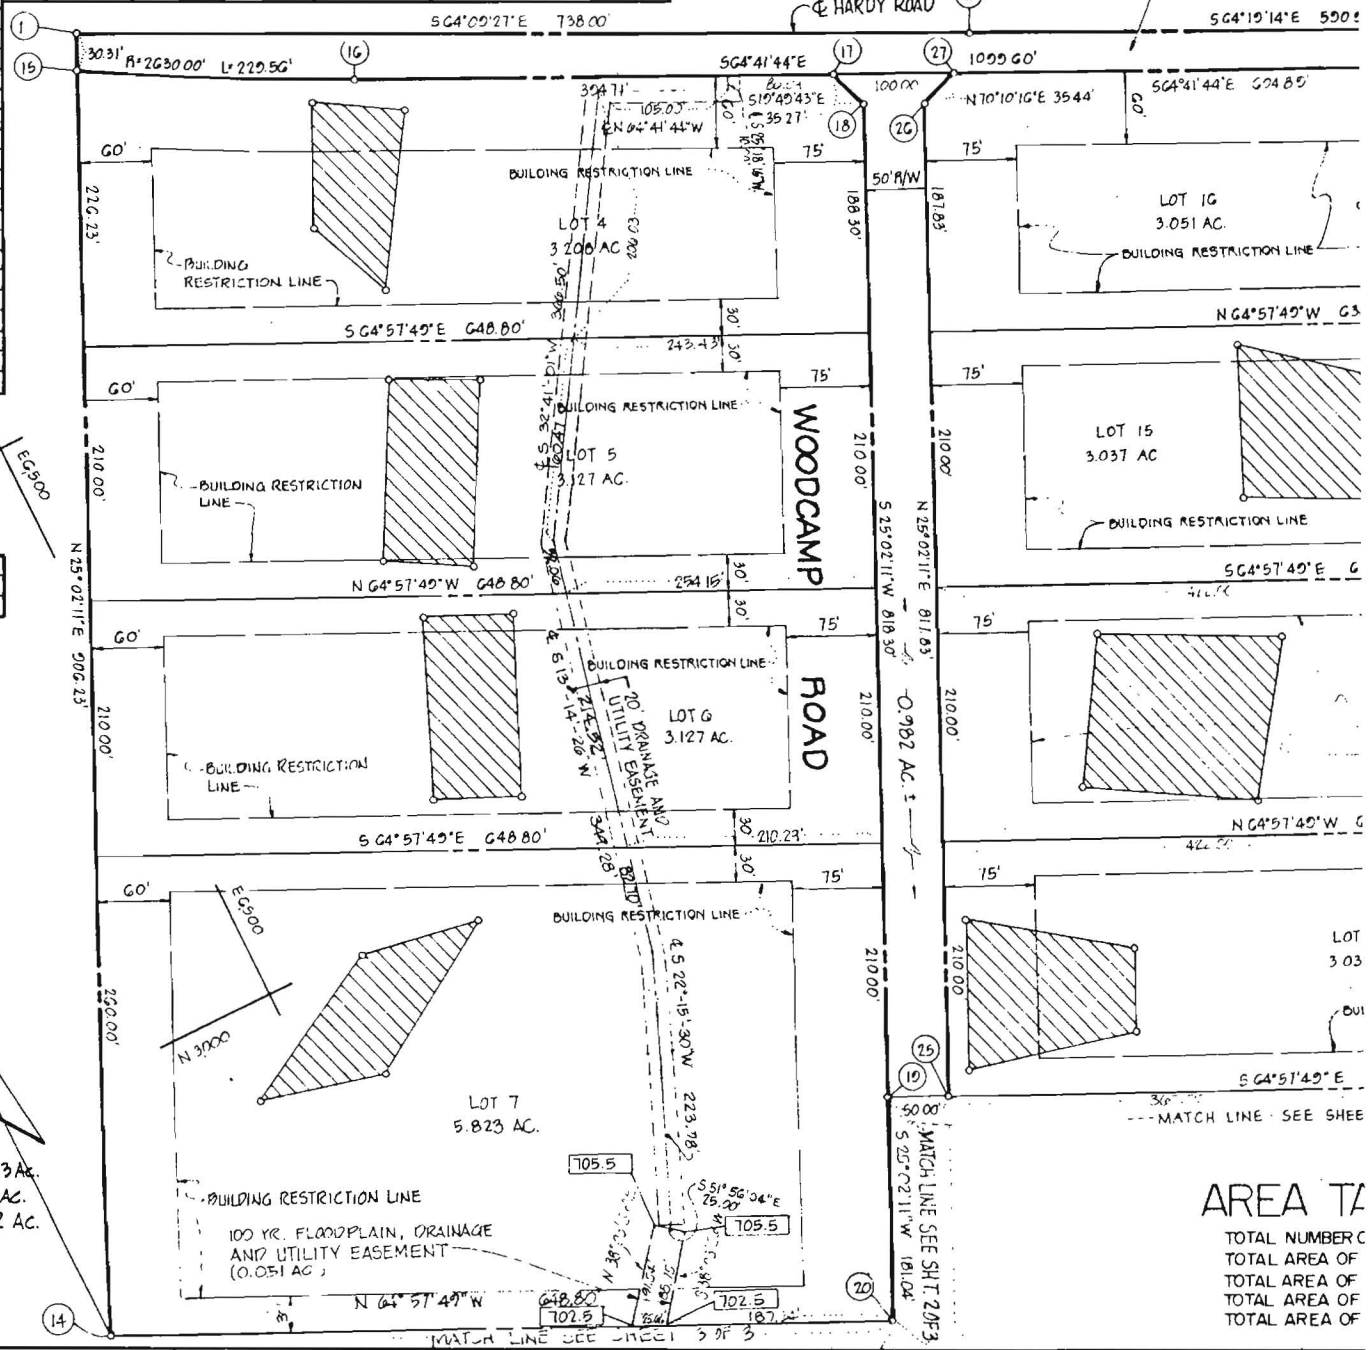

AREA TA

TOTAL NUMBER C
 TOTAL AREA OF
 TOTAL AREA OF
 TOTAL AREA OF
 TOTAL AREA OF

