



Building Permit Application

Howard County Maryland
Department of Inspections, Licenses and Permits
3430 Court House Drive
Permits: 410-313-2455
www.howardcountymd.gov

DILP 2017 AUG 18 AMB
Date Received: _____

Permit No.: B17003114

Building Address: 2442 Woodstream Ct
City: Ellicott City State: MD Zip Code: 21042
Suite/Apt. #: _____ SDP/WP/BA #: _____
Census Tract: _____ Subdivision: _____
Section: _____ Area: _____ Lot: _____
Tax Map: _____ Parcel: _____ Grid: _____
Zoning: _____ Map Coordinates: _____ Lot Size: _____
Existing Use: SFD
Proposed Use: Storage
Estimated Construction Cost: \$ 8000 5000
Description of Work: SHED 12x24 = 336
12x20 = 240 8/11 NRH
Occupant/Tenant Name: _____
Was tenant space previously occupied? ☐ Yes ☐ No
Contact Name: _____
Address: _____
City: _____ State: _____ Zip Code: _____
Phone: _____ Fax: _____
Email: _____

Property Owner's Name: Napoleon Pinos
Address: 2442 Woodstream Ct
City: Ellicott City State: MD Zip Code: 21042
Phone: 443 540 8577 Fax: _____
Email: NPINOS@HOTMAIL.COM
Applicant's Name & Mailing Address, (If other than stated herein)
Applicant's Name: _____
Address: _____
City: _____ State: _____ Zip Code: _____
Phone: _____ Fax: _____
Email: _____
Contractor Company: self
Contact Person: _____
Address: _____
City: _____ State: _____ Zip Code: _____
License No.: MAHPC
Phone: 443 540 8577 Fax: _____
Email: _____
Engineer/Architect Company: _____
Responsible Design Prof.: _____
Address: _____
City: _____ State: _____ Zip Code: _____
Phone: _____ Fax: _____
Email: _____

Commercial Building Characteristics	Residential Building Characteristics
Height:	☐ SF Dwelling ☐ SF Townhouse
No. of stories:	Depth Width
Gross area, sq. ft./floor:	1 st floor:
	2 nd floor:
Area of construction (sq. ft.):	Basement:
	☐ Finished Basement
Use group:	☐ Unfinished Basement
	☐ Crawl Space
Construction type:	☐ Slab on Grade
☐ Reinforced Concrete	No. of Bedrooms:
☐ Structural Steel	Multi-family Dwelling
☐ Masonry	No. of efficiency units:
☐ Wood Frame	No. of 1 BR units:
☐ State Certified Modular	No. of 2 BR units:
	No. of 3 BR units:
	Other Structure:
	Dimensions:
➤ Roadside Tree Project Permit	Footings:
☐ Yes ☒ No	Roof:
Roadside Tree Project Permit #	☐ State Certified Modular
	☐ Manufactured Home

Utilities
Electric: ☐ Yes ☒ No
Gas: ☐ Yes ☒ No
Water Supply
☐ Public
☒ Private
Sewage Disposal
☐ Public
☒ Private
Heating System
☐ Electric ☐ Oil
☐ Natural Gas ☐ Propane Gas
☐ Other:
Sprinkler System:
☐ Yes ☐ No
Grading Permit Number:
Building Shell Permit Number:

THE UNDERSIGNED HEREBY CERTIFIES AND AGREES AS FOLLOWS: (1) THAT HE/SHE IS AUTHORIZED TO MAKE THIS APPLICATION; (2) THAT THE INFORMATION IS CORRECT; (3) THAT HE/SHE WILL COMPLY WITH ALL REGULATIONS OF HOWARD COUNTY WHICH ARE APPLICABLE THERETO; (4) THAT HE/SHE WILL PERFORM NO WORK ON THE ABOVE REFERENCED PROPERTY NOT SPECIFICALLY DESCRIBED IN THIS APPLICATION; (5) THAT HE/SHE GRANTS COUNTY OFFICIALS THE RIGHT TO ENTER ONTO THIS PROPERTY FOR THE PURPOSE OF INSPECTING THE WORK PERMITTED AND POSTING NOTICES.

Applicant's Signature: [Signature]
Email Address: npinos@howardcountymd.gov
Title/Company: _____

Print Name: Napoleon Pinos
Date: 8/18/17
RECEIVED
AUG 18 2017

Checks Payable to: DIRECTOR OF FINANCE OF HOWARD COUNTY

PLEASE WRITE NEATLY & LEGIBLY

-FOR OFFICE USE ONLY-

AGENCY	DATE	SIGNATURE OF APPROVAL
State Highways		
Building Officials		
PSZA (Zoning)		
PSZA (Engineering)		
Health		
Is Sediment Control approval required for issuance? ☐ Yes ☐ No		
☐ CONTINGENCY CONSTRUCTION START		

DPZ SETBACK INFORMATION
Front:
Rear:
Side:
Side St.:
All minimum setbacks met? ☐ Yes ☐ No
Is Entrance Permit Required? ☐ Yes ☐ No
Historic District? ☐ Yes ☐ No
Lot Coverage for New Town Zone:
SDP/Red-line approval date:

Filing Fee	\$
Permit Fee	\$ 50
Tech Fee	\$ 5
Excise Tax	\$
PSFS	\$
Guaranty Fund	\$
Add'l per Fee	\$
Total Fees	\$ 55.00
Sub- Total Paid	\$
Balance Due	\$
Check	# 334

Distribution of Copies: White: Building Officials Green: PSZA,Zoning Yellow: PSZA,Engineering Pink: Health Gold: SHA

RECORD PLAT 4646
ZONING: R

REVISED

Date: 8/23/77

Comments:

Revised to show
30' set back

Approved Sept. System Plan
Howard County Health Department

100 Year Flood Plain & Drainage Easement

Revised location of shed
approved
Date 9/17/77

APPROVED
WALK-THRU BUILDING PERMIT
DATE: 8/11/77

on gravel pad
10' or more from SDA

Original elev. at time
of perk test 534.0

Exist. elev. 534.0

Distribution box
inlet elev. 531.0

Invert elev. out
of septic tank 531.2

Exist. elev. at
septic tank 534.5

Invert elev. into
septic tank 531.7

Invert elev. out
of house 532.9

Sewage
Disposal
Easement

2 Trenches @ 10' ea.

Drive 60' ER.

90'

30'

40'

22'

15'

12'

10'

8'

6'

4'

2'

1'

0'

0'

LOT 8

LOT 9

LOT 10

LOT 11

LOT 12

LOT 13

LOT 14

LOT 15

LOT 16

LOT 17

LOT 18

LOT 19

LOT 20

LOT 21

LOT 22

LOT 23

Water Well
Exist Elev.
545'

Sewage
Disposal
Easement

Stair & Stoop.
1st Fl. Elev. 542.17

Basement Elev. 534.0

(Rad. 250.00
Arc. 152.35)

50'

PREPARED FOR:

INTERSTATE BUILDING CONTRACTORS, INC.

THEODORE F. STROMBERG, PRES.

TEL. (301) 465-5500

9267 BALTIMORE NATIONAL PIKE, ELLICOTT CITY, MD. 21043

I certify the above measurements & elevs. are actual & correct for this prop.

Werner Klotzli, Jr. P.E. REG. NO. 7934

SITE PLAN

2442 WOOD STREAM CT.

LOT 6, SANDY HILL ESTATES, 3RD ELECT. DIST., HOWARD CO., MD.

WERNER KLOTZLI, JR., P.E.

SITE PLANNER & CIVIL ENGINEER

4006 CHATHAM RD., ELLICOTT CITY, MD. 21043


TEL. (301) 465-3912

SCALE
1" = 100'

DATE
7/24/84

JOB NO.
84-11

RECORD PLAT 4646
ZONING: R

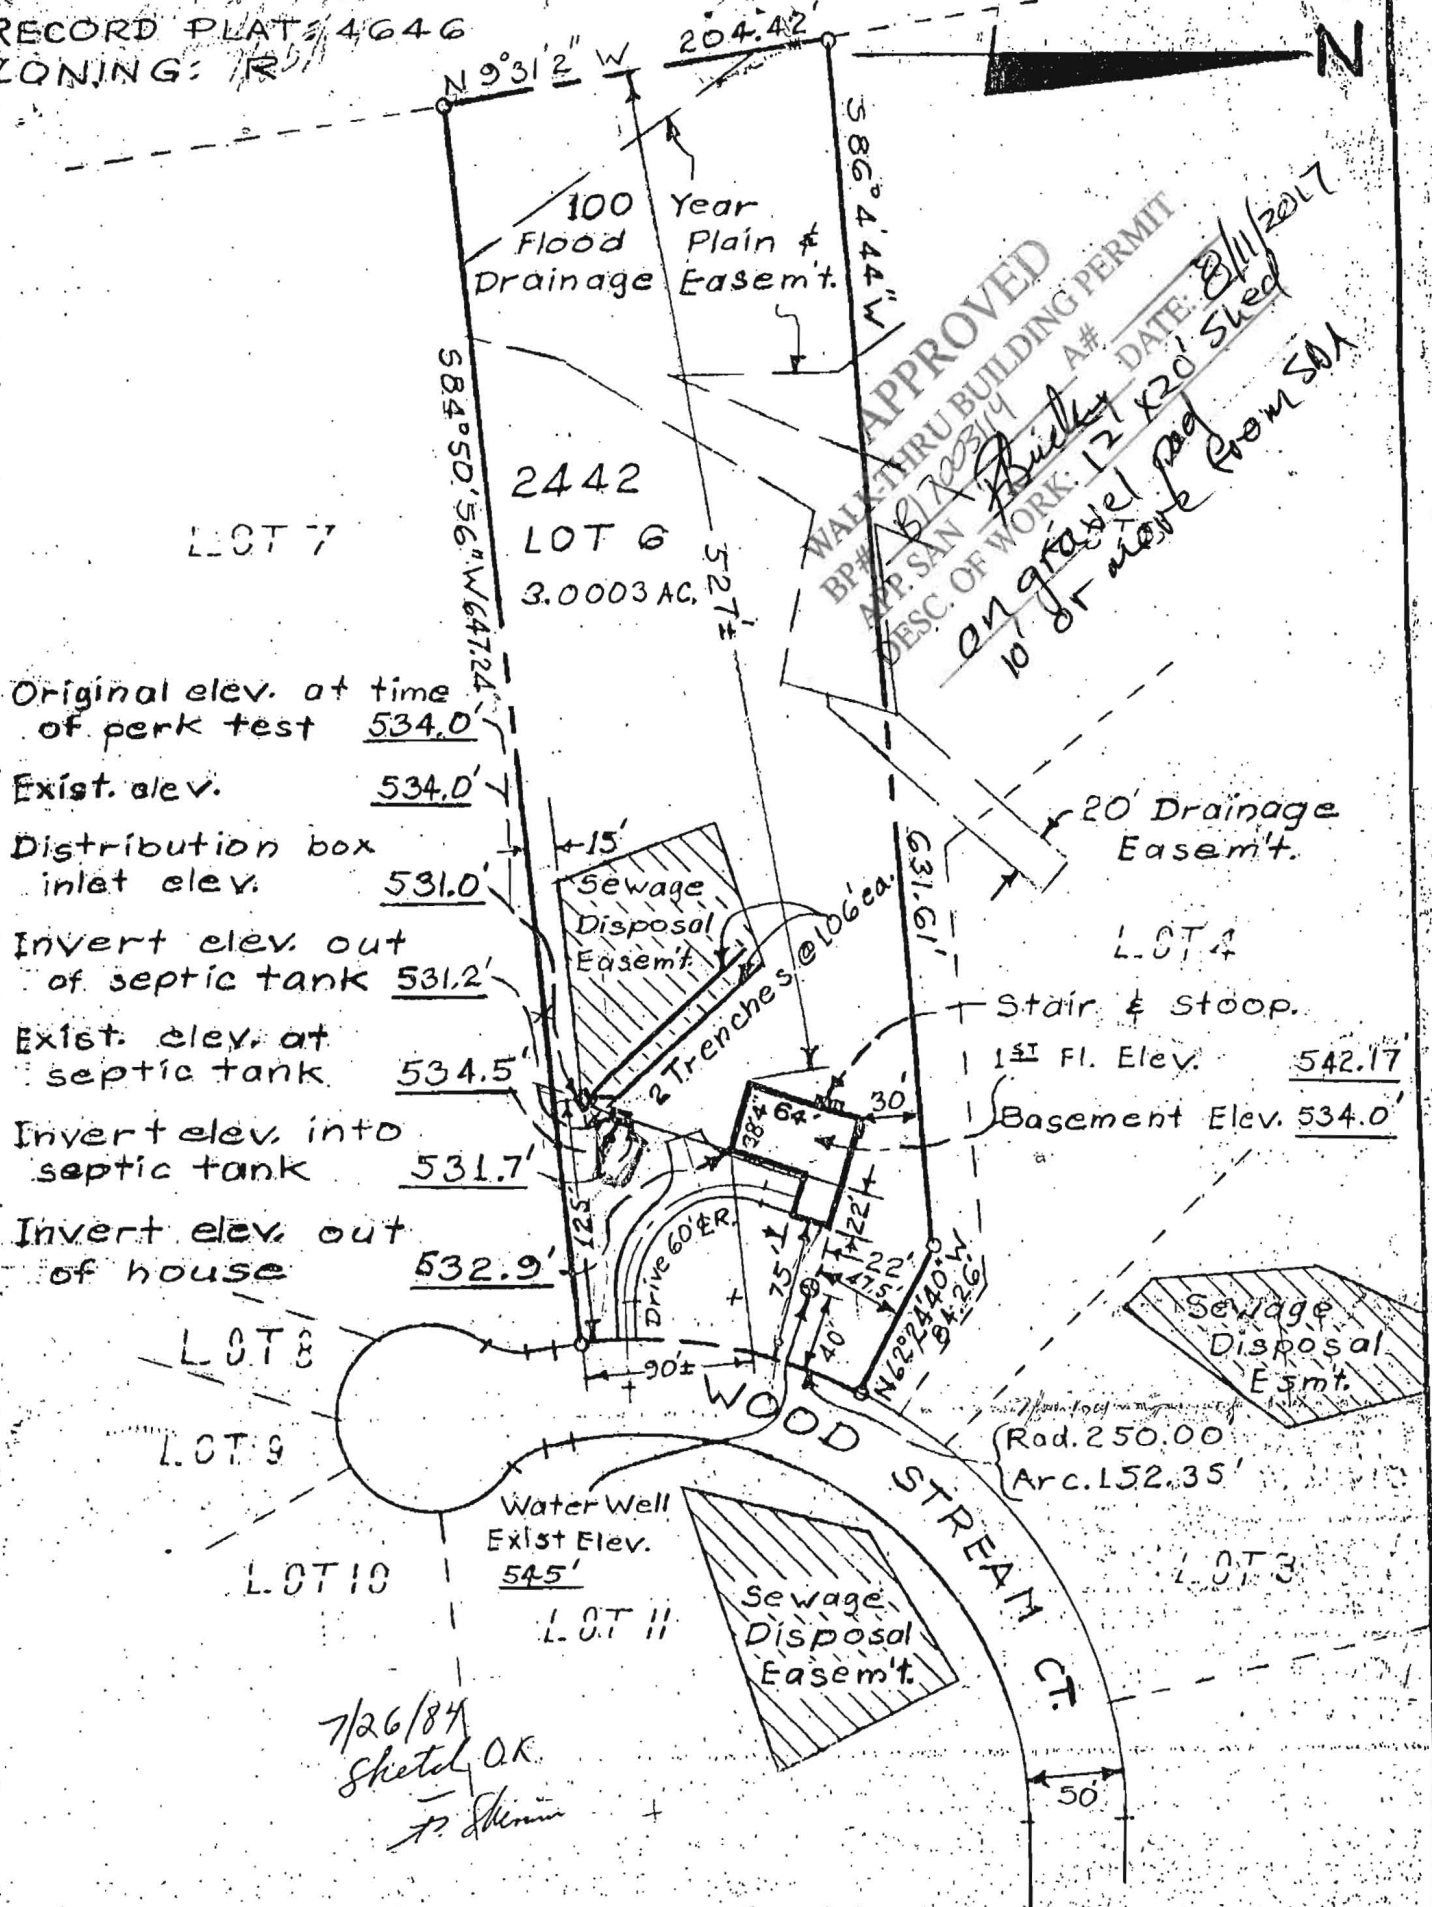

PREPARED FOR:

INTERSTATE BUILDING CONTRACTORS, INC.

THEODORE F. STROMBERG, PRES.

TEL. (301) 465-3500

9267 BALTIMORE NATIONAL PIKE, ELLICOTT CITY, MD. 21043

I certify the above measurements & elevs. are actual & correct for this prop.

Werner Klotzli, Jr. P.E. REG. NO. 7934

SITE PLAN

2442 WOOD STREAM CT.

LOT 6, SANDY HILL ESTATES, 3RD ELECT. DIST, HOWARD CO., MD.

WERNER KLOTZLI, JR., P.E.

SITE PLANNER & CIVIL ENGINEER

4006 CHATHAM RD., ELLICOTT CITY, MD. 21043

TEL. (301) 465-3912

SCALE
1"=100'

DATE
7/24/84

JOB NO.
84-11