

LAYOUT \_\_\_\_\_ INSP 4 \_\_\_\_\_

INSP 2 \_\_\_\_\_ INSP 5 \_\_\_\_\_

INSP 3 \_\_\_\_\_ INSP 6 \_\_\_\_\_

ISSUE DATE: \_\_\_\_\_

APPROVAL DATE: \_\_\_\_\_

**PERMIT  
INDEXED**

P \_\_\_\_\_

A 518044-A \_\_\_\_\_

**ON-SITE SEWAGE DISPOSAL SYSTEM  
HOWARD COUNTY HEALTH DEPARTMENT  
BUREAU OF ENVIRONMENTAL HEALTH**

**04-326385**

IS PERMITTED TO INSTALL  ALTER

ADDRESS: \_\_\_\_\_ PHONE NUMBER: \_\_\_\_\_

SUBDIVISION: ELLICOTT FARM LOT NUMBER: 9-C

ADDRESS: 3620 WOODBINE ROAD PROPERTY OWNER: ERIC BRODERICK

SEPTIC TANK CAPACITY (GALLONS): \_\_\_\_\_ OUTLET BAFFLE FILTER REQUIRED

PUMP CHAMBER CAPACITY (GALLONS): \_\_\_\_\_ COMPARTMENTED TANK REQUIRED

NUMBER OF BEDROOMS: \_\_\_\_\_

SQUARE FEET PER BEDROOM: \_\_\_\_\_

LINEAR FEET OF TRENCH REQUIRED: \_\_\_\_\_

TRENCHES:	Trench to be _____ feet wide. Inlet _____ feet below original grade. Bottom maximum depth _____ feet below original grade. Effective area begins at _____ feet below original grade. _____ feet of stone below distribution pipe.
LOCATION:	_____
NOTES:	_____

PLANS APPROVED: \_\_\_\_\_ DATE: \_\_\_\_\_

NOTE: PERMIT VOID AFTER 2 YEARS

NOTE: CONTRACTOR RESPONSIBLE FOR SCHEDULING A PRE-CONSTRUCTION INSPECTION FOR ALL INSTALLATIONS

NOTE: WATERTIGHT SEPTIC TANKS REQUIRED

NOTE: ALL PARTS OF SEPTIC SYSTEM SHALL BE 100 FEET FROM ANY WATER WELL

NOTE: MANHOLE RISERS REQUIRED ON ALL SEPTIC TANKS AND PUMP CHAMBERS UNLESS SPECIFICALLY AUTHORIZED

**NEITHER THE HOWARD COUNTY COUNCIL NOR THE HEALTH DEPARTMENT IS  
RESPONSIBLE FOR THE SUCCESSFUL OPERATION OF ANY SYSTEM  
PERMITTEE RESPONSIBLE FOR OBTAINING FINAL APPROVAL ON THIS PERMIT  
CALL 410-313-2640 FOR INSPECTION OF SEPTIC SYSTEM**

**BUILDING PERMIT SIGNED  
AND RETURNED**

12/26/02 B00139812A GARAGE

# PERMIT

SEWAGE DISPOSAL SYSTEM

MARYLAND STATE DEPARTMENT OF HEALTH

29834

A1506

HOWARD COUNTY

ELLICOTT CITY

DISTRICT 028

INDEXED

DATE 9/22/76

Roland Barth

IS PERMITTED TO INSTALL & ALTER

ADDRESS

PHONE

DIVISION (Ellicott Park)

ROAD 2670 Road 94

LOT 9C

PROPERTY OWNER Leo Walder, Jr.

ADDRESS 9106 N. Two & Country Blvd., Ellicott City, Md.

SPECIFICATIONS 3 bedrooms

SEPTIC TANK CAPACITY 1000 GALLONS

DRAIN FIELD DEPTH FEET. BOTTOM AREA SQ. FT.

DEEP TRENCH DEPTH FEET. BOTTOM AREA SQ. FT.

SEEPAGE PITS ABSORBENT SIDE-WALL AREA SQ. FT.

INLET PIPE FT. BELOW ORIGINAL GRADE. MAXIMUM DEPTH FT. BELOW ORIGINAL GRADE

EFFECTIVE DEPTH AT FT. BELOW ORIGINAL GRADE

LOCATE DISPOSAL AREA FT. FROM LOT LINE AND FT. FROM LOT LINE AS SEEN WHEN

FACING LOT FROM

TRENCHES—Two trenches, each trench 75 ft. long, 4 ft. deep, 2 ft. wide, and contain 4 ft. of stone under pipe. Start first trench 150 ft. from front lot line and 84 ft. from left side line as seen when facing from the front. Start second trench 12 ft. to right of trench #1. Trenches to run towards rear lot line and follow contour. CALL FOR INSPECTION OF TRENCHES BEFORE GRAVEL IS INSTALLED.

PERMITS APPROVED BY Donald W. Housheer

DATE 9/9/76

NO WORK UNTIL INSPECTED AND APPROVED.

EITHER THE HOWARD COUNTY COUNCIL NOR THE HEALTH DEPARTMENT IS RESPONSIBLE FOR THE SUCCESSFUL OPERATION OF ANY SYSTEM.

IF TRENCH IS USED CALL FOR INSPECTION BEFORE PLACING GRAVEL IN TRENCH.

NO DRY WELL SHALL EXCEED 16 FOOT IN DIAMETER

ALL PIPE FROM HOUSE TO DISPOSAL AREA MUST BE CAST IRON.

PERMIT VOID AFTER THREE YEARS.

INSTALL STAND PIPE ON SEPTIC TANK AND DRY WELL. STAND PIPES MUST BE 6 INCHES IN DIAMETER. CAST IRON, CONCRETE OR TERRAZO COTTA ACCEPTED.


INSTALLER IS RESPONSIBLE FOR OBTAINING FINAL APPROVAL ON THIS PERMIT.

BLDG. PERMIT SIGNED AND RETURNED

4/10/85 Serial # 6487 Paul

19046

03350  
1550

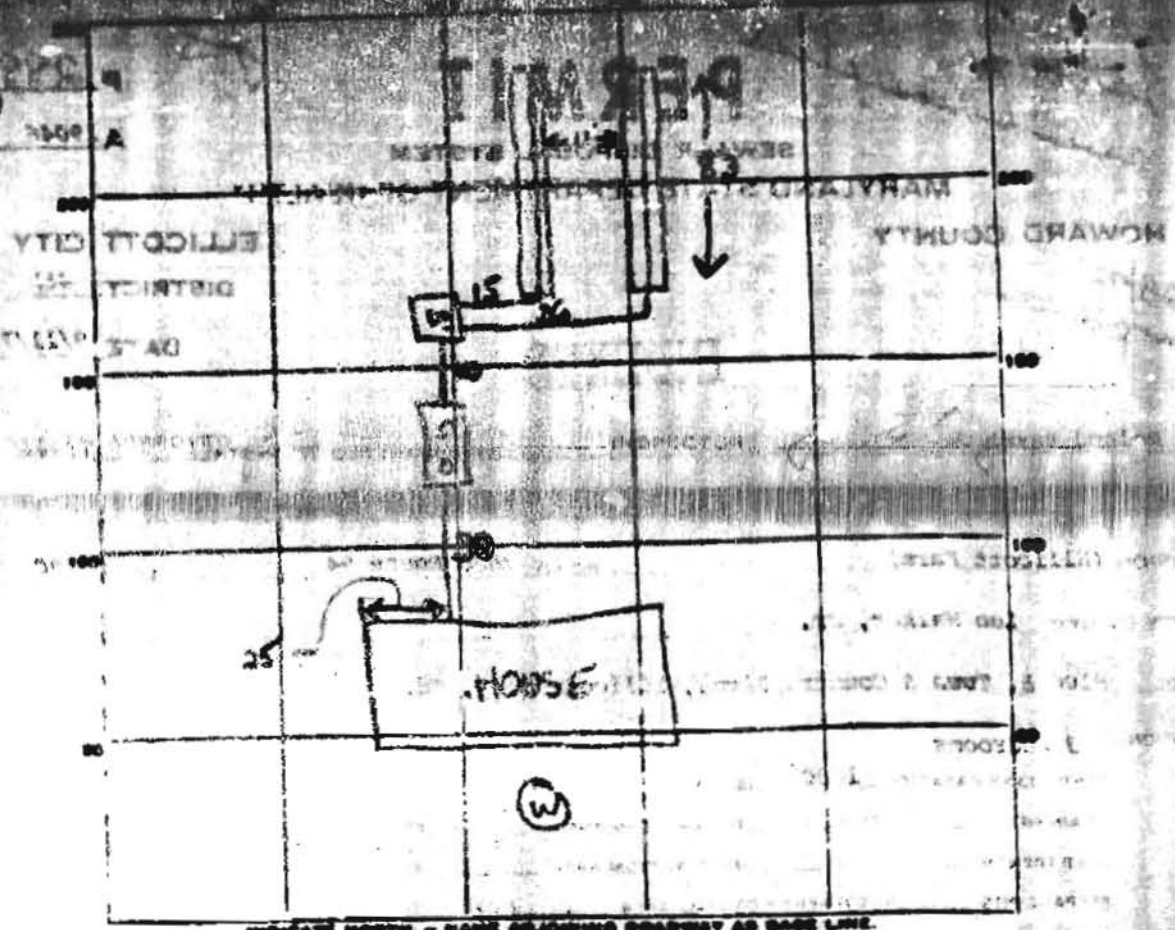

RT 94

PERMIT CARD 11/23/78

DEPTH TANK LEVEL 8 FT CLEANOUTS 5T terra cotta

DISTRIBUTION BOX LEVEL 2.42 x 1

TILE FIELD DEPTH 8 FT. TRENCH WIDTH 2 FT.

GRAVEL DEPTH 4 FT. TOTAL LENGTH 166 FT.

NUMBER OF TRENCHES 2 TOTAL BOTTOM AREA 664

SEEPAGE PITS, INSIDE DIAMETER \_\_\_\_\_ FT. DEPTH BELOW RILEY \_\_\_\_\_ FT.

ABSORBENT AREA 664 SQ. FT.

REMARKS 20 2/78 - Call for final when gravel is added to trench

23 00/78 - continue work on trench OK to backfill from house to

23 00/78 - FINAL OK

INSPECTOR J. Stager

