



B 1 2142 SEQUENCE NO. (DP USE ONLY)  
(THIS NUMBER IS TO BE PUNCHED IN COLS. 3-6 ON ALL CARDS)


STATE OF MARYLAND PERMIT TO DRILL WELL please print or type

STATE PERMIT NUMBER 40-88-1073  
fill in this form completely

Date Received (APA) 091289  
OWNER INFORMATION  
Last Name: SOHMS, M; Owner: Jennifer  
Street or RFD: ELLICOTT CITY MD 21043  
Town: ELLICOTT CITY; State: MD; Zip: 21043

B 3 LOCATION OF WELL  
8 COUNTY: HOWARD  
23 SUBDIVISION: KING'S GIFT  
SECTION: 44 46; LOT: 48 50  
52 NEAREST TOWN: ELLICOTT CITY  
MILES FROM TOWN: 3 MI

DRILLER INFORMATION  
Driller's Name: D A DiCicco; License No. 80: 429  
Firm Name: TRI STATE EXPLOSIVES, INC.  
Address: P.O. Box 34300 Bethesda, MD. 20817  
Signature: D A DiCicco; Date: 9-5-89

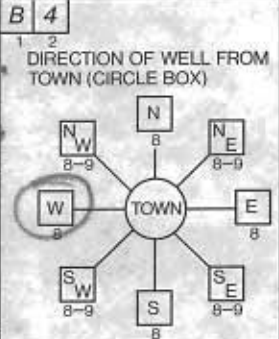

B 4 DIRECTION OF WELL FROM TOWN (CIRCLE BOX)  
NEAR WHAT ROAD: 11746 RT 144  
ON WHICH SIDE OF ROAD (CIRCLE APPROPRIATE BOX): NORTH  
DISTANCE FROM ROAD: 34 100 37 FT OR MI  
ENTER FT OR MI: FF

B 2 WELL INFORMATION  
APPROX. PUMPING RATE (GAL. PER MIN.): 5  
AVERAGE DAILY QUANTITY NEEDED (GAL. PER DAY): 600

NOT TO BE FILLED IN BY DRILLER HEALTH DEPARTMENT APPROVAL  
COUNTY NAME: Howard; COUNTY NO.: A41431  
STATE SIGNATURE: Mark P. R. Klein; DATE ISSUED: 4/16/90  
NORTH GRID: 533000; EAST GRID: 0823000

USE FOR WATER (CIRCLE APPROPRIATE BOX)  
D HOME (SINGLE OR DOUBLE HOUSEHOLD UNIT ONLY)  
F FARMING (LIVESTOCK WATERING & AGRICULTURAL IRRIGATION)  
I INDUSTRIAL, COMMERCIAL, STATE AND FEDERAL GOV. OTHER (REQUIRES APPROPRIATION PERMIT)  
P PUBLIC OR PRIVATE WATER COMPANY (REQUIRES APPROPRIATION PERMIT AND STATE HEALTH DEPARTMENT APPROVAL)  
T TEST, OBSERVATION, MONITORING (MAY REQUIRE APPROPRIATION PERMIT)


APPROXIMATE DEPTH OF WELL: 200 FEET

SHOW MAJOR FEATURES OF BOX & LOCATE WELL WITH AN X  
SOURCES OF DRILLING WATER:  
1 City Water  
2 Well Water  
WRITE THE BOX NUMBER FROM THE MAP HERE:  
E 8283  
N 5383

APPROXIMATE DIAMETER OF WELL: 6 INCH

METHOD OF DRILLING (circle one)  
BORED (or Augered) JETTED Jetted & DRIVEN  
AIR-ROTARY AIR-PERCussion ROTARY (Hydraulic Rotary)  
CABLE REVERSE-ROTARY Drive-POINT  
other:

REPLACEMENT OR DEEPEMED WELLS (CIRCLE APPROPRIATE BOX)  
N THIS WELL WILL NOT REPLACE AN EXISTING WELL  
Y THIS WELL WILL REPLACE A WELL THAT WILL BE ABANDONED AND SEALED  
S THIS WELL WILL REPLACE A WELL THAT WILL BE USED AS A STANDBY  
D THIS WELL WILL DEEPEMED AN EXISTING WELL  
PERMIT NUMBER OF WELL TO BE REPLACED OR DEEPEMED (IF AVAILABLE):

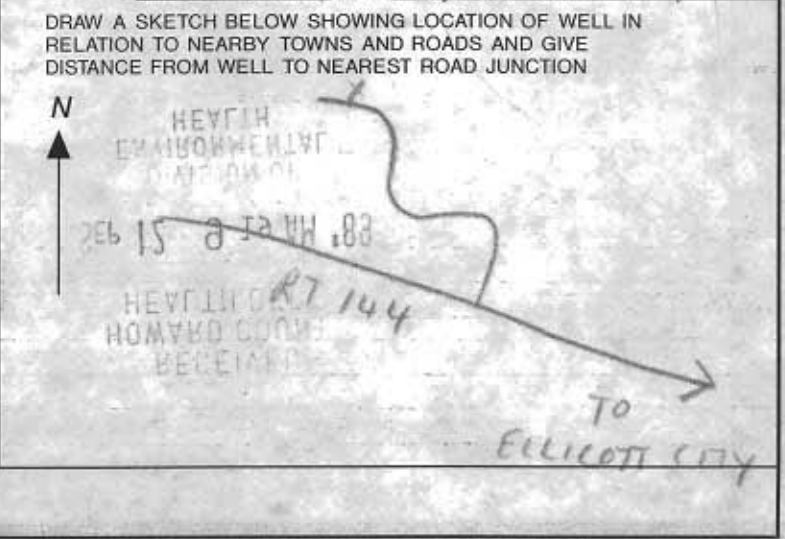

Not to be filled in by driller (OEP USE ONLY)  
APPROX. PERMIT NUMBER: GAP  
FORCE: MD; PERMIT No.: 40-88-1073

SPECIAL CONDITIONS



