

Building Permit Application

Howard County Maryland

Department of Inspections, Licenses and Permits

3430 Court House Drive

Permits: 410-313-2455

www.howardcountymd.gov

Date Received:	

Permit	No.:		

Building Address: 14900 V		Property Owner's Name 2000	Despel	
City: State: Zip Code: 21737		Address: 14926 VIC + Cong City: Glenole State:	A Zin Code: 2173	
Suite/Apt. #SDP/	/WP/BA #:	Phone: F		
Census Tract:	Subdivision:	Email:		
Section: Area	:Lot:	Applicant's Name & Mailing Address, (If of Applicant's Name:	other than stated herein)	
Tax Map: Parcel:	Grid:			
Zoning: Map Coordinat		Address: 10 COU State: V	Zin Code: 21121	
Zonnig Wap Coordinat	200 3/200	Phone: 0443610751 Fax:		
Existing Use:		Email:		
Proposed Use: SPD W	deele	Contractor Company: // LUN(N-	er Construction	
Estimated Construction Cost: \$		Contact Person: Kycon MC.		
Description of Work:		Address: 6851 ROD BEW		
Construct a 16 x 41	1 900 all = 2 1112 cm	City! Col (State: M)	Zip Code:	
		Phone: Fax:		
dear of steps	10.307	Email:		
Occupant/Tenant Name:		Ellion.		
Was tenant space previously occupied?	□Yes □No	Engineer/Architect Company:	^	
Contact Name:		Responsible Design Prof.:	Del	
Address:		Address:		
		· ·	7: 6:4	
City: State: Zip Code:		City:State:Zip Code:		
Phone:		Phone:Fax: _		
Email:		Email:		
Commercial Building Characteristics	Residential Building Characteristics	<u>Utilities</u> \	"国际创造",或首员基础 自	
Height:	SF Dwelling SF Townhouse	Electric:		
No. of stories:	Depth Width 1 st floor:	Gas: ☐ Yes No.		
Gross area, sq. ft./floor:	2 nd floor:	Water Supply		
Area of construction (sq. ft.):	Basement:	Public		
	☐ Finished Basement	Rrivate		
Use group:	☐ Unfinished Basement	/ Sewage Disposal		
Construction type:	☐ Crawl Space ☐ Slab on Grade	Public		
☐ Reinforced Concrete	No. of Bedrooms:	Private		
☐ Structural Steel	Multi-family Dwelling	Heating System		
☐ Masonry	No. of efficiency units:	☐ Electric ☐ Oil		
☐ Wood Frame	No. of 1 BR units:	☐ Natural Gas ☐ Propane Gas		
State Certified Modular	No. of 2 BR units:	☐ Other:		
	No. of 3 BR units: Other Structure:	<u>Sprinkler System:</u>		
	Dimensions:	☐ Yes ☐ No		
> Roadside Tree Project Permit	Footings:			
□Yes \ \ \ \ \ \ \ \ \ \ \ \ \ \ \ \ \ \ \	Roof:	Grading Permit Number:		
Roadside Tree Project Permit #	☐ State Certified Modular			
	☐ Manufactured Home	Building Shell Permit Number	:	
WITH ALL REGULATIONS OF HOWARD COUNTY V	WHICH ARE APPLICABLE THERETO; (4) THAT HE/SHE \ JNTY OFFICIALS THE RIGHT TO ENTER ONTO THIS PRO	MAKE THIS APPLICATION; (2) THAT THE INFORMATION IS WILL PERFORM NO WORK ON THE ABOVE REFERENCED PI PERTY FOR THE PURPOSE OF INSPECTING THE WORK PERM Print Name Oate	ROPERTY NOT SPECIFICALLY DESCRIBED IN	
Title/Company		·		
	Checks Payable to: DIRECTOR OF			
	PLEASE WRITE NE	EATLY & LEGIBLY		

-FOR OFFICE USE ONLY-

AGENCY	DATE	SIGNATURE OF APPROVAL
State Highways		
Building Officials		
PSZA (Zoning)		
PSZA (Engineering)		
Health	لاً أن	17 4. Osisa

Is Sediment Control approval required for issuance? ☐ Yes ☐ No
☐ CONTINGENCY CONSTRUCTION START

Front:		_
Rear:		
Side:		
Side St.:		Δ.
All minimum setbacks met?	☐ Yes	□No
Is Entrance Permit Required?	☐ Yes	□No
Historic District?	☐ Yes	□No
Lot Coverage for New Town Z	one:	
SDP/Red-line approval date:		

STATE OF THE PARTY OF THE PARTY OF	STREET, STREET
Filing Fee	\$
Permit Fee	\$
Tech Fee	\$
Excise Tax	\$
PSFS	\$
Guaranty Fund	\$
Add'l per Fee	\$
Total Fees	\$
Sub- Total Paid	\$
Balance Due	\$
Check	#

Distribution of Copies:

White: Building Officials

Green: PSZA,Zoning


Yellow: PSZA,Engineering

Pink: Health

Gold: SHA

AM A DULY LICENSED PROFESSIONAL LAND SURVEYOR UNDER THE LAWS OF THE STATE OF VARYLAND, LICENSE NO. 21128, EXFIRATION DATE 1/8/17. LEGEND. FF FRST FLOOR ELEVA ELEVATER S 30'40'26" EST BUILDING RESTRICTION END 125.47 SEPTIC TANK LOCATED FROM PERMIT DECK APPROVED COVEKED BORCH WITH UNDWISHED WILLS WALK-THRU BUILDING PERMIT BP# DREVENAS APP. SAN H. OSWOOD DATE: 6/15/17 DESC. OF WORK: Construct 16 x41 we plan shape deck in the with 10' PUBLIC TREE MAINTENANCE EASEMENT 3' PUBLIC DRAINAGE AND — LOUITY EASEMENT SEPTIC AREA VICTORY LANE BELLOING SETBACKS (B.R.L.'S) SHOWN HEREON PER SIT DEVELOPMENT PLAN SETBACK DISTANCES SHOWN HEREON AS "B" HAVE AN ACCURACY OF LC." FOOT. 14976 WOTORY LANE G.ENELG. MD 21737 Sorveyon's the interest of the politics of the source of the process of the politics of the source of the politics of the source of the politics of the politi SURVEYOR'S FERTIFICATE LOT 7 MERIWETHER FARMS _ BER 13779, FOLIC 47.3 PLAT NO. 21751

PROFESSIONAL CERTIFICATION: HEREEM CERTIFM THAT THESE DOCUMENTS WERE PREPARED BY WE OR UNDER MY RESPONSIBLE CHARGE, AND THAT I

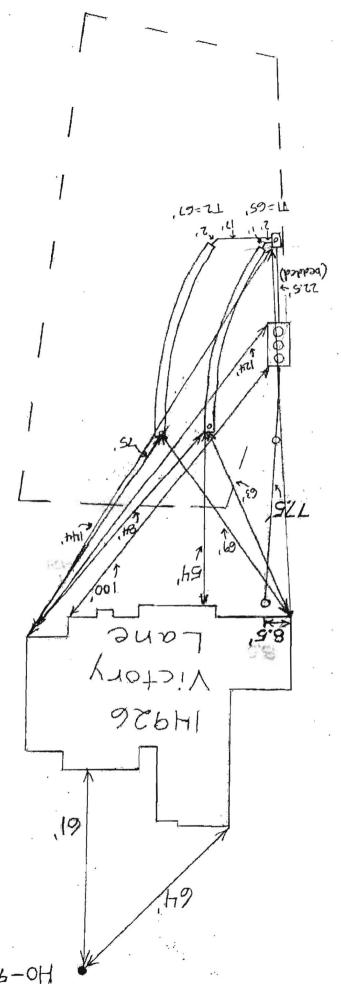

H0-42-508E

