

Building Permit Application
Howard County Maryland
Department of Inspections, Licenses and Permits
3430 Court House Drive
Permits: 410-313-2455
www.howardcountymd.gov www.howardcountymd.gov

Date Received:		

Permit No.:

	110						
Building Address:	1976	Westrott place	e,	Property Owner's Name:	Suna	RYE KIM	
city: Clarks	Villes	tate: MD Zip Code: _	21029	Address: 10976 N	PCTIOH	blace	
			,	City: Clarksylle	_State:	D Zip Code: 2102	
		SDP/WP/BA #:		Phone: 1301)854-	2/23 1	celt 410 913 0146	
		Subdivision:		1)			
Section:		Area:Lot:_		Applicant's Name & Mailing	g Address, (If o	other than stated herein)	
Тах Мар:	Pa	rcel: Grid:_		Applicant's Name:			
Zoning:	_ Map Coo	rdinates: Lot S	ize:	Address:	State:	Zip Code:	
				Phone:	Fax:		
Existing Use: Prin	nciny	residence		Email:	 ,		
Proposed Use: Dr	main	residence		Contractor Company:			
Estimated Construction	,			Contact Person:			
		^	3 N	Address:			
Description of Work: Finished basement			City:State:Zip Code:				
Acidina	a wou	1 office, kids	playare	License No. :			
				Phone:	Fax: _		
Occupant/Tenant Nam	e: Sur	g Rye KIM		Email:			
Was tenant space prev	iously occur	oled? Dves		Faciness/Architect Company			
			CINO	Engineer/Architect Company			
Contact Name:				Responsible Design Prof.:			
		tion place		Address:			
		State: MD Zip Code		City:Sta	ate:	Zip Code:	
Phone: 854-27	123	FOXCEN: 410 913	0146	Phone:			
Email: SIVEK							
Lindii.	11116- 0	(0 110011)		Email:			
Commercial Building C	haracterist	ics Residential Building C	Characteristics	Utilities		FART TACTOR	
Height:		SF Dwelling □ SF To		Electric: TYes [□No	建筑是有一种产品	
No. of stories:		Depth	Width		⊋Ńo		
Gross area, sq. ft./floor	:	1 st floor:		Water Supply			
		2 nd floor:		□ Public		TANKELE MY	
Area of construction (so	q. ft.):	Basement:				A CONTRACTOR	
		☐ Finished Basement		Private			
Use group:		Unfinished Basemen	nt	Sewage Dispose	<u>al</u>	to call which the	
		☐ Crawl Space		☐ Public			
Construction		☐ Slab on Grade		Private			
☐ Reinforced Concrete		No. of Bedrooms: 4		Heating System	n		
Structural Steel		Multi-family D	welling	☐ Electric ☐ Oil		ALE CHEST OF THE PERSON OF THE	
☐ Masonry		No. of efficiency units:		☐ Natural Gas ☐ Propane Gas		REDUCTION OF THE	
☐ Wood Frame	·los	No. of 1 BR units:		Other:			
State Certified Modu	liar	No. of 3 BR units:		200 M. H. H. H. G.			
		Other Structure:		Sprinkler System:			
		Dimensions:		☐ Yes ☐ Ńo	_		
> Roadside Tree Pro	lect Permit						
□Yes		Roof:		Grading Permi	t Number:		
Roadside Tree Proje	Committee of the commit	and the second s	ılar				
		☐ Manufactured Home		Building Shell Perr	mit Number:		
		* (FARS) - 1007 1 X X 7 * 1005 1 - 1007 1008	AL DES TORONO DE LO PROMETO DE		NO OTTA O A SELECTION OF THE RESIDENCE		
THE UNDERSIGNED HEREBY CE	RTIFIES AND A	GREES AS FOLLOWS: (1) THAT HE/SH	E IS AUTHORIZED TO	MAKE THIS APPLICATION; (2) THAT THE IN VILL PERFORM NO WORK ON THE ABOVE I	FORMATION IS CO	PRRECT; (3) THAT HE/SHE WILL COMP	
THIS APPLICATION; (5) THAT H	E/SHE GRANTS	COUNTY OFFICIALS THE RIGHT TO EN	TER ONTO THIS PROP	PERTY FOR THE PURPOSE OF INSPECTING TO	HE WORK PERMIT	FED AND POSTING NOTICES.	
	in_		_		IM		
Applicant's Signature	1		Pī	rint Name	-		
\bigcirc	_			6/13/17	,		
Email Address			De	ate			
				5			
Title/Company			_				
				INANCE OF HOWARD COUNTY			
بالمسارين		e e og falla alla de la comi	PLEASE WRITE NE		Carrier Address	real factors and	
1 1 1 1 1 1 1 1	2 7 7		-FOR OFFICE	AN AND THE WAY TO SEE THE PERSON OF THE PERS	WALL THE	Take (all his all)	
AGENCY	DATE	SIGNATURE OF APPROVAL	DPZ SETBACK INFORMATION		Filing Fee	\$	
State Highways			Front:		Permit Fee	\$	
	+		Rear:		Tech Fee Excise Tax	\$	
Building Officials			Side:		PSFS	\$	
PSZA (Zoning)			All minimum setbacks met? Yes No		Guaranty Fu		
PSZA (Engineering)			is Entrance Permit Required? ☐ Yes ☐ No		Add'l per Fe	e \$	
Health	6/13/	17 72+125	Historic District? ☐ Yes ☐ No		Total Fees	\$	
	royal require	d for issuance? \ Vas \ \ No		for New Town Zone:	Sub- Total P		
	s Sediment Control approval required for issuance? ☐ Yes ☐ No ☐ CONTINGENCY CONSTRUCTION START		Balance Due Check	\$ \$			
		no entransi.			A LACOPE M		

Distribution of Copies: White: Building Officials

Green: PSZA,Zoning


Yellow: PSZA,Engineering

Check Pink: Health

Gold: SHA

Days lugar

Lake Lake

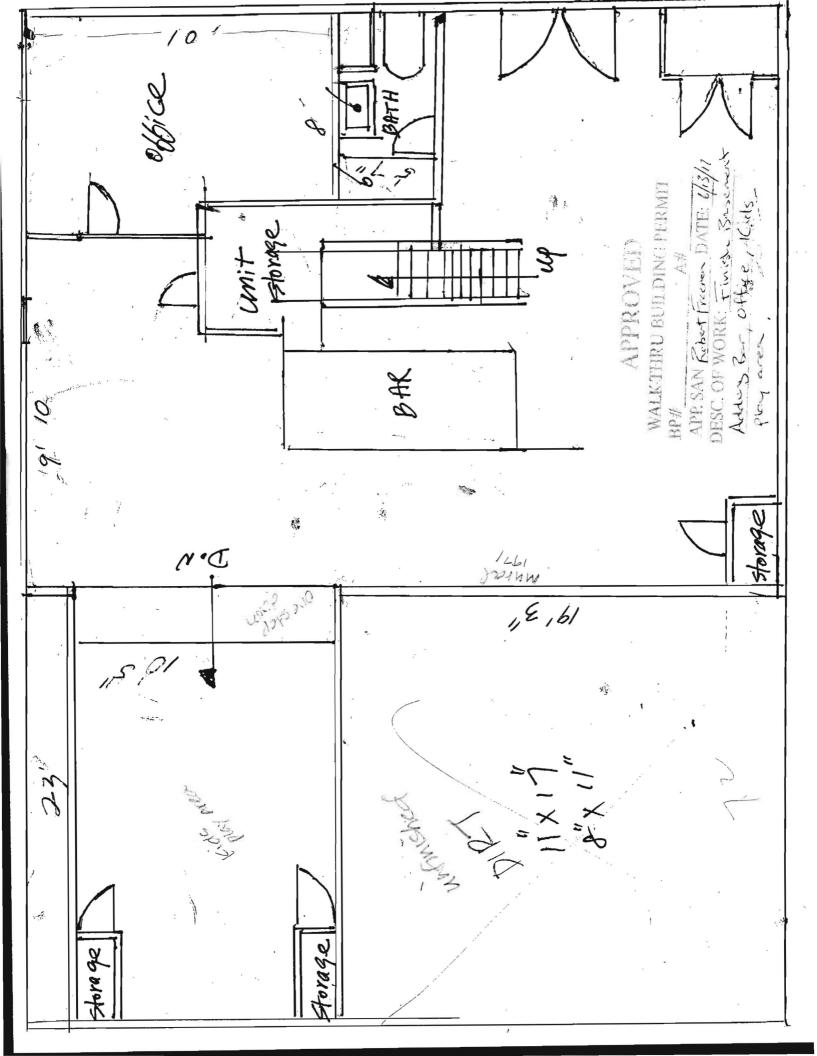

SINK A State of the Sta refres Nnir M 38771111 garage Churophy Chy. MOOK she luce exercise Poorghelf) FRONT (9 A) W

and Floor other 1 Closet someon tull zatio phioral Ooset ROOM. 12