



Building Permit Application

Howard County Maryland
Department of Inspections, Licenses and Permits
3430 Court House Drive
Permits: 410-313-2455
www.howardcountymd.gov

Date Received: _____

Permit No.: _____

Building Address: 18560 Windsor Forest Rd
City: Mount Airy State: MD Zip Code: 21371
Suite/Apt. #: _____ SDP/WP/BA #: _____
Census Tract: _____ Subdivision: _____
Section: _____ Area: _____ Lot: 2
Tax Map: 0006 Parcel: 0082 Grid: 0015
Zoning: RC-DEO - Rural Resid. Map Coordinates: _____ Lot Size: 51,060 SF
Existing Use: shed/accessory building
Proposed Use: new shed/accessory building
Estimated Construction Cost: \$ 11,000 +/-
Description of Work: demo existing shed/accessory bldg; install new shed/accessory bldg
Occupant/Tenant Name: _____
Was tenant space previously occupied? ☐ Yes ☒ No
Contact Name: _____
Address: _____
City: _____ State: _____ Zip Code: _____
Phone: _____ Fax: _____
Email: _____

Property Owner's Name: Christopher & Erin Creedlove
Address: 18560 Windsor Forest Rd
City: Mount Airy State: MD Zip Code: 21371
Phone: 410-328-6632 Fax: _____
Email: creedlove82@yahoo.com
Applicant's Name & Mailing Address, (if other than stated herein)
Applicant's Name: _____
Address: _____
City: _____ State: _____ Zip Code: _____
Phone: _____ Fax: _____
Email: _____
Contractor Company: Pioneer Pole Buildings, Inc.
Contact Person: Caitlin Herring
Address: 716 South Route 183
City: Schuylkill State: PA Zip Code: 17972
License No.: MD-121132
Phone: 888-448-2505 Fax: 570-739-1449
Email: cherring@pioneerpolebuildings.com
Engineer/Architect Company: _____
Responsible Design Prof.: _____
Address: _____
City: _____ State: _____ Zip Code: _____
Phone: _____ Fax: _____
Email: _____

Commercial Building Characteristics	Residential Building Characteristics
Height: _____	☐ SF Dwelling ☐ SF Townhouse
No. of stories: _____	Depth: _____ Width: _____
Gross area, sq. ft./floor: _____	1 st floor: _____
Area of construction (sq. ft.): _____	2 nd floor: _____
Use group: _____	Basement: _____
	☐ Finished Basement
	☐ Unfinished Basement
	☐ Crawl Space
	☐ Slab on Grade
Construction type:	No. of Bedrooms: _____
☐ Reinforced Concrete	<u>Multi-Family Dwelling</u>
☐ Structural Steel	No. of efficiency units: _____
☐ Masonry	No. of 1 BR units: _____
☐ Wood Frame	No. of 2 BR units: _____
☐ State Certified Modular	No. of 3 BR units: _____
	Other Structure: _____
	Dimensions: _____
☒ Roadside Tree Project Permit	Footings: _____
☐ Yes ☒ No	Roof: _____
Roadside Tree Project Permit # _____	☐ State Certified Modular
	☐ Manufactured Home

Utilities
Electric: ☐ Yes ☒ No EXISTING
Gas: ☐ Yes ☒ No
Water Supply
☐ Public <u>N/A</u>
☐ Private _____
Sewerage Disposal
☐ Public <u>N/A</u>
☐ Private _____
Heating System
☐ Electric ☐ Oil
☐ Natural Gas ☒ Propane Gas <u>N/A</u>
☐ Other: _____
Sprinkler System
☐ Yes ☒ No
Grading Permit Number: _____
Building Shell Permit Number: _____

THE UNDERSIGNED HEREBY CERTIFIES AND AGREES AS FOLLOWS: (1) THAT HE/SHE IS AUTHORIZED TO MAKE THIS APPLICATION; (2) THAT THE INFORMATION IS CORRECT; (3) THAT HE/SHE WILL COMPLY WITH ALL REGULATIONS OF HOWARD COUNTY WHICH ARE APPLICABLE THEREIN; (4) THAT HE/SHE WILL PERFORM NO WORK ON THE ABOVE REFERENCED PROPERTY NOT SPECIFICALLY DESCRIBED IN THIS APPLICATION; (5) THAT HE/SHE GRANTS COUNTY OFFICIALS THE RIGHT TO ENTER ONTO THIS PROPERTY FOR THE PURPOSE OF INSPECTING THE WORK PERMITTED AND POSTING NOTICES.

Applicant's Signature: Christopher T. Creedlove
Email Address: creedlove82@yahoo.com
Owner: OWNER
Title/Company: _____

Print Name: Christopher T. Creedlove
Date: 11/5/17

Checks Payable to: DIRECTOR OF FINANCE OF HOWARD COUNTY

"PLEASE WRITE NEATLY & LEGIBLY"

FOR OFFICE USE ONLY

AGENCY	DATE	SIGNATURE OF APPROVAL
State Highways		
Building Officials		
PSZA (Zoning)		
PSZA (Engineering)		
Health		
Is Sediment Control approval required for issuance? ☐ Yes ☒ No		
☐ CONTINGENCY CONSTRUCTION START		

DPZ SETBACK INFORMATION	
Front:	
Rear:	
Side:	
Side St.:	
All minimum setbacks met?	☐ Yes ☒ No
Is Entrance Permit Required?	☐ Yes ☒ No
Historic District?	☐ Yes ☒ No
Lot Coverage for New Town Zone:	
SDP/Red-line approval date:	

Filing Fee	\$
Permit Fee	\$
Tech Fee	\$
Excise Tax	\$
PSFS	\$
Guaranty Fund	\$
Add'l per Fee	\$
Total Fees	\$
Sub-Total Paid	\$
Balance Due	\$
Check	#

LONG CORNER ROAD

Approved Septic System Plan
Howard County Health Department

300112368

6-15-98
Date

Total linear feet of trench required 240 feet
Width of trench (as) 3 feet
Depth of trench (as) 4 feet
Depth of stone required betw. distribution pipe 2 feet

PRIVATE 24' U.I.C. DENEWAY EASEMENT FOR LOT 1 THRU 3 AND BOREL "A"

ROAD

APPROVED
WALK-THRU BUILDING PERMIT

APR SAND BEYOND DATE: 8/1/98

DESC. OF WORK: Shed FOR

Approved As to 10.2

PARAGON PROPERTY

SITUATED OFF LONGCORNER ROAD AND WINDSOR FOREST RD.
ELECTION DISTRICT NO. 4
HOWARD COUNTY, MARYLAND.


CLSI

Carroll Land Services
Inc. Incorporated
Engineers • Surveyors • Land Development Consultants
Landscape Architects • Environmental Specialists
439 East Main Street Westminster, MD 21157-5439
(410) 578-8011 FAX (410) 578-0009

DRAWN BY	J.A.
DESIGN BY	
REVIEW BY	
DATE	5/18/98
SCALE	1/4" = 50'
JOB NO.	98088
SHEET	1 OF 1

REVISED 5/20/98 FOR HOUSE EROSION.

RYEA

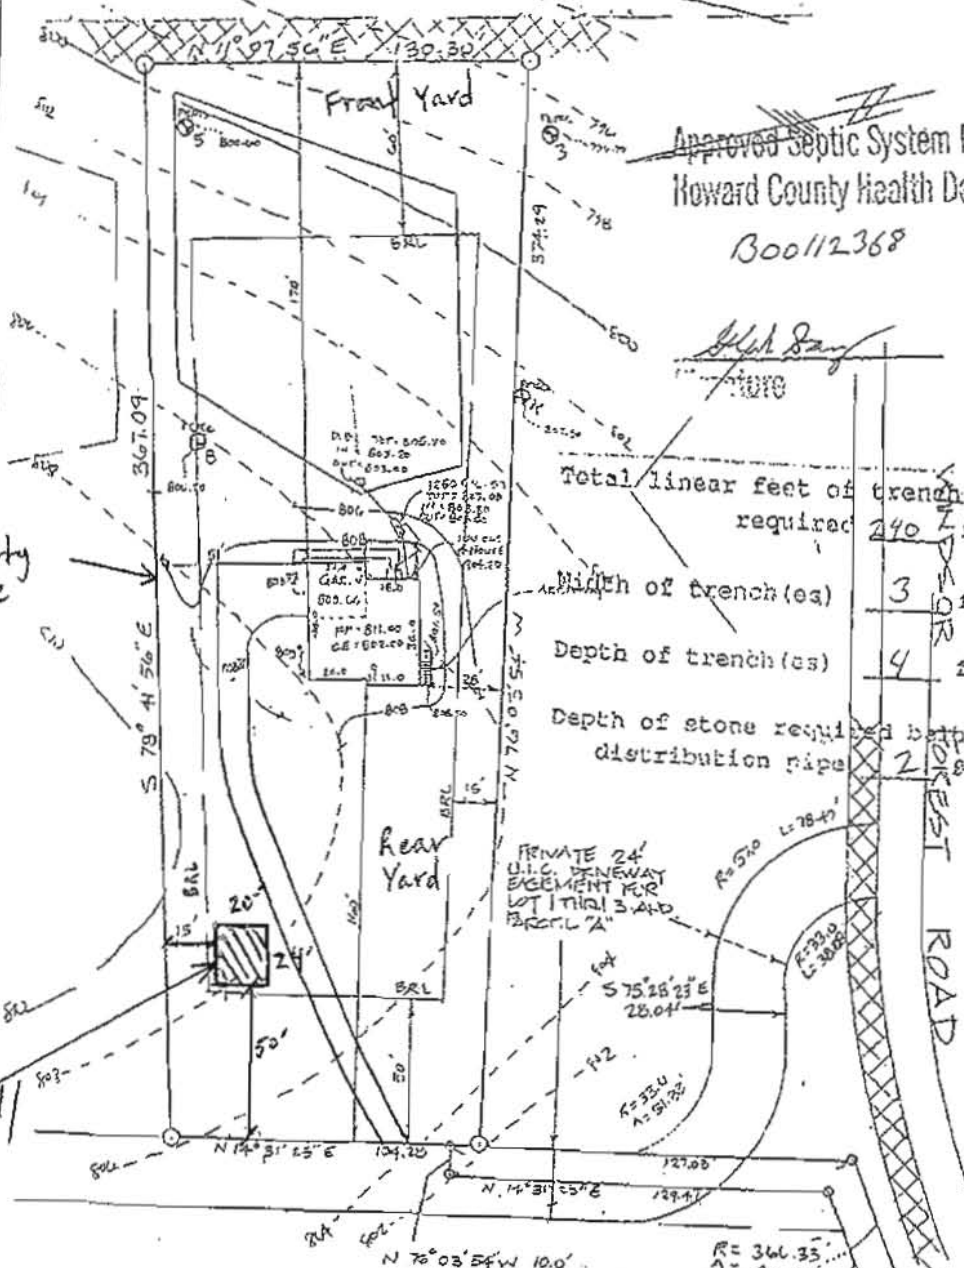

S 82° 09' 51" W 107.02

Well Location
S 13° 30' 51" W 67.11

R = 90.20
A = 30.01
R = 95.20
A = 55.88

R = 366.33
A = 40.47
R = 376.33
A = 25.02

APR SAND BEYOND DATE: 8/1/98

DESC. OF WORK: Shed FOR

Approved As to 10.2

PARAGON PROPERTY

SITUATED OFF LONGCORNER ROAD AND WINDSOR FOREST RD.
ELECTION DISTRICT NO. 4
HOWARD COUNTY, MARYLAND.

CLSI

Carroll Land Services
Inc. Incorporated
Engineers • Surveyors • Land Development Consultants
Landscape Architects • Environmental Specialists
439 East Main Street Westminster, MD 21157-5439
(410) 578-8011 FAX (410) 578-0009

DRAWN BY	J.A.
DESIGN BY	
REVIEW BY	
DATE	5/18/98
SCALE	1/4" = 50'
JOB NO.	98088
SHEET	1 OF 1

REVISED 5/20/98 FOR HOUSE EROSION.

RYEA