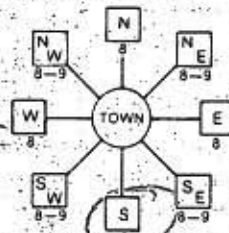
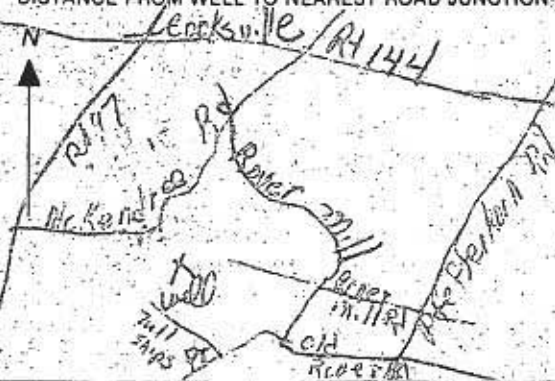


B 1 4419 (THIS NUMBER IS TO BE PUNCHED IN COLS. 3-6 ON ALL CARDS)	SEQUENCE NO. (OEP USE ONLY)	STATE OF MARYLAND PERMIT TO DRILL WELL please print or type.	OEP PERMIT NUMBER HO-81-1568 fill in this form completely
OWNER INFORMATION Date Received: <u>8/1/86</u> Owner: <u>Charles</u> First Name: <u>Charles</u> Street or RFD: <u>555 McKendree Rd</u> Town: <u>Cleonsville</u> State: <u>MD</u> Zip: <u>21738</u>		LOCATION OF WELL COUNTY: <u>Howard</u> SUBDIVISION: <u>Cooksville</u> SECTION: <u>44</u> LOT: <u>46</u> NEAREST TOWN: <u>Cooksville</u> MILES FROM TOWN (enter 0 if in town): <u>3</u> MI	
DRILLER INFORMATION Driller's Name: <u>George F. Easton</u> License No.: <u>41</u> Firm Name: <u>George F. Easton, Inc.</u> Address: <u>496 River Church Rd Mt. Airy Md</u> Signature: <u>George F. Easton</u> Date: <u>6-5-86</u>		4 DIRECTION OF WELL FROM TOWN (CIRCLE BOX)  CN WHICH SIDE OF ROAD (CIRCLE APPROPRIATE BOX) NORTH ☐ SOUTH ☒ WEST ☐ EAST ☐	
2 WELL INFORMATION APPROX. PUMPING RATE (GAL. PER MIN.): <u>600</u> AVERAGE DAILY QUANTITY NEEDED (GAL. PER DAY): <u>600</u>		NEAR WHAT ROAD: <u>Tail Ship</u> DISTANCE FROM ROAD: <u>75</u> FT ENTER FT or MI: <u>FT</u>	
USE FOR WATER (CIRCLE APPROPRIATE BOX) ☒ HOME (SINGLE OR DOUBLE HOUSEHOLD UNIT ONLY) ☐ FARMING (LIVESTOCK WATERING & AGRICULTURAL IRRIGATION) ☐ INDUSTRIAL, COMMERCIAL, STATE AND FEDERAL GOV. OTHER (REQUIRES APPROPRIATION PERMIT) ☐ PUBLIC OR PRIVATE WATER COMPANY (REQUIRES APPROPRIATION PERMIT AND STATE HEALTH DEPARTMENT APPROVAL) ☐ TEST OBSERVATION MONITORING (MAY REQUIRE APPROPRIATION PERMIT)		NOT TO BE FILLED IN BY DRILLER HEALTH DEPARTMENT APPROVAL COUNTY NAME: <u>Howard</u> COUNTY NO.: <u>A36338</u> DEP SIGNATURE: _____ STATE HEALTH INSERT S: ☐ DATE ISSUED: <u>6/19/86</u> EXP. DATE: <u>12/19/86</u> NORTH GRID: <u>532000</u> EAST GRID: <u>0798000</u>	
APPROXIMATE DEPTH OF WELL: <u>50</u> FEET APPROXIMATE DIAMETER OF WELL: <u>6</u> INCH		SHOW MAJOR FEATURES OF BOX & LOCATE WELL WITH AN X SOURCES OF DRILLING WATER: 1. _____ 2. _____ 3. _____ WRITE THE BOX NUMBER FROM THE MAP HERE: E: <u>798</u> N: <u>532</u>	
METHOD OF DRILLING (circle one) BORED (or Augered) ☒ JETTED ☐ Jetted & DRIVEN ☐ AIR-ROTARY ☐ AIR-PERCussion ☐ ROTARY (Hydraulic Rotary) ☐ CABLE ☐ REVERSE-ROTARY ☐ DRIVE-POINT ☐ other: _____		DRAW A SKETCH BELOW SHOWING LOCATION OF WELL IN RELATION TO NEARBY TOWNS AND ROADS AND GIVE DISTANCE FROM WELL TO NEAREST ROAD JUNCTION. 	
REPLACEMENT OR DEEPEMED WELLS (CIRCLE APPROPRIATE BOX) ☒ THIS WELL WILL NOT REPLACE AN EXISTING WELL ☐ THIS WELL WILL REPLACE A WELL THAT WILL BE ABANDONED AND SEALED ☐ THIS WELL WILL REPLACE A WELL THAT WILL BE USED AS A STANDBY ☐ THIS WELL WILL DEEPEMED AN EXISTING WELL PERMIT NUMBER OF WELL TO BE REPLACED OR DEEPEMED (IF AVAILABLE): _____		Not to be filled in by driller (OEP USE ONLY) APPROP. PERMIT NUMBER: _____ FORCE: <u>1</u> WRITE INITIALS IN BOX: <u>HC</u> PERMIT NO.: <u>HO-81-1568</u>	
SPECIAL CONDITIONS: _____			

DRILLER

7/17/86

already
grouted

(apparently) 7/15

8 bags cement

33' casing (2' above)

28' open hole

Location - as decided
from time of perc
test - OK

H₂O sample taken

7/17/86 (H9809)

C1 33596 (THIS NUMBER IS TO BE PUNCHED IN COLS. 3-6 ON ALL CARDS)	SEQUENCE NO. (OEP USE ONLY)	STATE OF MARYLAND WELL COMPLETION REPORT FILL IN THIS FORM COMPLETELY PLEASE PRINT OR TYPE	THIS REPORT MUST BE SUBMITTED WITHIN 45 DAYS AFTER WELL IS COMPLETED. COUNTY NUMBER A 36738
DATE Received 	DATE WELL COMPLETED 07/15/86	Depth of Well 400 (TO NEAREST FOOT)	PERMIT NO. FROM "PERMIT TO DRILL WELL" 40-81-1568
OWNER MURRES CHARLES last name first name		STREET OR RFD TALL SHIPS DR. TOWN COOKSVILLE	
SUBDIVISION _____		SECTION _____ LOT _____	

WELL LOG Not required for driven wells STATE THE KIND OF FORMATIONS PENETRATED, THEIR COLOR, DEPTH, THICKNESS AND IF WATER BEARING	GROUTING RECORD WELL HAS BEEN GROUTED (Circle Appropriate Box) TYPE OF GROUTING MATERIAL CEMENT CM BENTONITE CLAY BC NO. OF BAGS 8 NO. OF POUNDS 800 GALLONS OF WATER 40 DEPTH OF GROUT SEAL (to nearest foot) from 0 to 28 ft. (enter 0 if from surface)	C 3 PUMPING TEST HOURS PUMPED (nearest hour) 6 PUMPING RATE (gal. per min. to nearest gal.) 3 METHOD USED TO MEASURE PUMPING RATE Bucket WATER LEVEL (distance from land surface) BEFORE PUMPING 32 WHEN PUMPING 153 TYPE OF PUMP USED (for test) A air P piston T turbine C centrifugal R rotary O other (describe below) J jet S submersible																																		
<table border="1" style="width:100%; border-collapse: collapse;"> <thead> <tr> <th rowspan="2">DESCRIPTION (Use additional sheets if needed)</th> <th colspan="2">FEET</th> <th rowspan="2">Check if water bearing</th> </tr> <tr> <th>FROM</th> <th>TO</th> </tr> </thead> <tbody> <tr><td>Top Soil</td><td>0</td><td>2</td><td></td></tr> <tr><td>Clay</td><td>2</td><td>4</td><td></td></tr> <tr><td>Shale x</td><td>4</td><td>10</td><td></td></tr> <tr><td>Sand Stone</td><td>10</td><td>28</td><td></td></tr> <tr><td>Mica</td><td>28</td><td>145</td><td></td></tr> <tr><td>Mica + Flint mixed</td><td>145</td><td>150</td><td>✓</td></tr> <tr><td>Mica</td><td>150</td><td>400</td><td></td></tr> </tbody> </table>	DESCRIPTION (Use additional sheets if needed)	FEET		Check if water bearing	FROM	TO	Top Soil	0	2		Clay	2	4		Shale x	4	10		Sand Stone	10	28		Mica	28	145		Mica + Flint mixed	145	150	✓	Mica	150	400		CASING RECORD casing types insert appropriate code below ST CO STEEL CONCRETE PL OT PLASTIC OTHER MAIN CASING TYPE ST Nominal diameter top (main) casing (nearest inch) 6 Total depth of main casing (nearest foot) 33 OTHER CASING (if used) diameter inch _____ depth (feet) from _____ to _____	PUMP INSTALLED DRILLER WILL INSTALL PUMP YES NO (CIRCLE) (YES or NO) IF DRILLER INSTALLS PUMP, THIS SECTION MUST BE COMPLETED FOR ALL WELLS EXCEPT HOME USE TYPE OF PUMP INSTALLED PLACE (A,C,J,P,R,S,T,O) IN BOX - SEE ABOVE: S CAPACITY: GALLONS PER MINUTE (to nearest gallon) _____ PUMP HORSE POWER _____ PUMP COLUMN LENGTH (nearest ft.) _____ CASING HEIGHT (circle appropriate box and enter casing height) + above - below LAND SURFACE 21 (nearest foot)
DESCRIPTION (Use additional sheets if needed)		FEET			Check if water bearing																															
	FROM	TO																																		
Top Soil	0	2																																		
Clay	2	4																																		
Shale x	4	10																																		
Sand Stone	10	28																																		
Mica	28	145																																		
Mica + Flint mixed	145	150	✓																																	
Mica	150	400																																		
CIRCLE APPROPRIATE LETTER A A WELL WAS ABANDONED AND SEALED WHEN THIS WELL WAS COMPLETED E ELECTRIC LOG OBTAINED P TEST WELL CONVERTED TO PRODUCTION WELL I HEREBY CERTIFY THAT THIS WELL HAS BEEN CONSTRUCTED IN ACCORDANCE WITH COMAR 10.17.13 "WELL CONSTRUCTION" AND IN CONFORMANCE WITH ALL CONDITIONS STATED IN THE ABOVE CAPTIONED PERMIT, AND THAT THE INFORMATION PRESENTED HEREIN IS ACCURATE AND COMPLETE TO THE BEST OF MY KNOWLEDGE	SCREEN RECORD screen type or open hole insert appropriate code below ST BR HO STEEL BRASS OPEN HOLE PL OT PLASTIC OTHER C 2 DEPTH (nearest ft.) 1 40 2 31 3 400 SLOT SIZE 1 _____ 2 _____ 3 _____ DIAMETER OF SCREEN _____ (NEAREST INCH) GRAVEL PACK IF WELL DRILLED WAS FLOWING WELL INSERT F IN BOX 68 68	LOCATION OF WELL ON LOT SHOW PERMANENT STRUCTURE SUCH AS BUILDING, SEPTIC TANKS, AND/OR LANDMARKS AND INDICATE NOT LESS THAN TWO DISTANCES (MEASUREMENTS TO WELL) 50' well 750' X Tall ships																																		
DRILLERS IDENT. NO. 40 DRILLERS SIGNATURE (MUST MATCH SIGNATURE ON APPLICATION) SITE SUPERVISOR (sign. of driller or journeyman responsible for sitework if different from permittee)	OEP USE ONLY (NOT TO BE FILLED IN BY DRILLER) T (E.R.O.S.) WQ 70 ☐ 72 ☐ 74 ☐ 75 ☐ 76 ☐ TELESCOPE CASING LOG INDICATOR OTHER DATA																																			

11/186

8:30

8:00

Page 1 of 1
Date 9/15/86Review 9-288 ok
S. AbelFIELD DATA SHEET
HOWARD COUNTY WELL YIELD TEST

Well Permit No. HO - 81-1568

Location of property (road) Tall ShipsSubdivision Lot Block Plat Sec. Well Driller Gen. Easterday Owner Charles HalboDepth of well 400 ft. 1.56 gpmDistance of measuring point (M.P.) above ground 2 FeetStatic water level (S.W.L.) below M.P. 32 FT

High rate pumping -- reservoir drawdown

Time pump started 8:30 10:00 Pumping rate 12 G.P.M.Total time 30 min to reach pumping water level 172 ft. below M.P.

II. Recovery pump test data - observations to be recorded every 15 minutes

TIME (in 15 minute intervals)	WATER LEVEL below M.P.	PUMPING RATE time to fill 1 gallon bucket	FLOW METER READING (if used)	CALCULATED FLOW (gallons per minute)
10:30	172	45 sec	Pump Set	1 1/2
10:45	157	45 sec		1 1/2
11:00	154	20 sec	AT 300 FT	3
11:15	153	19 sec		3 1/2
11:30	153	18 sec	Denny	3 1/2
11:45	153	18 sec		3 1/2
12:00	153	18 sec		3 1/2
12:15	153	18 sec		3 1/2
12:30	153	18 sec		3 1/2
12:45	153	18 sec		3 1/2
1:00	153	18 sec		3 1/2
1:15	153	18 sec		3 1/2
1:30	153	18 sec		3 1/2
1:45	153	18 sec		3 1/2
2:00	153	18 sec		3 1/2
2:15	153	18 sec		3 1/2
2:30	153	18 sec		3 1/2
2:45	153	18 sec		3 1/2
3:00	153	18 sec		3 1/2
3:15	153	18 sec		3 1/2
3:30	153	18 sec		3 1/2
3:45	153	18 sec		3 1/2
4:00	153	18 sec		3 1/2
4:15	153	18 sec		3 1/2
4:30	153	18 sec		3 1/2

4/27/87

APPLICATION FOR PITLESS ADAPTER, WELL PUMP AND PRESSURE TANK INSTALLATION

Howard County Health Department
Bureau of Environmental Health
3525-H Ellicott Mills Drive
Court House Square
Ellicott City, Md. 21043
461-9933

New Installation ☒
Replacement ☐

Receipt # 39252
Date 4/24/87

Name of Installer R.A. WOOD PLUMBING

Telephone 381 4823

License number MD 7040

Certified Well Pump Installer ☐ Well Driller ☐ Registered Plumber ☒

Name of Property Owner HOBBS Telephone 997-5828

Subdivision Lot # Well tag # H0-81-1568

Site Address 17051 TALLSHIRE DR
GLENWOOD MD 21723

Pump

1. Type
 - a. Deep well jet ☒
 - b. Shallow well jet ☐
 - c. Submersible ☒
2. Make GAULD
3. Model # 10EH
4. Capacity 7 GPM
5. Pump exceeds well capacity Yes ☐ No ☒
6. If Yes, is low pressure cutoff switch installed? Yes ☐ No ☐
7. What methods are used to protect the pump and electrical wiring from vibrations? Torque arrestors ☒ Cable guards 40 Other CABLE TIES

Motor

1. Horsepower 1 HP
2. RPM 1750
3. Voltage
 - a. 110 ☐
 - b. 220 ☒

Pitless Adapter

1. Make GAULD
2. Model # 10EH
3. Depth 2'

Tank

1. Capacity 4.50 gpm
2. Pressure relief valve? 7.5 PSI

Piping

1. Type 1/2" PEX
2. Size 1"
3. NSF and/or BOCA Code approved yes
4. Depth of supply line 2.95'

Well data

1. Depth 400 ft.
2. Yield 30 GPM
3. Static water level ft.
4. Will water supply be disinfected by installer? yes

4/27/87 Pitless well line AT 50" below GRADE; INSIDE WORK NOT COMPLETE SILE

I understand that it is my responsibility to notify the Howard County Health Department when the installation is ready for inspection (otherwise this permit is null and void).

All information given above is true to the best of my knowledge.

Signature of Applicant: Roy A Ward

Date: 04-24-87


Note: A sticker indicating approval/status of the installation will be placed on the well casing at the time of the inspection.

NORTH

NOTES:


1. THIS AREA DESIGNATES A PRIVATE SEWAGE EASEMENT OF 10,000 SQUARE FEET AS REQUIRED BY THE MARYLAND STATE DEPARTMENT OF HEALTH AND MENTAL HYGIENE FOR INDIVIDUAL SEWAGE DISPOSAL. IMPROVEMENTS OF ANY NATURE IN THIS AREA ARE RESTRICTED UNTIL PUBLIC SEWAGE IS AVAILABLE. THESE EASEMENTS SHALL BECOME NULL AND VOID UPON CONNECTION TO A PUBLIC SEWAGE SYSTEM. THE COUNTY HEALTH OFFICER SHALL HAVE THE AUTHORITY TO GRANT VARIANCES FOR ENCROACHMENTS INTO THE PRIVATE SEWAGE EASEMENT. RECORDATION OF A MODIFIED SEWAGE EASEMENT SHALL NOT BE NECESSARY.
2. THE LOTS SHOWN HEREON COMPLY WITH THE MINIMUM OWNERSHIP WIDTH AND LOT AREA AS REQUIRED BY THE MARYLAND STATE DEPARTMENT OF HEALTH AND MENTAL HYGIENE.
3. SUBJECT PROPERTY ZONED "R" PER 8/2/85 COMPREHENSIVE ZONING PLAN.
4. PERCOLATION AREAS AND WATER WELLS FOR ADJOINING LOTS WILL BE SHOWN WHERE PERTINENT.

MCKENDREE ROAD

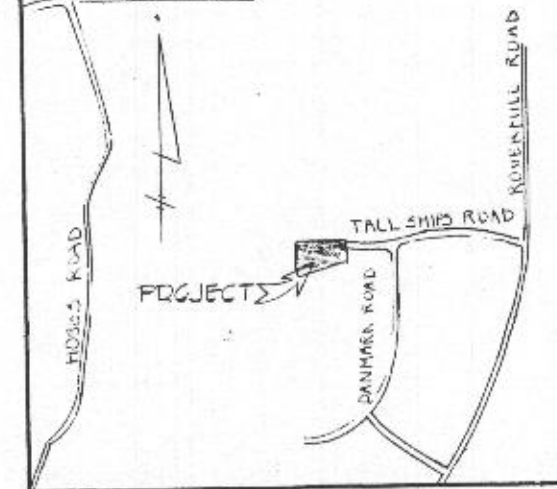

VICINITY MAP
SCALE 1" = 1200'

LOT 1
ROVER MILL ESTATES

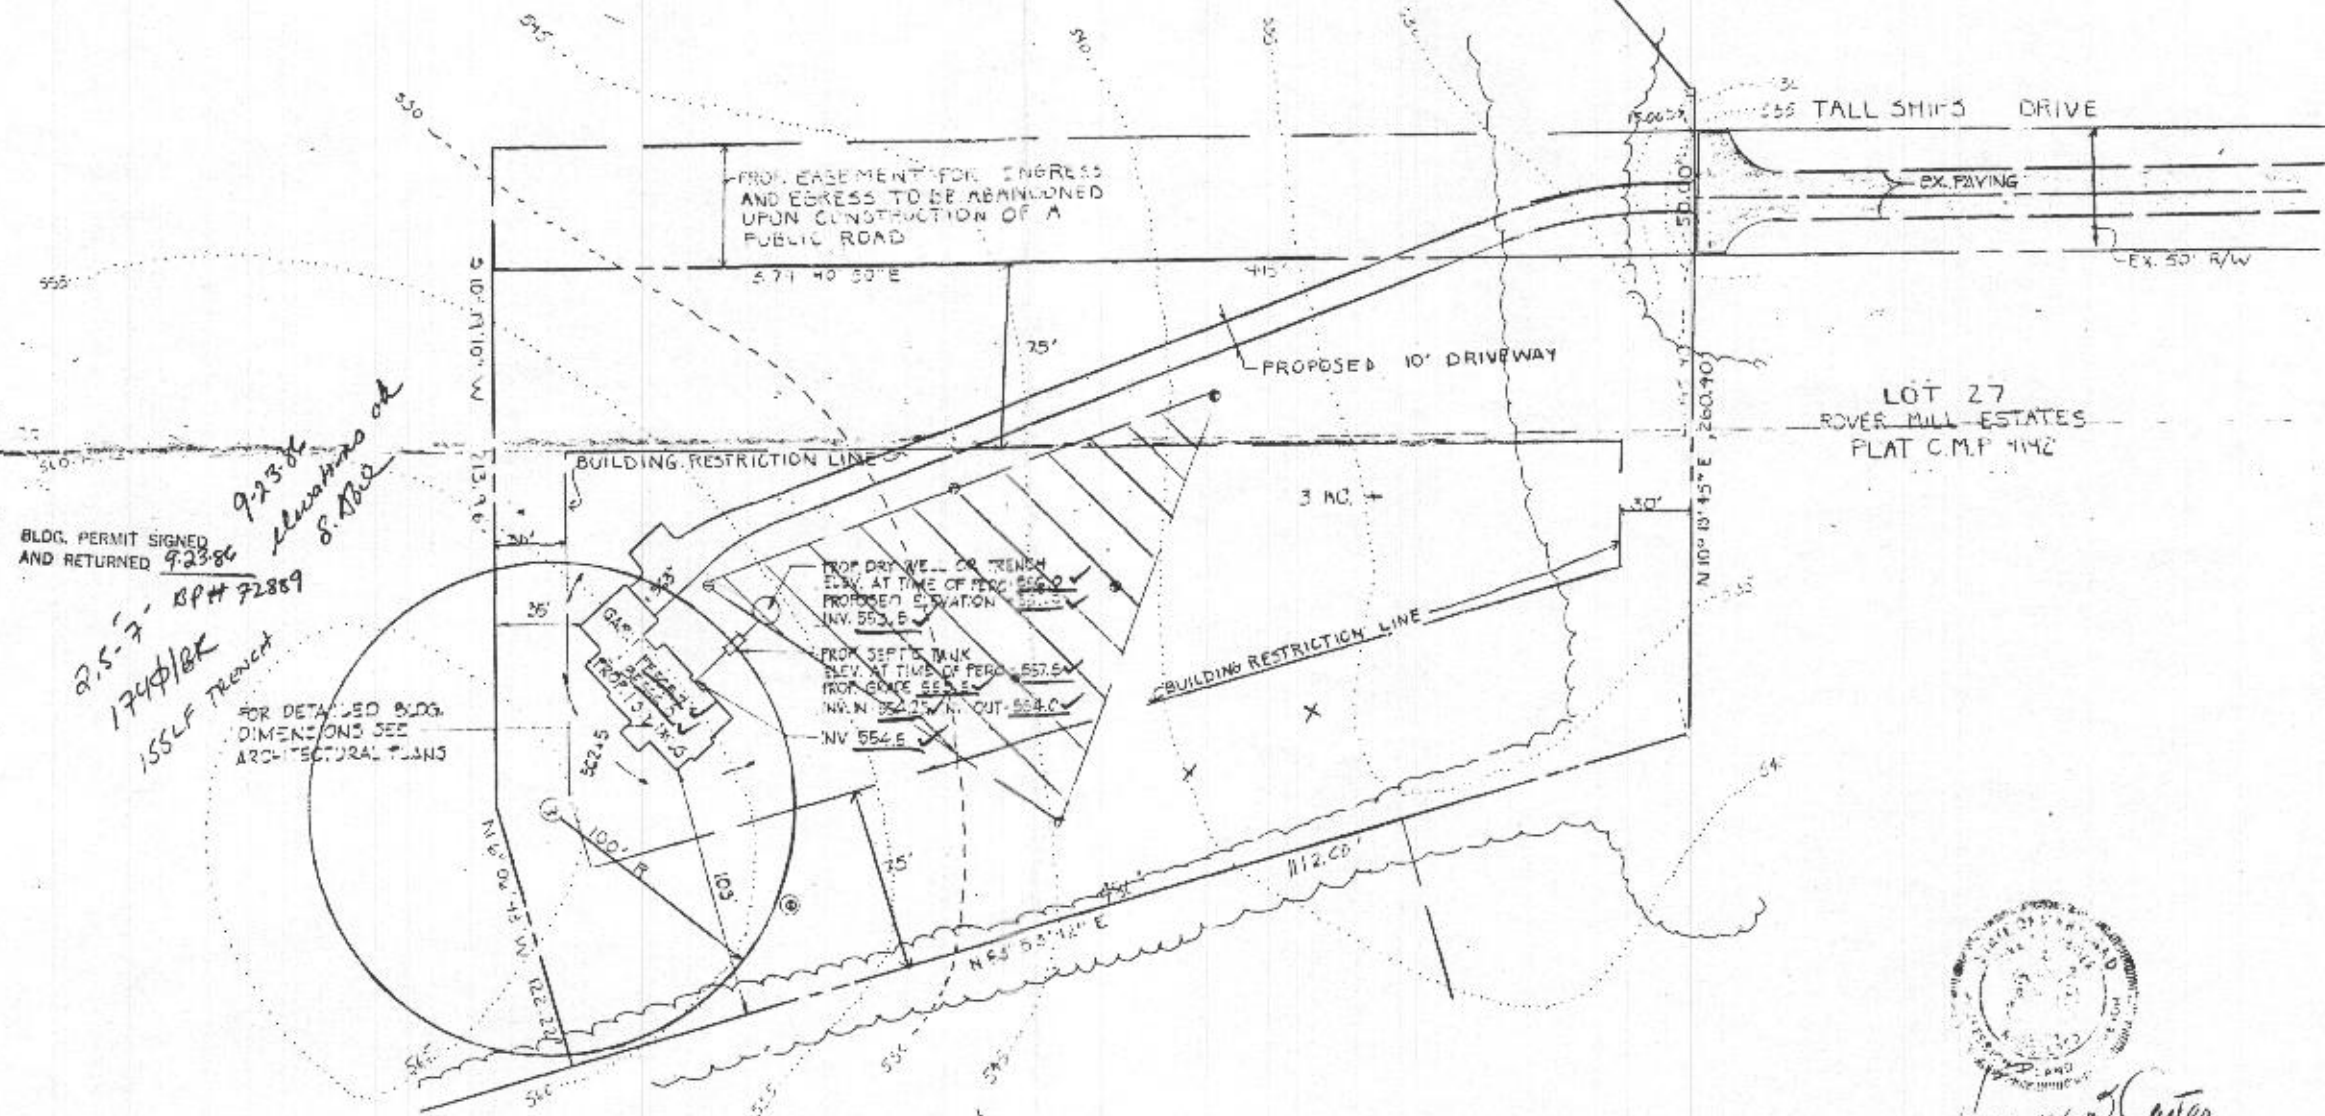

BLDG. PERMIT SIGNED
AND RETURNED 9-23-86

2.5-7-86 BP# 72889

1744/18K
155LF TRENCH

FOR DETAILED BLDG.
DIMENSIONS SEE
ARCHITECTURAL PLANS

APPROVED FOR PRIVATE WATER AND PRIVATE
SEWERAGE SYSTEMS HOWARD COUNTY HEALTH
DEPARTMENT

John B. ... 6-4-86
COUNTY HEALTH OFFICER DATE

LEGEND

⊠ DENOTES LOCATION OF DWELLING

⊙ DENOTES PROPOSED WELL

⊙ DENOTES FIELD LOCATION OF PERC HOLES

⊙ DENOTES UNUSED PERC HOLES
X DENOTES BAD PERC HOLES



Charles A. Hobbs
5/26/92

PROPERTY OF
CHARLES A. HOBBS