



Building Permit Application

Howard County Maryland
Department of Inspections, Licenses and Permits
3430 Court House Drive
Permits: 410-313-2455
www.howardcountymd.gov

Date Received: _____

Permit No.: _____

Building Address: 10822 VISTA RD
City: COLUMBIA State: MD Zip Code: 21044
Suite/Apt. #: _____ SDF/WP/BA #: _____
Census Tract: _____ Subdivision: Holly Hills
Section: _____ Area: _____ Lot: X-3
Tax Map: _____ Parcel: _____ Grid: _____
Zoning: _____ Map Coordinates: _____ Lot Size: _____

Existing Use: _____
Proposed Use: _____
Estimated Construction Cost: \$ _____

Description of Work: INSTALL 8' HIGH WOOD FENCE AS SHOWN

Occupant/Tenant Name: _____
Was tenant space previously occupied? ☐ Yes ☐ No
Contact Name: _____
Address: _____
City: _____ State: _____ Zip Code: _____
Phone: _____ Fax: _____
Email: _____

Property Owner's Name: BRUCE COOPER
Address: 10822 VISTA RD
City: COLUMBIA State: MD Zip Code: 21044
Phone: 410-531-4684 Fax: _____
Email: BRUCE.COOPER@COMCAST.NET

Applicant's Name & Mailing Address (If other than state herein)
Applicant's Name: ARR VIRGINIA COOPER
Address: SAME
City: _____ State: _____ Zip Code: _____
Phone: _____ Fax: _____
Email: _____

Contractor Company: _____
Contact Person: _____
Address: _____
City: _____ State: _____ Zip Code: _____
License No.: _____
Phone: _____ Fax: _____
Email: _____

Engineer/Architect Company: _____
Responsible Design Prof.: _____
Address: _____
City: _____ State: _____ Zip Code: _____
Phone: _____ Fax: _____
Email: _____

Commercial Building Characteristics	Residential Building Characteristics	
Height: _____	☐ SF Dwelling	☐ SF Townhouse
No. of stories: _____	Depth Width	
Gross area, sq. ft./floor: _____	1 st floor: _____	
	2 nd floor: _____	
Area of construction (sq. ft.): _____	Basement: _____	
Use group: _____	☐ Finished Basement	
	☐ Unfinished Basement	
	☐ Crawl Space	
Construction type: _____	☐ Slab on Grade	
☐ Reinforced Concrete	No. of Bedrooms: _____	
☐ Structural Steel	Multi-family Dwelling	
☐ Masonry	No. of efficiency units: _____	
☐ Wood Frame	No. of 1 BR units: _____	
☐ State Certified Modular	No. of 2 BR units: _____	
	No. of 3 BR units: _____	
	Other Structure: _____	
	Dimensions: _____	
➤ Roadside Tree Project Permit	Footings: _____	
☐ Yes ☐ No	Roof: _____	
Roadside Tree Project Permit # _____	☐ State Certified Modular	
	☐ Manufactured Home	

Utilities
Electric: ☐ Yes ☐ No
Gas: ☐ Yes ☐ No
Water Supply
☐ Public
☐ Private
Sewage Disposal
☐ Public
☐ Private
Heating System
☐ Electric ☐ Oil
☐ Natural Gas ☐ Propane Gas
☐ Other: _____
Sprinkler System
☐ Yes ☐ No
Grading Permit Number: _____
Building Shell Permit Number: _____

THE UNDERSIGNED HEREBY CERTIFIES AND AGREES AS FOLLOWS: (1) THAT HE/SHE IS AUTHORIZED TO MAKE THIS APPLICATION; (2) THAT THE INFORMATION IS CORRECT; (3) THAT HE/SHE WILL COMPLY WITH ALL REGULATIONS OF HOWARD COUNTY WHICH ARE APPLICABLE THERE TO; (4) THAT HE/SHE WILL PERFORM NO WORK ON THE ABOVE REFERENCED PROPERTY NOT SPECIFICALLY DESCRIBED IN THIS APPLICATION; (5) THAT HE/SHE GRANTS COUNTY OFFICIALS THE RIGHT TO ENTER ONTO THIS PROPERTY FOR THE PURPOSE OF INSPECTING THE WORK PERMITTED AND POSTING NOTICES.

Applicant's Signature: Virginia Cooper Print Name: VIRGINIA COOPER
Date: 2/5/18
Email Address: _____
Title/Company: _____

Checks Payable to: DIRECTOR OF FINANCE OF HOWARD COUNTY

PLEASE WRITE NEATLY & LEGIBLY

-FOR OFFICE USE ONLY-

AGENCY	DATE	SIGNATURE OF APPROVAL
State Highways		
Building Officials		
PSZA (Zoning)		
PSZA (Engineering)		
Health		

Is Sediment Control approval required for issuance? ☐ Yes ☐ No
☐ CONTINGENCY CONSTRUCTION START

DPZ SETBACK INFORMATION
Front: _____
Rear: _____
Side: _____
Side St.: _____
All minimum setbacks met? ☐ Yes ☐ No
Is Entrance Permit Required? ☐ Yes ☐ No
Historic District? ☐ Yes ☐ No
Lot Coverage for New Town Zone: _____
SDF/Red-line approval date: _____

Filing Fee	\$
Permit Fee	\$
Tech Fee	\$
Excise Tax	\$
PSFS	\$
Guaranty Fund	\$
Add'l per Fee	\$
Total Fees	\$
Sub-Total Paid	\$
Balance Due	\$
Check	\$


Distribution of Copies: White: Building Officials Green: PSZA, Zoning Yellow: PSZA, Engineering Pink: Health Gold: SHA

5' utility
Easement S 74° 27' E 152.0'

83

49008 sf

N 15° 33' E 263.21'

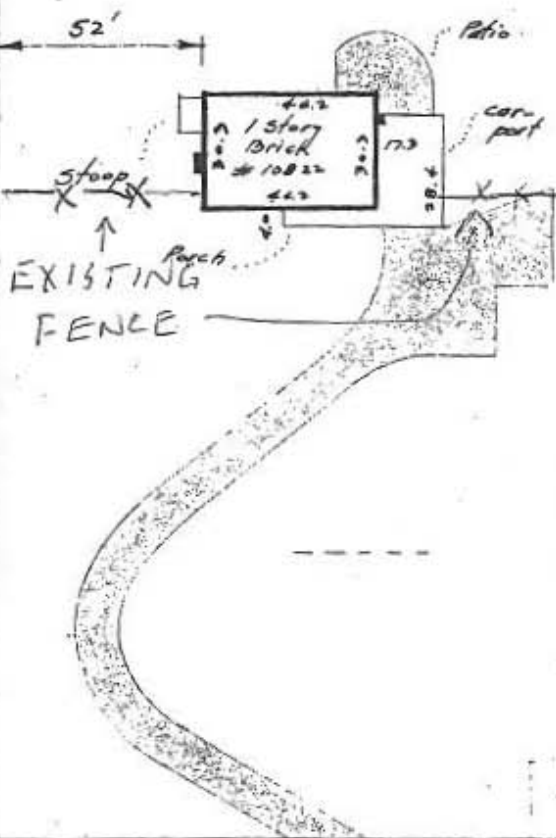

House Location
10822 Vista Road

LOT 83

SECTION 6

HOLIDAY HILLS

Howard County
MARYLAND

34- APPROVED

WALK-THRU BUILDING PERMIT

BB2#

APP. SAN

DATE: 2/5/88

DESC. OF WORK:

Installation of 8' Fence as shown.

20' drainage easement

To Columbia Pike

VISTA ROAD
50'

L.B.E. & H. Case: Cooper

Note: House location surveys do not include setting iron pipes on property corners. Do not use this plat for the installment of fences.

SURVEYOR'S CERTIFICATE

I hereby certify that the location of all the existing improvements on the above described property has been carefully established by a transit-tape survey and that unless otherwise shown there are no encroachments.

Roger M. Vales

ROGER M. VALES
Registered Land Surveyor Md 4948 Va. 910

REFERENCE

PLAT BOOK
9
PLAT NUMBER
99

LIBER
FOLIO

VALES & ASSOCIATES, INC.
LAND SURVEYORS

460-3805

14916 EMORY LANE
ROCKVILLE, MD. 20853

DATE 12.12.80

SCALE 1" = 50'

JOB NUMBER
80.614

WALL CHECK

FIELD BOOK 145.6

RECORD NUMBER

PARTY CHIEF ALD

DRAWN R.M.V.

SH 13696