

Bureau of Environmental Health
 8930 Stanford Boulevard, Columbia, MD 21045
 Main: 410-313-2640 | Fax: 410-313-2648
 TDD 410-313-2323 | Toll Free 1-866-313-6300
www.hchealth.org
 Facebook: www.facebook.com/hocohealth

Maura J. Rossman, M.D., Health Officer

RECEIPT DATE: 7/3/18

ONSITE SEWAGE DISPOSAL SYSTEM

P 563045

INSTALLATION APPROVAL DATE: 7/5/18 SEC

PERMIT
MINOR REPAIR

A Repair

PROPERTY ADDRESS: 587 W. Watersville Road

SUBDIVISION: _____ LOT: _____ TAX ID: 04-334817

CONTRACTOR: J & R Construction Service EMAIL: _____

CONTRACTOR ADDRESS: P.O Box 870 Mount Airy, MD 21771 PHONE: 301-674-6730

PROPERTY OWNER: John Piorkowski EMAIL: _____

OWNER ADDRESS: 587 W. Watersville Road, Mount Airy, MD 21771 PHONE: 443-778-6372

NUMBER OF BEDROOMS: 5 SEPTIC TANK SIZE: 1500 DRAINFIELD SIZE/TYPE: _____


LOCATION:	
NOTES:	Tie existing trenches into septic tank and abandon dry well.

ISSUED BY: Sarah Collins ISSUE DATE: 7/3/18 EXPIRATION DATE: 7/3/19

- NOTE: CONTRACTOR MUST SCHEDULE AN INSPECTION AND GAIN APPROVAL OF ALL COMPONENTS PRIOR TO COVERING
- NOTE: AN ELECTRICAL PERMIT IS REQUIRED FOR INSTALLATION OF ANY ELECTRICAL COMPONENTS OF THE SYSTEM
- NOTE: MDE RECOMMENDS SEPTIC TANKS, BAT, AND OTHER PRETREATMENT UNITS BE PUMPED AT A FREQUENCY ADEQUATE TO ENSURE THAT SOLIDS ARE NOT DISCHARGED TO THE DISPOSAL AREA

NEITHER THE HOWARD COUNTY COUNCIL NOR THE HEALTH DEPARTMENT IS RESPONSIBLE FOR THE SUCCESSFUL OPERATION OF ANY SYSTEM. PERMITTEE RESPONSIBLE FOR OBTAINING FINAL APPROVAL ON THIS PERMIT. CALL 410-313-1771 FOR INSPECTION OF SEPTIC SYSTEM.

NOT TO SCALE

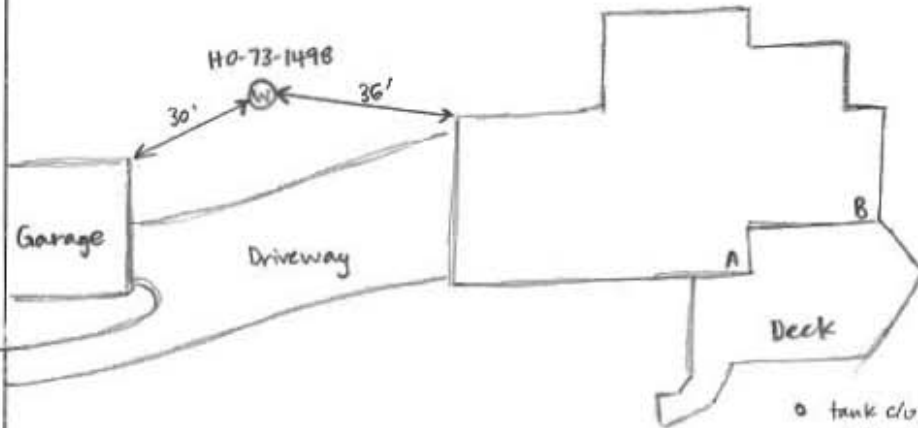

o tank c/w
 24' to A
 36' to B

3' tie-in to ex. line
 45' to A
 51' to B
 tie-in to
 ex. trenches

ROAD NAME

TRENCH/DRAINFIELD DATA

WIDTH _____ INLET _____ BOTTOM _____
 NUMBER OF TRENCHES _____
 TOTAL LENGTH _____
 ABSORPTION AREA _____
 DISTRIBUTION BOX LEVEL _____
 DISTRIBUTION BOX BAFFLE _____
 DISTRIBUTION BOX PORT _____


SEPTIC TANK DATA

SEPTIC TANK 1 LEVEL _____
 MANUFACTURER _____
 CAPACITY _____ GAL
 SEAM LOC _____
 TANK LID DEPTH _____
 BAFFLES _____
 BAFFLE FILTER _____
 MANHOLE LOC _____
 6" PORT LOC _____
 WATERTIGHT TEST _____
 SLOTTED _____
 DATE ON LID _____
 PUMP/SEPTIC TANK LEVEL _____
 MANUFACTURER _____
 CAPACITY _____ GAL
 SEAM LOC _____
 TANK LID DEPTH _____
 BAFFLES _____
 BAFFLE FILTER _____
 MANHOLE LOC _____
 6" PORT LOC _____
 WATERTIGHT TEST _____
 SLOTTED _____
 DATE ON LID _____

PRE-CONSTRUCTION:

INSTALLATION: 7/5/18 line run from existing inlet of drywell to D-box + trenches. Drywell already filled w/ #67 stone. J+A removed lid. Line off side of D-box had no fall - J+A dug below line to create fall. No speed levelers - J+A dug below other line to create equal flow to both trenches out of D-box. Checked flow with water. Stone at trenches is dry where lines enter @ inlet depth. [Corrective action completed.] (SC)

FINAL INSPECTOR Sarah Collins DATE OF APPROVAL 7/5/18

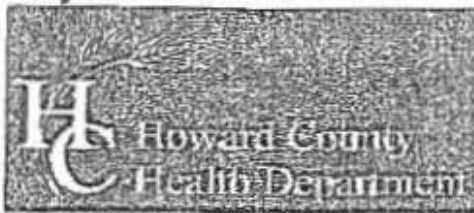

Bureau of Environmental Health

8930 Stanford Boulevard, Columbia, MD 21045

Main: 410-313-2640 | Fax: 410-313-2648

TDD 410-313-2323 | Toll Free 1-866-313-6300

www.hchealth.org

Facebook: www.facebook.com/hocohealth

Twitter: HowardCoHealthDep

Dr. Maura J. Rossman, M.D., Health Officer

INFORMATION FORM - SEPTIC SYSTEM REPAIR/UPGRADE

Reason for Request:

- Reason for Request:
[X] Failing System
[] System relocation for proposed addition
[] System upgrade for proposed addition
[] Inadequate treatment zone
[] Collapsed septic tank
[] Collapsed drywell

Has the septic tank been pumped within the last month?

- Has the septic tank been pumped within the last month?
[] Yes Date pumped:
[X] No

Was a visual inspection of the septic tank and/or drain fields conducted?

- Was a visual inspection of the septic tank and/or drain fields conducted?
[X] Yes Explain observations:
[] No

Existing system design

- Existing system design
[] Drywell
[X] Trench
[] Mound
[] Unknown
[] Other:

Was a visual inspection of the sewage line conducted?

- Was a visual inspection of the sewage line conducted?
[X] Yes
Blockage leading to the tank
[] Yes Explain:
[X] No
Blockage leading to the field
[] Yes Explain:
[X] No

Is discharge surfacing on the ground?

- Is discharge surfacing on the ground?
[] Yes
[X] No

[] No
Additional Comments:

*For REPAIRS, are the owners proposing, or do they plan to add in the future, any additions or modifications to the property, i.e. pools, living space additions, garages, etc? This information must be disclosed at the time of this application. The Health Department will not be able to accommodate requests in the field for property modifications unrelated to the repair request. Such requests may require an additional fee, testing, and submittal of a Percolation Certification Plan, if the property does not meet current Code and Regulation.

Septic Contractor: J+A Construction Services Contractor's Phone: 301-674-6930
Contractor's Address: PO Box 870 Mt. Airy MD 21771
Property Address: 587 W. Waterville Rd. County file:
Subdivision: Lot: Year Built: 2001
Owner's Name: John Piorowski Owner's Phone: 443-778-6372

Name of previous owners: Existing bedrooms:
Proposed bedrooms:

Has this request been previously discussed with a Sanitarian? (Name): Sarah
Public Sewer available/nearby: NO

*A Sanitarian will be in contact within three business days, depending upon the urgency of the situation, to coordinate the scheduling/review of the repair or upgrade.

Prior to scheduling inspections, scaled plans should be submitted to clarify the nature of the addition.

Print out a copy of Real Property Data via Dept. of Taxation website Indexed file found

If public sewer may be nearby, verify whether sewer is technically "available" through the Bureau of Engineering.

If sewer is available and the property is within the Metropolitan District, connection to sewer is required: If the owner believes reason for exemption exists, the owner should justify the request in writing.

If soil/site conditions are limited and sewer and/or Metro District status is not conducive to connection, the Sanitarian may recommend pursuit of Emergency Sewer Extension or Emergency Metro District Inclusion. The Owner should contact the Bureau of Utilities for details.

No permit is to be issued nor inspection to be scheduled without prior fee collection at the office unless an emergency situation exists. The contractor is to notify office of the emergency situation as soon as possible.



HOWARD COUNTY HEALTH DEPARTMENT

63045

DATE 7/3/18

PS

Received From

JEA Construction Services

PHONE #

301-409-8480

For

Repair / 38710. Watersville
Septic Repair

CASH

CHECK

NO.

12849

Fifty - Five

Dollars

\$

55 | 00

Received By

King