

WATER WELL ABANDONMENT-SEALING REPORT FORM

SUBMIT COPIES OF COMPLETED FORM TO:

- * COUNTY ENVIRONMENTAL AGENCY (contact MDE, WMA if address needed)
- * WELL OWNER
- * MDE, WATER MANAGEMENT ADMINISTRATION, WELL PROGRAM

DATE WELL ABANDONED: April 2, 2018 (month/day/year)OK
4/30/18 SC

* PERMIT NUMBER OF ABANDONED WELL (if any) _____

* PERMIT NUMBER OF REPLACEMENT WELL: _____

* PERSON ABANDONING WELL: Lester Simmons Sr. WELL DRILLER'S LICENSE NUMBER: 307CIRCLE: MWD / MSD / MGD* OWNER'S NAME: Renee Kurec

SITE LOCATION MAP

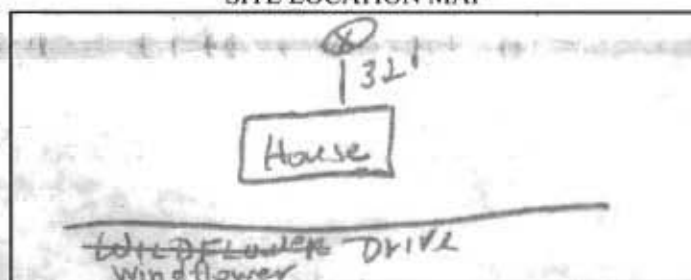
* WELL LOCATION:

COUNTY: HowardNEAREST TOWN: Ellicott City

TAX MAP _____ BLOCK _____ PARCEL _____

SUBDIVISION: _____

SECTION: _____ LOT: _____

STREET ADDRESS: 9910 WINDFLOWER DRIVELATITUDE 39.260352LONGITUDE 76.857144

LOG OF SEALING MATERIAL

MATERIAL	FEET	
	FROM	TO
Bentonite	43	3
Cement	3	2
Backfill	2	0

* TYPE OF WELL BEING ABANDONED:

☒ DRILLED ☐ JETTED
☐ BORED ☐ HAND DUG
☐ OTHER (specify) _____

* USE CODE:

☒ DOMESTIC ☐ MUNICIPAL/PUBLIC
☐ IRRIGATION ☐ INDUSTRIAL
☐ TEST/OBSERVATION ☐ GEOTHERMAL

* TYPE OF CASING:

☐ STEEL ☒ PLASTIC
☐ CONCRETE ☐ OTHER (specify) _____

VOLUME OF MATERIAL USED

700# mixed Bentonite 600#
 Cement - 100#

SIZE OF CASING: 6 INCHES IN DIAMETERDEPTH OF WELL: 43 FEET DEEPWAS ANY CASING REMOVED? ☒ YES ☐ NOIf yes, length removed, in feet: 3WAS CASING RIPPED OR PERFORATED? ☐ YES ☒ NOSIGNATURE-MASTER WELL DRILLER OR SUPERVISING SANITARIAN Beary F. Hartenbury LICENSE# 040

COUNTY

CIRCLE ONE MWD / MSD / MGSDATE April 4, 2018cc: SC 4-5-18
OC email