

HOWARD COUNTY HEALTH DEPARTMENT

P5 25640

Received Ha	fiele Equipment	PHONE # 301-854-6172
	519 annayoles Med 20701	PHONE # 39753
☐ CASH ⇒☐ CHECK	For Leptus Reposer Parint	
NO. 2416	One hundred sixty - five un	J co/job Dollars

Received By Mary & Bugge

PUB. SEWER STATE	JS VERIFIED BY	
ISSUE DATE: APPROVAL DATE:	11/27/06 Tax	ERMIT P 525640 A REPAIR - 2 4 594 GE DISPOSAL SYSTEM
Hatfields Equipment	HOWARD COUN	TY HEALTH DEPARTMENT IVIRONMENTAL HEALTH IS PERMITTED TO INSTALL ALTER
ADDRESS: POB	ox 519, Annapolis Junction	PHONE NUMBER: 301-854-6172
SUBDIVISION: A	nnandale	LOT NUMBER: 5
ADDRESS: 1715	Underwood Road	PROPERTY OWNER: Charles Snyder
SEPTIC TANK CAP	ACITY (GALLONS):	
PUMP CHAMBER C	APACITY (GALLONS):	Trench to be 2' wide Inlet @ 5' Bottom 9
NUMBER OF BEDROOMS:		3 4' of stone
SQUARE FEET PER	BEDROOM:	180
LINEAR FEET OF T	RENCH REQUIRED:	100
TRENCHES:	Trench to be 2' feet wide. Inlet feet below original grade. Bottom maximum depth feet below original grade. Effective area begins at 5' feet below original grade. feet of stone below distribution pipe.	
LOCATION:	Abre Dbox Dover	thy Downhall of Ea. S. T. Install Setucion the cathe) Electric Ling. 60' French Directly Below it.
PURPOSE:	Existing septic system h	as failed. Call for inspection when ground is opened so

		Existing septic system has failed. Call for inspection when ground is opened so sanitarian can recommend repair.	
--	--	--	--


NOTE: PERMIT VOID AFTER 2 YEARS

NOTE: CONTRACTOR RESPONSIBLE FOR SCHEDULING A PRE-CONSTRUCTION INSPECTION FOR ALL INSTALLATIONS

NOTE: WATERTIGHT SEPTIC TANKS REQUIRED

NOTE: ALL PARTS OF SEPTIC SYSTMEM SHALL BE 100 FEET FROM ANY WATER WELL NOTE: MANHOLE RISERS REQUIRED ON ALL SEPTIC TANKS AND PUMP CHAMBERS

NEITHER THE HOWARD COUNTY COUNCIL OR THE HEALTH DEPARTMENT IS RESPONSIBLE FOR THE SUCCESSFUL OPERATION OF ANY SYSTEM PERMITTEE RESPONSIBLE FOR OBTAINING FINAL APPROVAL ON THIS PERMIT CALL 410-313-2640 FOR INSPECTION OF SEPTIC SYSTEM

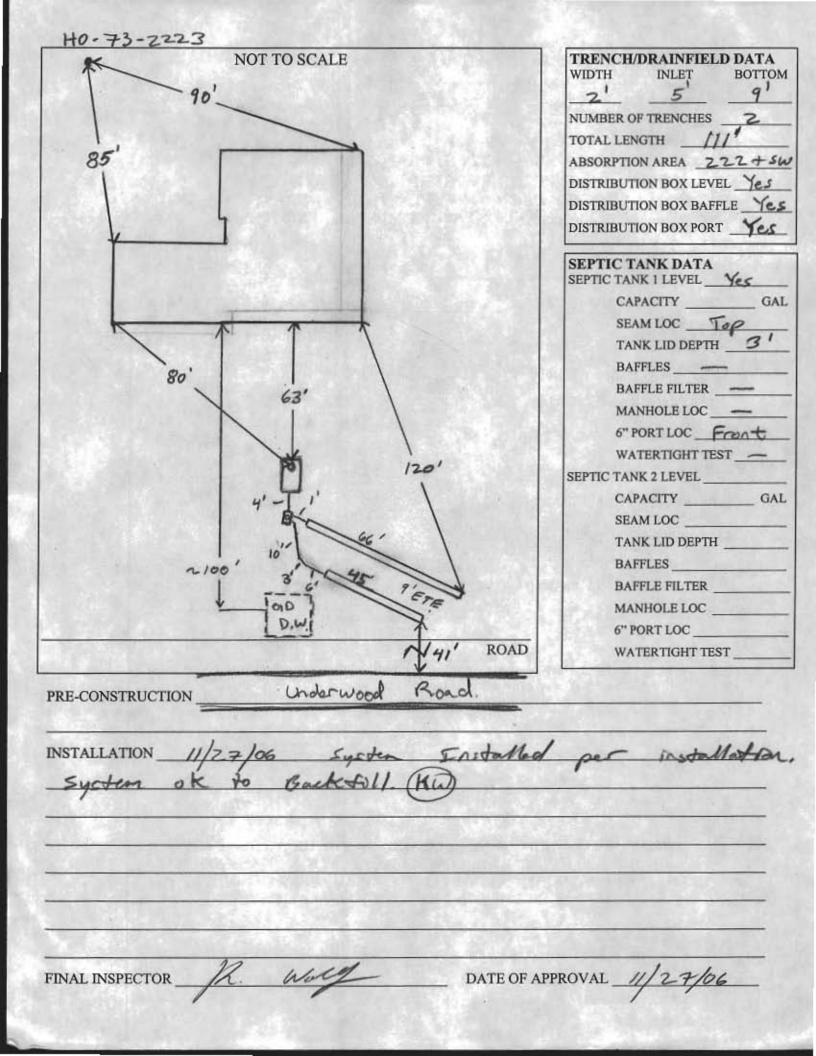

SEPTIC SYSTEM REPAIR / UPGRADE / EVALUATION REQUEST

Please fill out this form completely and check off the reason for the request:

Date requested:	
	Reason for Request
Failing System (includes surface discha	rge or inadequate treatment zone)
Has the contractor verified through e	excavation/pumping evaluation, that there are no pipe blockages?
In support of a building permit. Type o	f building addition:NA
*System relocation for proposed addition	on for setback compliance
*Verification of adequate system capaci	ity per COMAR 26.04.02.02D (4)
To replace collapsed septic tank or upgr	ade tank capacity
To replace collapsed drywell	****************
Septic Contractor:	Hatfields Egyipment
Contractor's Address:	8159 Brock Bridge R.
Contractor's Phone #:	301 - 854 6172
Property Address:	1715 Under wood RD
Property (Subdivision) & Lot #	
Owner's Name:	Chuck Snyder
Is public sewer available/nearby:	NIA
Names of Any Previous Owners:	142
Year House Built:	85 - 86
# of Existing Bedrooms:	3
# of Bedrooms after completion of addit	tion:
Has this request been discussed previous	A.
If public sewer is close, further researce public sewer.	h will be performed to verify availability and possible hook up to
	ree business days depending upon the urgency of the situation to upgrade/evaluation. No inspection will be performed without fee
	FAX TO 410-313-2648