



Building Permit Application

Howard County Maryland
Department of Inspections, Licenses and Permits
3430 Court House Drive
Permits: 410-313-2455
www.howardcountymd.gov

DILP 2018 JUN 20 AM 11:5

Date Received: _____

Permit No.: B18002194

Building Address: 3921 Walt Ann Dr
City: Fillicott City State: MD Zip Code: 21042
Suite/Apt. #: _____ SDP/WP/BA #: _____
Subdivision: _____
Lot: _____ Tax Map: _____ Parcel: 154

Existing Use: House / Single Family
Proposed Use: House / Single Family
Estimated Construction Cost: \$ 2500
Description of Work: set 500 gallon aboveground propane tank

Occupant/Tenant Name: _____
Was tenant space previously occupied? ☐ Yes ☐ No
Contact Name: _____
Address: _____
City: _____ State: _____ Zip Code: _____
Phone: _____ Fax: _____
Email: _____

Commercial Building Characteristics	Residential Building Characteristics
Height: _____	☒ SF Dwelling ☐ SF Townhouse
No. of stories: _____	Depth _____ Width _____
Gross area, sq. ft./floor: _____	1 st floor: _____
Area of construction (sq. ft.): _____	2 nd floor: _____
Use group: _____	Basement: _____
Construction type: _____	☐ Finished Basement
☐ Reinforced Concrete	☐ Unfinished Basement
☐ Structural Steel	☐ Crawl Space
☐ Masonry	☐ Slab on Grade
☐ Wood Frame	No. of Bedrooms: _____
☐ State Certified Modular	Multi-family Dwelling
	No. of efficiency units: _____
	No. of 1 BR units: _____
	No. of 2 BR units: _____
	No. of 3 BR units: _____
	Other Structure: _____
	Dimensions: _____
☒ Roadside Tree Project Permit	Footings: _____
☐ Yes ☒ No	Roof: _____
Roadside Tree Project Permit # _____	☐ State Certified Modular
	☐ Manufactured Home

Property Owner's Name: Andrew Chapin
Address: 3921 Walt Ann Dr
City: Fillicott City State: MD Zip Code: 21042
Phone: 202-415-2352 Fax: _____
Email: andychapin83@gmail.com

Applicant's Name & Mailing Address, (if other than stated herein)
Applicant's Name: Contractor
Address: _____
City: _____ State: _____ Zip Code: _____
Phone: _____ Fax: _____
Email: _____

Contractor Company: Ferrellgas
Contact Person: Christopher Mark Rickell
Address: 3601 Francis Scott Key Highway
City: Tanawtown State: MD Zip Code: 21787
License No.: 97169
Phone: 866-418-7680 Fax: _____
Email: markrickell@ferrellgas.com

Engineer/Architect Company: _____
Responsible Design Prof.: _____
Address: _____
City: _____ State: _____ Zip Code: _____
Phone: _____ Fax: _____
Email: _____

Utilities
Electric: ☐ Yes ☐ No
Gas: ☐ Yes ☐ No
Water Supply
☐ Public
☒ Private
Sewage Disposal
☐ Public
☒ Private
Heating System
☐ Electric ☐ Oil
☐ Natural Gas ☐ Propane Gas
☐ Other: _____
Sprinkler System:
☐ Yes ☐ No
Grading Permit Number:
Building Shell Permit Number:

THE UNDERSIGNED HEREBY CERTIFIES AND AGREES AS FOLLOWS: (1) THAT HE/SHE IS AUTHORIZED TO MAKE THIS APPLICATION; (2) THAT THE INFORMATION IS CORRECT; (3) THAT HE/SHE WILL COMPLY WITH ALL REGULATIONS OF HOWARD COUNTY WHICH ARE APPLICABLE THERETO; (4) THAT HE/SHE WILL PERFORM NO WORK ON THE ABOVE REFERENCED PROPERTY NOT SPECIFICALLY DESCRIBED IN THIS APPLICATION; (5) THAT HE/SHE GRANTS COUNTY OFFICIALS THE RIGHT TO ENTER ONTO THIS PROPERTY FOR THE PURPOSE OF INSPECTING THE WORK PERMITTED AND POSTING NOTICES.

Applicant's Signature: Christopher Mark Rickell
Print Name: Christopher Mark Rickell
Email Address: markrickell@ferrellgas.com
Title/Company: Material Handler / Ferrellgas

Date: 6-12-18

* mail * to Contractor

Check Payable to: DIRECTOR OF FINANCE OF HOWARD COUNTY

PLEASE WRITE NEATLY & LEGIBLY
-FOR OFFICE USE ONLY-

AGENCY	DATE	SIGNATURE OF APPROVAL
State Highways		
Building Officials		
PSZA (Zoning)		
PSZA (Engineering)		
Health	<u>7/9/18</u>	<u>RAT</u>
Is Sediment Control approval required for issuance? ☐ Yes ☐ No		
☐ CONTINGENCY CONSTRUCTION START		

DPZ SETBACK INFORMATION
Front: _____
Rear: _____
Side: _____
Side St.: _____
All minimum setbacks met? ☐ Yes ☐ No
Is Entrance Permit Required? ☐ Yes ☐ No
Historic District? ☐ Yes ☐ No
Lot Coverage for New Town Zone: _____
SDP/Red-line approval date: _____

Filing Fee	\$ <u>110</u>
Permit Fee	\$ <u>110</u>
Tech Fee	\$
Excise Tax	\$
PSFS	\$
Guaranty Fund	\$
Add'l per Fee	\$
Total Fees	\$
Sub- Total Paid	\$
Balance Due	\$
Check NO	<u>#K007061392420</u>


Distribution of Copies: White: Building Officials Green: PSZA, Zoning Yellow: PSZA, Engineering Pink: Health Gold: SHC

T:\Operations\Updated Forms\BuildingPermitApplication03.29.2018.docx

* per markus he reviewed everything *
OK to file

AK

S 53°08' E
439.37'

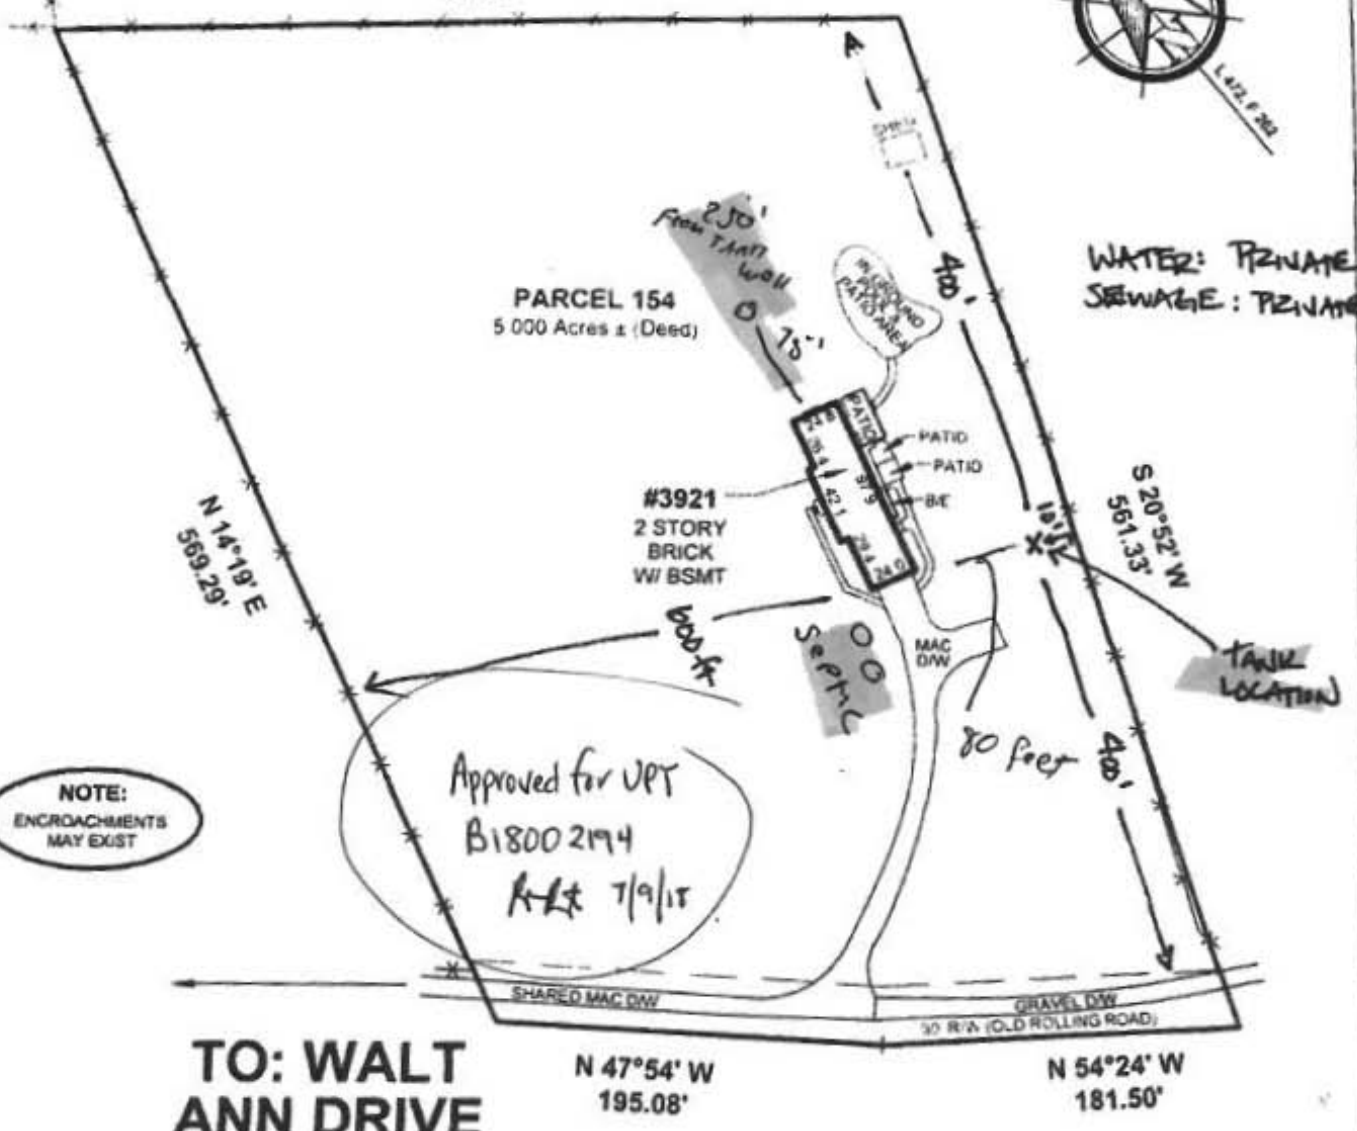

TORI PAIDE AND ANDREW CHAPIN

LOCATION DRAWING OF:
#3921 WALT ANN DRIVE
PARCEL 154
N/F PROPERTY OF
ROBERT E. & RACHELLE E. LUDICKE
LIBER: 472 FOLIO: 262
HOWARD COUNTY, MARYLAND
SCALE: 1"=100' DATE: 09-22-2015
DRAWN BY: CP / JCW FILE #: 156037-334

LEGEND:
- FENCE
- BASEMENT ENTRANCE
- BAY WINDOW
- BRICK
- BLDG. RESTRICTION LINE
- BSMT
- CONCRETE STOOP
- CONCRETE
- DRIVEWAY
- FRAME
- MACADAM
- OVERHANG
- PUBLIC UTILITY BSMT.
COLOR KEY:
(RED) RECORD INFORMATION
(BLUE) IMPROVEMENTS
(GREEN) EASEMENTS & RESTRICTION LINES

A Land Surveying Company
DULEY
and
Associates, Inc.
Serving D.C. and MD.
14604 Elm Street, Upper Marlboro, MD 20772
Phone: 301-888-1111 Fax: 301-888-1114
Email: orders@duley.biz On the web: www.duley.biz



SURVEYOR'S CERTIFICATE
I HEREBY STATE THAT I WAS IN RESPONSIBLE CHARGE OVER THE PREPARATION OF THIS DRAWING AND THE SURVEY WORK REFLECTED HEREIN AND IT IS IN COMPLIANCE WITH THE REQUIREMENTS SET FORTH IN REGULATION 12 CHAPTER 06.13.06 OF THE CODE OF MARYLAND ANNOTATED REGULATIONS. THIS SURVEY IS NOT TO BE USED OR RELIED UPON FOR THE ESTABLISHMENT OF FENCES, BUILDING, OR OTHER IMPROVEMENTS. THIS PLAT DOES NOT PROVIDE FOR THE ACCURATE IDENTIFICATION OF PROPERTY BOUNDARY LINES, BUT SUCH IDENTIFICATION MAY NOT BE REQUIRED FOR THE TRANSFER OF TITLE OR SECURING FINANCING OR REFINANCING. THIS PLAT IS OF BENEFIT TO A CONSUMER ONLY INsofar as IT IS REQUIRED BY A LENDER OR A TITLE INSURANCE COMPANY OR ITS AGENTS IN CONNECTION WITH THE CONTEMPLATED TRANSFER, FINANCING OR REFINANCING. THE LEVEL OF ACCURACY FOR THIS DRAWING IS 3". NO TITLE REPORT WAS FURNISHED TO NOR DONE BY THIS COMPANY. SAID PROPERTY SUBJECT TO ALL NOTES, RESTRICTIONS AND EASEMENTS OF RECORD. BUILDING RESTRICTION LINES AND EASEMENTS MAY NOT BE SHOWN ON THIS SURVEY. IMPROVEMENTS WHICH IN THE SURVEYOR'S OPINION APPEAR TO BE IN A STATE OF DISREPAIR OR MAY BE CONSIDERED "TEMPORARY" MAY NOT BE SHOWN. IF IT APPEARS ENCROACHMENTS MAY EXIST, A BOUNDARY SURVEY IS RECOMMENDED.

DULEY & ASSOC.
WILL GIVE YOU A 100%
FULL CREDIT TOWARDS
UPGRADING THIS
SURVEY TO A
"BOUNDARY/STAKE"
SURVEY FOR ONE
YEAR FROM THE DATE
OF THIS SURVEY
(EXCLUDING D.C. & BALT CITY)

11/14/67
Randy

PERMIT

SEWAGE DISPOSAL SYSTEM

MARYLAND STATE DEPARTMENT OF HEALTH

HOWARD COUNTY

P 15144

A 12798

A515240-C

ELLICOTT CITY

DISTRICT 3

DATE 10/6/67

INDEXED

03-290409

Walter A. Shank IS PERMITTED TO INSTALL X ALTER

ADDRESS Folly Quarter Rd., Ellicott City, Md. PHONE 531-5631

A SEWAGE DISPOSAL SYSTEM LOCATED AT

SUBDIVISION 3921 Walt Ann Drive
ROAD Old Rolling Rd. - 1st LOT a

PROPERTY OWNER Walter A. Shank dirt road on right after entering Shepherd's Glen

ADDRESS Ludicke

SPECIFICATIONS - 4 bedrooms

DRAIN FIELD DEPTH FEET, BOTTOM AREA SQ. FT.

SEEPAGE PITS ABSORBENT SIDE-WALL AREA SQ. FT.

SEPTIC TANK CAPACITY 1,000 GALLONS

FOR GARBAGE GRINDER, INCREASE DISPOSAL AREA 22% & TANK CAPACITY 50%.

OTHER Dry well - 400 sq. ft. sidewall area below inlet with a maximum depth of 10 ft. OR Tile field with 400 sq. ft. bottom area installed no deeper than 5 ft. below grade.

If dry well used place it 270 ft. from the back lot line and 160 ft. from the right side of the lot as seen when facing the lot from Old Rolling Rd. If tile field used place it 250 ft. to 340 ft. from the back lot line and 150 ft. to 175 ft. from the right side of the lot as seen when facing the lot from Folly Quarter Road.

PERMIT VOID AFTER THREE YEARS.

PLANS APPROVED BY Raymond Hedges DATE 7/6/67

FILL SEPTIC TANK AND DISTRIBUTION BOX WITH WATER BEFORE CALLING FOR AN INSPECTION. COVER NO WORK UNTIL INSPECTED AND APPROVED.

NEITHER THE HOWARD COUNTY COMMISSIONERS NOR THE HEALTH DEPARTMENT IS RESPONSIBLE FOR THE SUCCESSFUL OPERATION OF ANY SYSTEM.


SCUG. PERMIT SIGNED
AND RETURNED 3/21/2007

800 129 094 WOODSHED

NOTIFY THE HEALTH DEPARTMENT 48 HOURS
BEFORE EXCAVATIONS ARE TO BE BACK FILLED.

A 12798

A515240-C

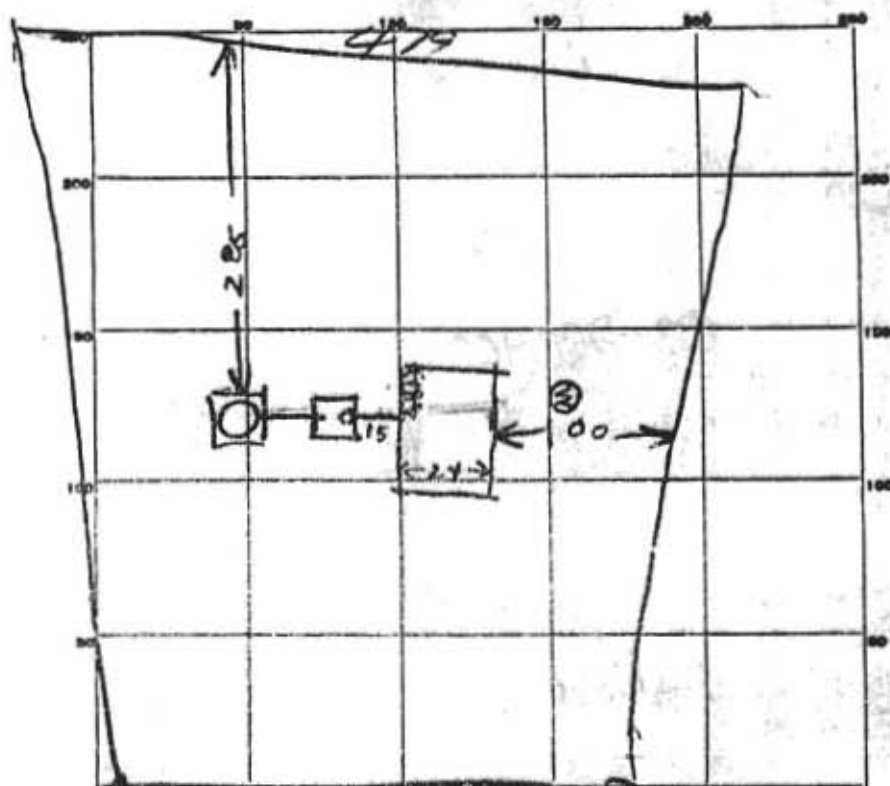

INDICATE NORTH - NAME ADJOINING ROADWAY AS BASE LINE.

OLD POLLING RD

PERMIT CARD

SEPTIC TANK, LEVEL OK 1000 concrete CLEAN OUT OK

Top is 4 FT below grade

DISTRIBUTION BOX, LEVEL

TILE FIELD, DEPTH _____ FT. TRENCH WIDTH _____ FT.

GRAVEL DEPTH _____ IN. TOTAL LENGTH _____ FT.

NUMBER OF TRENCHES _____ TOTAL BOTTOM AREA _____

SEEPAGE PITS, INSIDE DIAMETER 12 FT. DEPTH BELOW INLET 9 1/2 FT.

ABSORBENT AREA 495 SQ. FT. counting stone not counting stone

REMARKS Dry Well Inlet is 3 FT to 5 FT below grade

Depth below grade is 12 FT

Perimeter of Hole is 52 FT 495 sq ft

adrenal area counting stone

Told well driller to go out well Arthur Edmonson

Funkeburg Project #2

DATE SYSTEM APPROVED

14 NOV 67

INSPECTOR

P. J. Hodge

THE UNDERSIGNED HEREBY CERTIFIES AND AGREES AS FOLLOWS: (1) THAT HE/SH/IT IS AUTHORIZED TO MAKE THIS APPLICATION, (2) THAT THE INFORMATION IS CORRECT, (3) THAT HE/SH/IT WILL COMPLY WITH ALL REGULATIONS OF BUREAU OF LANDS WHERE APPLICABLE THEREON, (4) THAT HE/SH/IT WILL PERFORM NO WORK ON THE ABOVE REFERENCED PROPERTY NOT SPECIFICALLY DESCRIBED IN THIS APPLICATION, (5) THAT HE/SH/IT GRANTS EXCLUSIVE CONTROL OF THE RIGHT TO ENTER UPON THE PROPERTY TO THE BUREAU OF LANDS FOR THE PURPOSES OF SURVEYING THE PROPERTY, AND FURTHER HEREBY

Date 3.20.2001

- FOR OFFICE USE ONLY -

- FOR OFFICE USE ONLY

PROPERTY ID#	217045
Filing fee	\$ 20.00
Permit fee	\$ 10.00
Excise tax	\$ 0.00
Sub-total paid	\$ 30.00
Add'l permit fee	\$ 0.00
TOTAL FEES	\$ 30.00

Balance due	\$	2125
Check	#	2125

1999, 2000, 2001, 2680, 26

Lot Coverage for NewTown Zone
SDP/Red-line approval date

Accepted by

—

Approved for: David A. [Signature] Date: 10/11/98 Rev. 10/11/98

