


260 W Woodbine Road  
Woodbine, MD 21797  
Scale 1" = 100'

LEGEND

- Property Line
- Measurements
- House
- 500 Gallon above ground LP Tank
- Septic
- Well

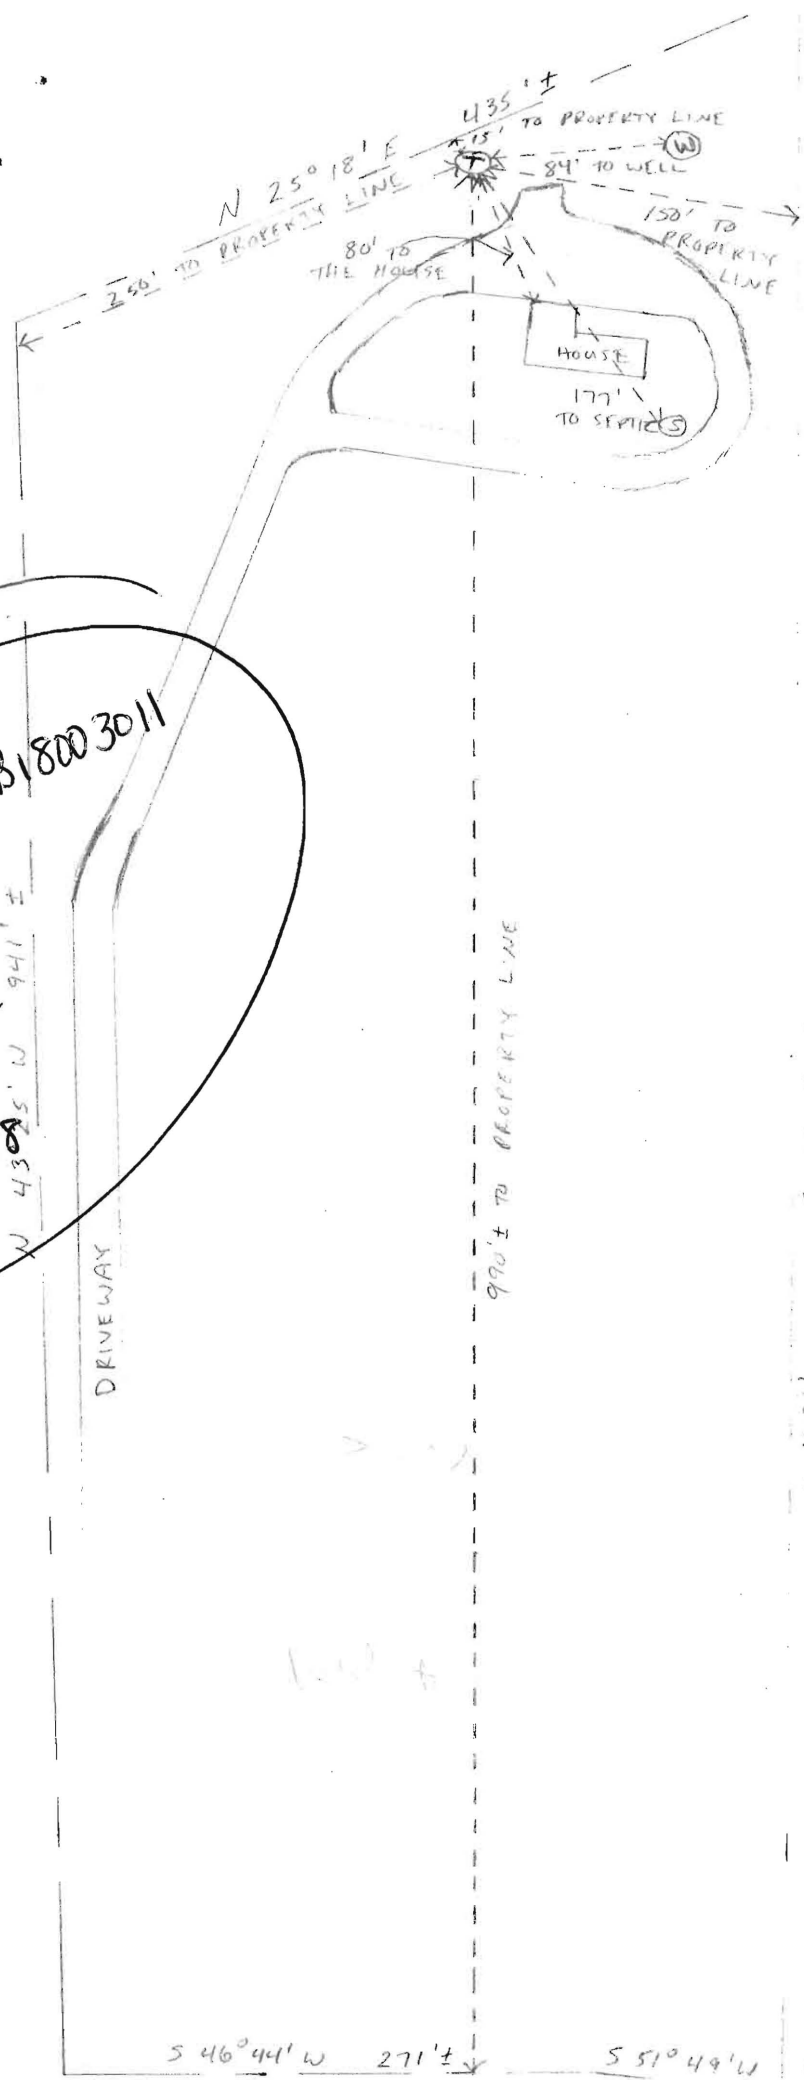

Approved for UPT B18003011  
R ~~AD~~ 9/21/18  
Field verified  
well's septic  
setbacks  
on 9/21/18