

# APPLICATION

PERCOLATION TESTING

A 47654  
P \_\_\_\_\_

HOWARD COUNTY HEALTH DEPARTMENT  
BUREAU OF ENVIRONMENTAL HEALTH  
P.O. BOX 476 ELLICOTT CITY, MARYLAND 21043  
TELEPHONE: 461-9933

DISTRICT 5th  
12/05/91  
DATE 10/25/91

TO: THE COUNTY HEALTH OFFICER  
ELLICOTT CITY, MARYLAND

I HEREBY APPLY FOR THE NECESSARY TEST IN ORDER TO CONSTRUCT (OR RECONSTRUCT) A SEWAGE DISPOSAL SYSTEM.

PROPERTY OWNER Potomac Electric Power Company

ADDRESS 1900 Pennsylvania Ave. N.W. Washington PHONE 202-872-3526  
DC 20068

PROSPECTIVE BUYER \_\_\_\_\_

ADDRESS \_\_\_\_\_ PHONE \_\_\_\_\_

PROPERTY LOCATION:

SUBDIVISION Waterman Estates LOT NO. 22

ROAD AND DESCRIPTION Brown Bridge Road

TAX MAP 40 PARCEL # \_\_\_\_\_

SIZE OF LOT 3.80 acres TYPE BLDG. Single Family Dwelling  
(SINGLE FAMILY DWELLING OR COMMERCIAL)

THE SYSTEM INSTALLED UNDER THIS APPLICATION IS ACCEPTABLE ONLY UNTIL PUBLIC FACILITIES BECOME AVAILABLE. I FULLY UNDERSTAND THE FEE CONNECTED WITH THE FILING OF THIS PERC TEST APPLICATION IS NON-REFUNDABLE UNDER ANY CIRCUMSTANCES. I ALSO AGREE TO COMPLY WITH ALL M.O.S.H.A. REQUIREMENTS IN TESTING THIS LOT.

[Signature]

(SIGNATURE OF APPLICANT)

APPROVED BY \_\_\_\_\_ FOR \_\_\_\_\_ DATE \_\_\_\_\_

REJECTED BY \_\_\_\_\_ FOR \_\_\_\_\_ DATE \_\_\_\_\_

HOLD PENDING FURTHER TESTS \_\_\_\_\_ DATE \_\_\_\_\_



REASONS FOR REJECTION OR HOLDING 12/26/91 PERC OK HOLD FOR PLAT R/H

HD-216

# THIS IS NOT A PERMIT




Lot 22  
LA 47654

PETRILO DIR

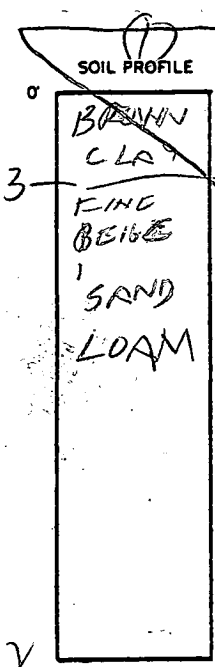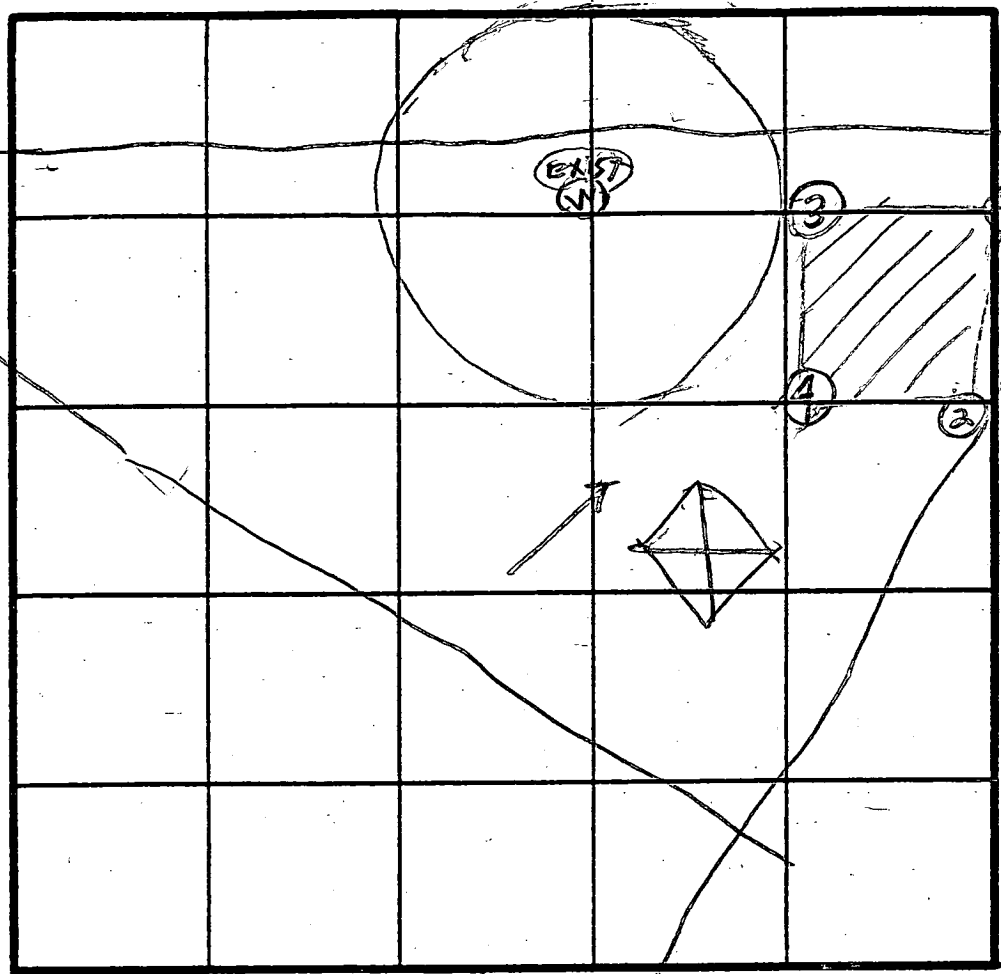

$I = 9$

SHALLOW  
INLET 3 FT  
DEPTH 5 FT  
DEPTH STONE 2 FT  
WIDTH 3 FT

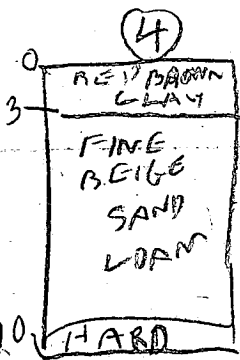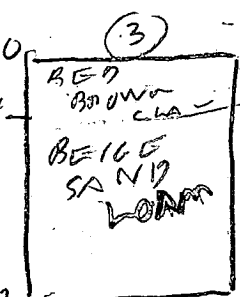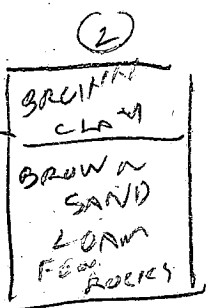

INDICATE NORTH - NAME ADJOINING ROADWAY AS BASE LINE.

DATE	TEST NO.	DEPTH	PRE-WET		TEST - 1" DROP		TIME
			START	STOP	START	STOP	
12/19/91	15 (309)	3 1/2	1222	1224	1224	1228	4
	11	12	OK				
	25	3	1225	1240	1240	1259	19
	2	12	OK				
	35 (310)	3	1233	1241	1241	1250	7
	38	12	OK				
	45 (311)	13	1253	1258	1258	1,02	4
	42	10	OK	SHALLOW			

REMARKS Under Dig Per Survey Test Plat OK SHALLOW

TYPE OF SOIL \_\_\_\_\_

TESTED BY R. HODGES

Backhoe  
ALSO PRESENT K. HATFIELD  
Engineer MAJID ABEDI