

July 19, 2012

Mr. Davis,

We are writing this letter to request a variance for placement of a underground LP-Gas tank at 3836 Walt Ann Dr, Ellicott City, MD 21042. District - 03 Account Number – 285502, Map 22, Grid 016 Parcel 145 Lot 14. The well in use is 65 feet away. The location is the only place the tank can be placed on the property to stay away from fire code as well as the septic area and still conveniently reach to fill. We hope that you take this into consideration and approve this variance for this location.

Thank you.

ThompsonGas will be installing and servicing the underground 500 gallon tank. If approved or declined please call Zachary Mentzer at 301-964-0365 and mail a signed copy of this letter to:

ThompsonGas Attn: Zach Mentzer PO Box 158 Boonsboro, MD 21713




Julie Anthony

Property Owner

Approved by: _____



Date: _____

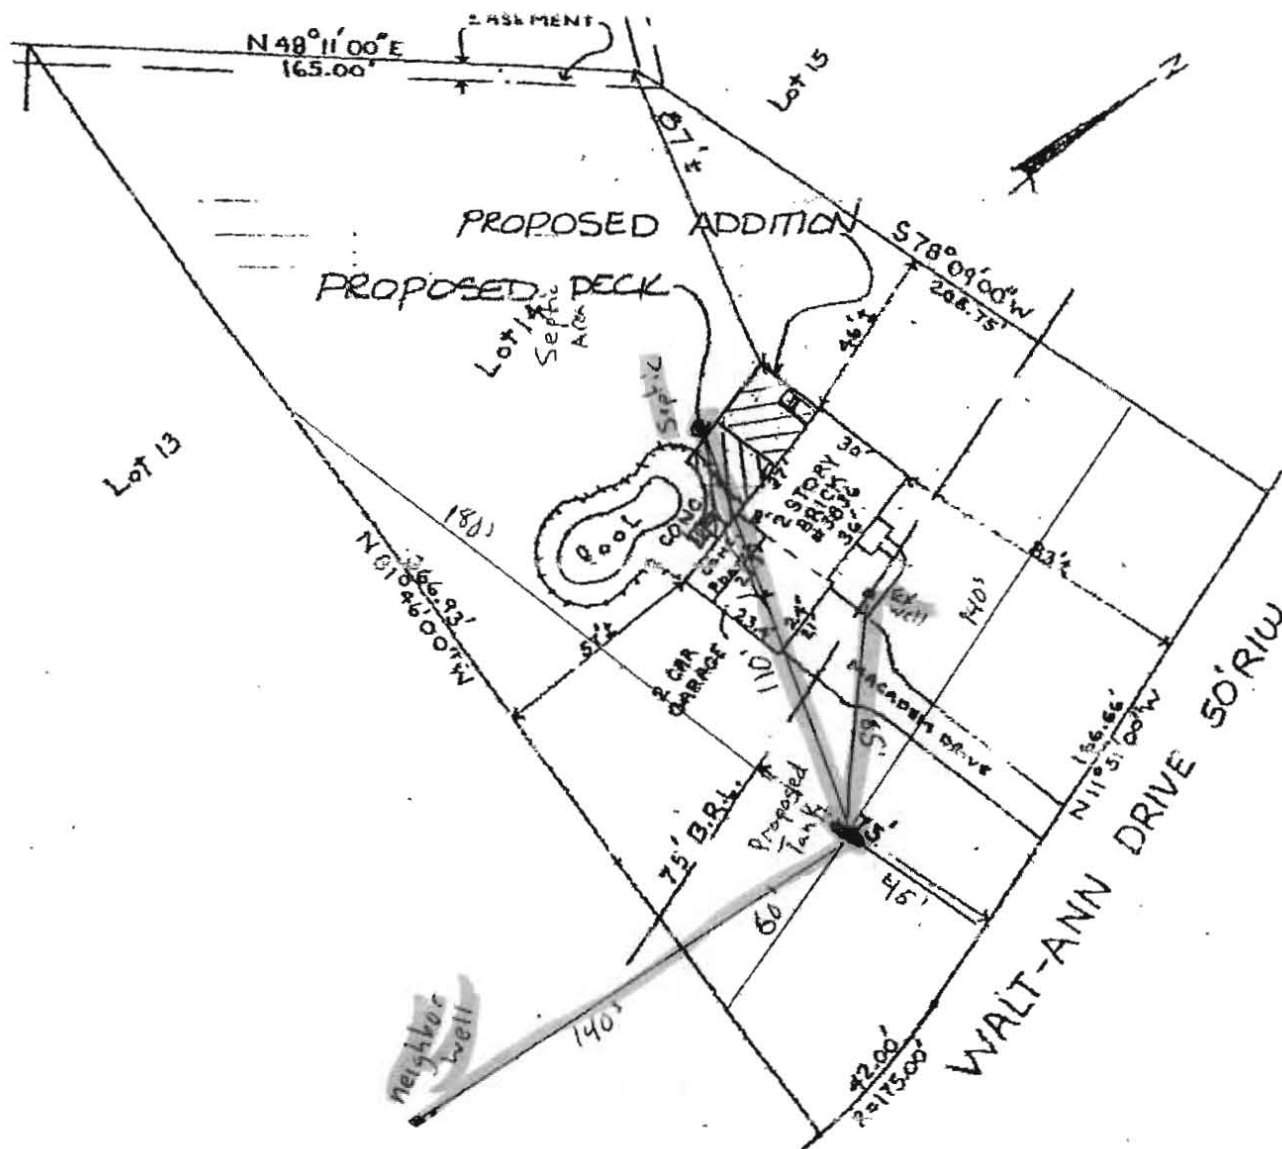

SITE PLAN

SCALE 1" = 50'

ANTHONY RESIDENCE

MR. & MRS. TONY ANTHONY
3036 WALT ANN DRIVE
ELLICOTT CITY, MARYLAND 21043

26 MAY 80



CRAIG L STEWART
ARCHITECT PC

8329 MAIN STREET
ELLICOTT CITY, MD 21043

301-465-7687 (BALT.)