

PUB. SEWER STATUS VERIFIED BY \_\_\_\_\_

ISSUE DATE: 04/21/05

P 522415

APPROVAL DATE: 5/6/05

A P28080

**PERMIT**

**INDEXED**

**03267947**

**ON-SITE SEWAGE DISPOSAL SYSTEM  
HOWARD COUNTY HEALTH DEPARTMENT  
BUREAU OF ENVIRONMENTAL HEALTH**

Fyock Septic Service

IS PERMITTED TO INSTALL ☐ ALTER ☒

ADDRESS: PO Box 89, Glenelg MD 21737

PHONE NUMBER: 410-988-9270

SUBDIVISION: Shepards Glen

LOT NUMBER: 6

ADDRESS: 3901 Walt Ann Drive

PROPERTY OWNER: Thomas Kozel

SEPTIC TANK CAPACITY (GALLONS): \_\_\_\_\_

PUMP CHAMBER CAPACITY (GALLONS): \_\_\_\_\_

NUMBER OF BEDROOMS: 3

SQUARE FEET PER BEDROOM: 210

LINEAR FEET OF TRENCH REQUIRED: 120'

*3-40' Trenches  
Inlet 6'  
Bottom 8'  
3' Wide*

TRENCHES:	Trench to be _____ feet wide. Inlet _____ feet below original grade. Bottom maximum depth _____ feet below original grade. Effective area begins at _____ feet below original grade. _____ feet of stone below distribution pipe.
LOCATION:	
PURPOSE:	Existing septic system has failed. Call for inspection when ground is opened so sanitarian can recommend repair.

PLANS APPROVED: \_\_\_\_\_

DATE: \_\_\_\_\_

NOTE: PERMIT VOID AFTER 2 YEARS

NOTE: CONTRACTOR RESPONSIBLE FOR SCHEDULING A PRE-CONSTRUCTION INSPECTION FOR ALL INSTALLATIONS

NOTE: WATERTIGHT SEPTIC TANKS REQUIRED

NOTE: ALL PARTS OF SEPTIC SYSTEM SHALL BE 100 FEET FROM ANY WATER WELL


NOTE: MANHOLE RISERS REQUIRED ON ALL SEPTIC TANKS AND PUMP CHAMBERS

**NEITHER THE HOWARD COUNTY COUNCIL OR THE HEALTH DEPARTMENT IS  
RESPONSIBLE FOR THE SUCCESSFUL OPERATION OF ANY SYSTEM  
PERMITTEE RESPONSIBLE FOR OBTAINING FINAL APPROVAL ON THIS PERMIT  
CALL 410-313-2640 FOR INSPECTION OF SEPTIC SYSTEM**

522415

NOT TO SCALE

Neighbors  
Well?

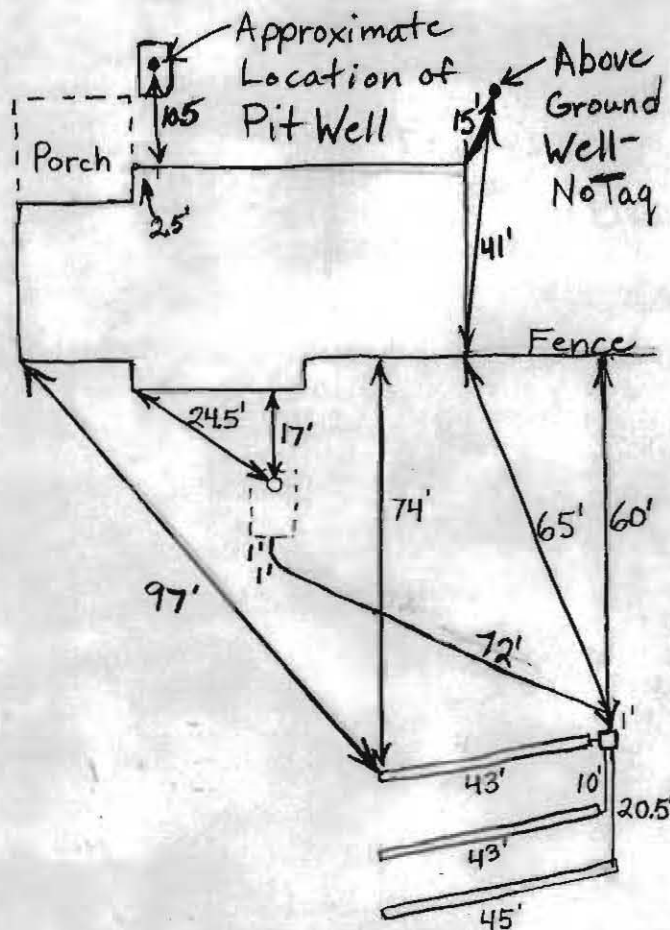

TRENCH/DRAINFIELD DATA		
WIDTH	INLET	BOTTOM
3'	6'	8'
NUMBER OF TRENCHES 3		
TOTAL LENGTH 131'		
ABSORPTION AREA 393 + Sidewall		
DISTRIBUTION BOX LEVEL Leveles		
DISTRIBUTION BOX BAFFLE Yes		
DISTRIBUTION BOX PORT No		

SEPTIC TANK DATA	
SEPTIC TANK 1 LEVEL	
CAPACITY	Existing GAL
SEAM LOC	Midseam
TANK LID DEPTH	5.5'
BAFFLES	Replaced Rear
BAFFLE FILTER	No
MANHOLE LOC	None
6" PORT LOC	Front
WATERTIGHT TEST	No
SEPTIC TANK 2 LEVEL N/A	
CAPACITY	GAL
SEAM LOC	
TANK LID DEPTH	
BAFFLES	
BAFFLE FILTER	
MANHOLE LOC	
6" PORT LOC	
WATERTIGHT TEST	

Walt Ann Drive

PRE-CONSTRUCTION 5/2/05 To install 3 - 40' trenches 10' from right property line. Stay 100' from all wells. Must locate.

INSTALLATION neighbors well. Pump out and fill in drywell. (BB)

5/6/05 Neighbors well located and > 100' from trenches. Drywell pumped out and filled with dirt. O.K. to cover everything. (BB)

FINAL INSPECTOR B Baker DATE OF APPROVAL 5/6/05