

FB



APPLICATION

FOR PERCOLATION TESTING AND SITE EVALUATION

TEST DATE(S) _____ TEST TIME _____ AVP 527232

AGENCY REVIEW: _____ DATE 6/29/07

DO NOT WRITE ABOVE THIS LINE

I HEREBY APPLY FOR THE NECESSARY TESTING/EVALUATION PRIOR TO ISSUANCE OF SEWAGE DISPOSAL SYSTEM PERMIT(S) TO:

CHECK AS NEEDED:

- CONSTRUCT NEW SEPTIC SYSTEM(S)
- REPAIR/ADD TO AN EXISTING SEPTIC SYSTEM
- REPLACE AN EXISTING SEPTIC SYSTEM

CHECK AS NEEDED:

- NEW STRUCTURE(S)
- ADDITION TO AN EXISTING STRUCTURE
- REPLACE AN EXISTING STRUCTURE

CHECK ONE:

- CREATE NEW LOT(S)
- BUILD ON AN EXISTING LOT IN A SUBDIVISION
- BUILD ON AN EXISTING PARCEL OF RECORD

IS THE PROPERTY WITHIN 2500' OF ANY RESERVOIR?

- YES
- NO

THE TYPE OF STRUCTURE IS:

- RESIDENTIAL WITH _____ PROPOSED BEDROOMS IN THE COMPLETED STRUCTURE (NOTE **UNKNOWN** IF APPROPRIATE)
- COMMERCIAL (PROVIDE DETAIL OF NUMBERS AND TYPES OF EMPLOYEES/ CUSTOMERS ON ACCOMPANYING PLAN)
- INSTITUTIONAL/GOVERNMENT (PROVIDE DETAIL OF NUMBERS AND TYPES OF EMPLOYEES/USERS ON ACCOMPANYING PLAN)

PROPERTY OWNER(S) Scott and Diana Hendricks

DAYTIME PHONE 443 266 7066 CELL 240 461 2728 FAX _____

MAILING ADDRESS 2000 WOODBINE RD WOODBINE MD 21797
STREET CITY/TOWN STATE ZIP

APPLICANT Scott and Diana Hendricks

DAYTIME PHONE 443 266 7066 CELL 240 461 2728 FAX _____

MAILING ADDRESS 2000 WOODBINE RD WOODBINE MD 21797
STREET CITY/TOWN STATE ZIP

APPLICANT'S ROLE: DEVELOPER BUILDER BUYER RELATIVE/FRIEND REALTOR CONSULTANT

PROPERTY LOCATION
SUBDIVISION/PROPERTY NAME _____ LOT NO. _____


PROPERTY ADDRESS 2000 WOODBINE RD WOODBINE MD
STREET TOWN/POST OFFICE

TAX MAP PAGE(S) _____ GRID _____ PARCEL(S) _____ PROPOSED LOT SIZE _____

AS APPLICANT, I UNDERSTAND THE FOLLOWING: THE SYSTEM INSTALLED SUBSEQUENT TO THIS APPLICATION IS ACCEPTABLE ONLY UNTIL PUBLIC SEWERAGE IS AVAILABLE. THIS APPLICATION IS COMPLETE WHEN ALL APPLICABLE FEES AND A SUITABLE SITE PLAN HAVE BEEN RECEIVED. I ACCEPT THE RESPONSIBILITY FOR COMPLIANCE WITH ALL M.O.S.H.A. AND "MISS UTILITY" REQUIREMENTS. APPROVAL IS BASED UPON SATISFACTORY REVIEW OF A PERC CERTIFICATION PLAN.

TEST RESULTS WILL BE MAILED TO APPLICANT. Scott D Hendricks
SIGNATURE OF APPLICANT

HOWARD COUNTY HEALTH DEPARTMENT, BUREAU OF ENVIRONMENTAL HEALTH, WELL AND SEPTIC PROGRAM
3525-H ELLICOTT MILLS DRIVE, ELLICOTT CITY, MARYLAND 21043-4544 (410) 313-1771 FAX (410) 313-2648
TDD (410) 313-2323 TOLL FREE 1-877-4MD-DHMH

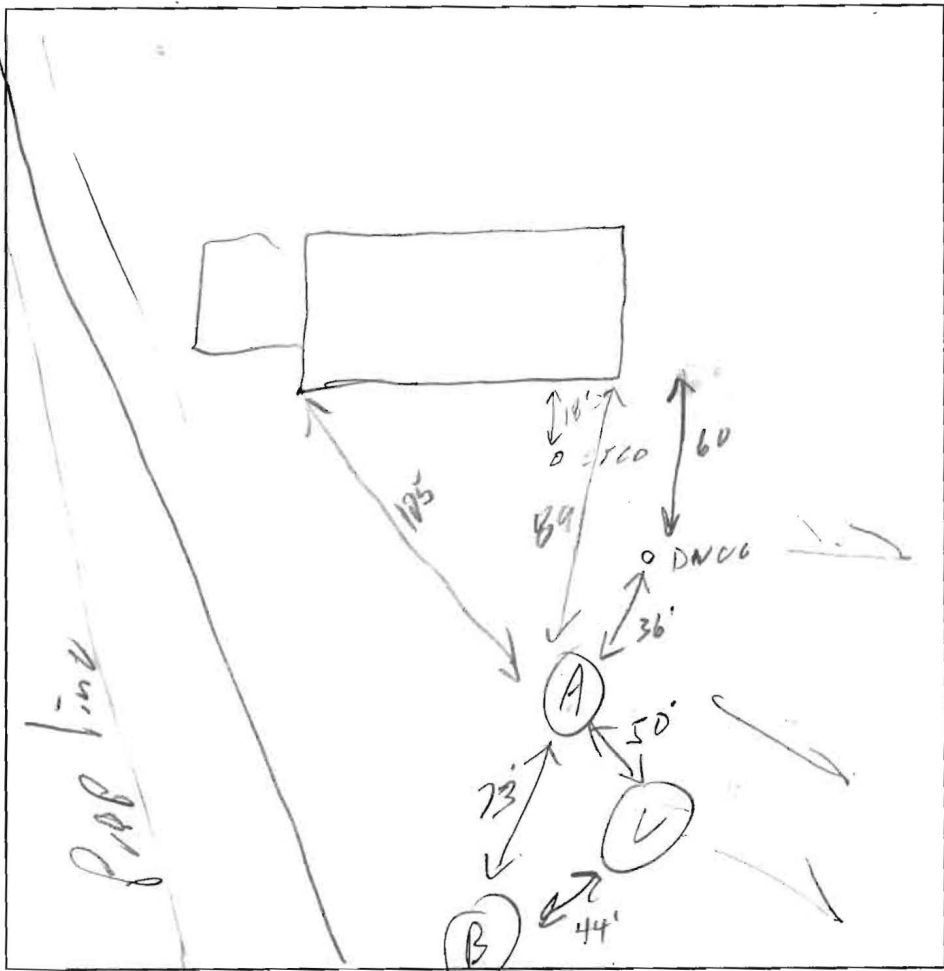

6" Topsoil
Orange clay loam
4" Tan Loam
20% Rx

12" Same As (A)

6" (C) Topsoil
Orange Clay Loam
4" Tan Loam
40% Rx


| DATE | TEST # | DEPTH | START | BREAK 1" DROP | STOP 2" DROP | TIME OF 2nd INCH | P/F/H |
|---------|--------|-----------------------|-------|---------------|--------------|------------------|-------|
| 11/5/07 | A | 4.5' 12' | 12:39 | 12:45 | 12:58 | 13 | P |
| | B | 5.5' 11' | 12:59 | 1:01 | 1:05 | 4 | P |
| | C | Visual 11' | | | | | |
| | | | | | | | |
| | | | | | | | |
| | | | | | | | |
| | | | | | | | |

REMARKS _____

SANITARIAN SFO BACKHOE Jake OTHERS Scott (Homeowner)

TEST HOLES USED IN SDA _____ AVG. PERC TIME _____ SQ. FT/BR _____

TRENCH WIDTH _____ INLET DEPTH _____ MAX. BOT DEPTH _____ EFFECTIVE SMW _____

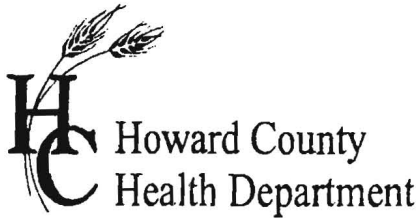

APPLICATION

FOR PERCOLATION TESTING AND SITE EVALUATION

TEST DATE(S) _____ TEST TIME _____ A/P _____

AGENCY REVIEW: _____ DATE _____

DO NOT WRITE ABOVE THIS LINE

I HEREBY APPLY FOR THE NECESSARY TESTING/EVALUATION PRIOR TO ISSUANCE OF SEWAGE DISPOSAL SYSTEM PERMIT(S) TO:

CHECK AS NEEDED:

- CONSTRUCT NEW SEPTIC SYSTEM(S)
- REPAIR/ADD TO AN EXISTING SEPTIC SYSTEM
- REPLACE AN EXISTING SEPTIC SYSTEM

CHECK AS NEEDED:

- NEW STRUCTURE(S)
- ADDITION TO AN EXISTING STRUCTURE
- REPLACE AN EXISTING STRUCTURE

CHECK ONE:

- CREATE NEW LOT(S)
- BUILD ON AN EXISTING LOT IN A SUBDIVISION
- BUILD ON AN EXISTING PARCEL OF RECORD

IS THE PROPERTY WITHIN 2500' OF ANY RESERVOIR?

- YES
- NO

THE TYPE OF STRUCTURE IS:

- RESIDENTIAL WITH _____ PROPOSED BEDROOMS IN THE COMPLETED STRUCTURE (NOTE *UNKNOWN* IF APPROPRIATE)
- COMMERCIAL (PROVIDE DETAIL OF NUMBERS AND TYPES OF EMPLOYEES/ CUSTOMERS ON ACCOMPANYING PLAN)
- INSTITUTIONAL/GOVERNMENT (PROVIDE DETAIL OF NUMBERS AND TYPES OF EMPLOYEES/USERS ON ACCOMPANYING PLAN)

PROPERTY OWNER(S) Scott Hendricks

DAYTIME PHONE 240 461 2728 CELL _____ FAX _____

MAILING ADDRESS 2000 Woodbine Rd Woodbine MD
STREET CITY/TOWN STATE ZIP

APPLICANT Fogle's Septic Clean Inc

DAYTIME PHONE 410 795-5670 CELL _____ FAX _____

MAILING ADDRESS 580 Obrecht Rd Sykes
STREET CITY/TOWN STATE ZIP

APPLICANT'S ROLE: DEVELOPER BUILDER BUYER RELATIVE/FRIEND REALTOR CONSULTANT

PROPERTY LOCATION
SUBDIVISION/PROPERTY NAME 2000 Woodbine Rd LOT NO. _____

PROPERTY ADDRESS _____
STREET TOWN/POST OFFICE Woodbine

TAX MAP PAGE(S) _____ GRID _____ PARCEL(S) _____ PROPOSED LOT SIZE _____

AS APPLICANT, I UNDERSTAND THE FOLLOWING: THE SYSTEM INSTALLED SUBSEQUENT TO THIS APPLICATION IS ACCEPTABLE ONLY UNTIL PUBLIC SEWERAGE IS AVAILABLE. THIS APPLICATION IS COMPLETE WHEN ALL APPLICABLE FEES AND A SUITABLE SITE PLAN HAVE BEEN RECEIVED. I ACCEPT THE RESPONSIBILITY FOR COMPLIANCE WITH ALL M.O.S.H.A. AND "MISS UTILITY" REQUIREMENTS. APPROVAL IS BASED UPON SATISFACTORY REVIEW OF A PERC CERTIFICATION PLAN.

TEST RESULTS WILL BE MAILED TO APPLICANT. Kent A. Cassell
SIGNATURE OF APPLICANT

HOWARD COUNTY HEALTH DEPARTMENT, BUREAU OF ENVIRONMENTAL HEALTH, WELL AND SEPTIC PROGRAM
3525-H ELLICOTT MILLS DRIVE, ELLICOTT CITY, MARYLAND 21043-4544 (410) 313-1771 FAX (410) 313-2648
TDD (410) 313-2323 TOLL FREE 1-877-4MD-DHMH



Bureau of Environmental Health
7178 Columbia Gateway Drive, Columbia, MD 21046-2147
(410) 313-2640 Fax (410) 313-2648
TDD (410) 313-2323 Toll Free 1-866-313-6300
website: www.hchealth.org

Peter L. Beilenson, M.D., M.P.H., Health Officer

MEMO

Date: July 6, 2007

To: Scott and Diana Hendricks, Homeowners

From: Robert Bricker, Environmental Sanitarian
Well and Septic Program

RE: Percolation Test Application, 2000 Woodbine Road
A527232

Dear Mr. & Mrs. Hendricks,

I have received your application to conduct percolation testing on your property at 2000 Woodbine Road. At this time, your application is being rejected. The reason for this action is that the Percolation Test Plan must be submitted on a record plat (i.e. a surveyor's plat, a formal property plat with boundaries described by bearing and distance). Preferably the plan also will show the (surveyed) locations of the existing house and all other existing structures on the subject property as well as the existing septic system and the well. Other features desired for percolation testing to be scheduled include locations of neighbors' wells and septic systems, elevation contour lines, a proposed septic easement and (within that easement) five percolation test locations.

Percolation tests are conducted to define a septic easement on your property. The septic easement is then described formally on a Percolation Certification Plan and submitted for approval by the Howard County Health Officer. Certain content must appear on the plan for approval. With this memo, I have included lists of Percolation Certification Plan content requirements and the regulated setback distances relating to wells and septic systems. Both of these documents are excerpted from the Howard County Code.

If you are not ready to pursue this project at this time or in the near future, you may request a refund of your Percolation Test Application fee. If you wish to move forward with this project, please contact me. In either case, the phone number for the Bureau of Environmental Health is 410-313-1771.

RB
file

11/5/07

Fax to: Bureau of Environ. Health

attn: Robert Bricker

fax #: 410 313 2648

3 pages



From: SCOTT HENDRICKS

443 266 7066

2000 WOODBINE RD

WOODBINE MD 21797

cell 240 461-2728

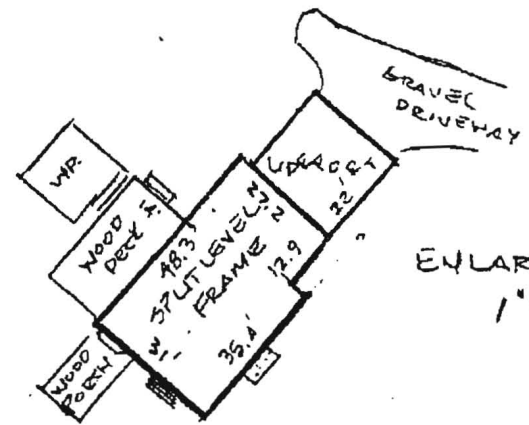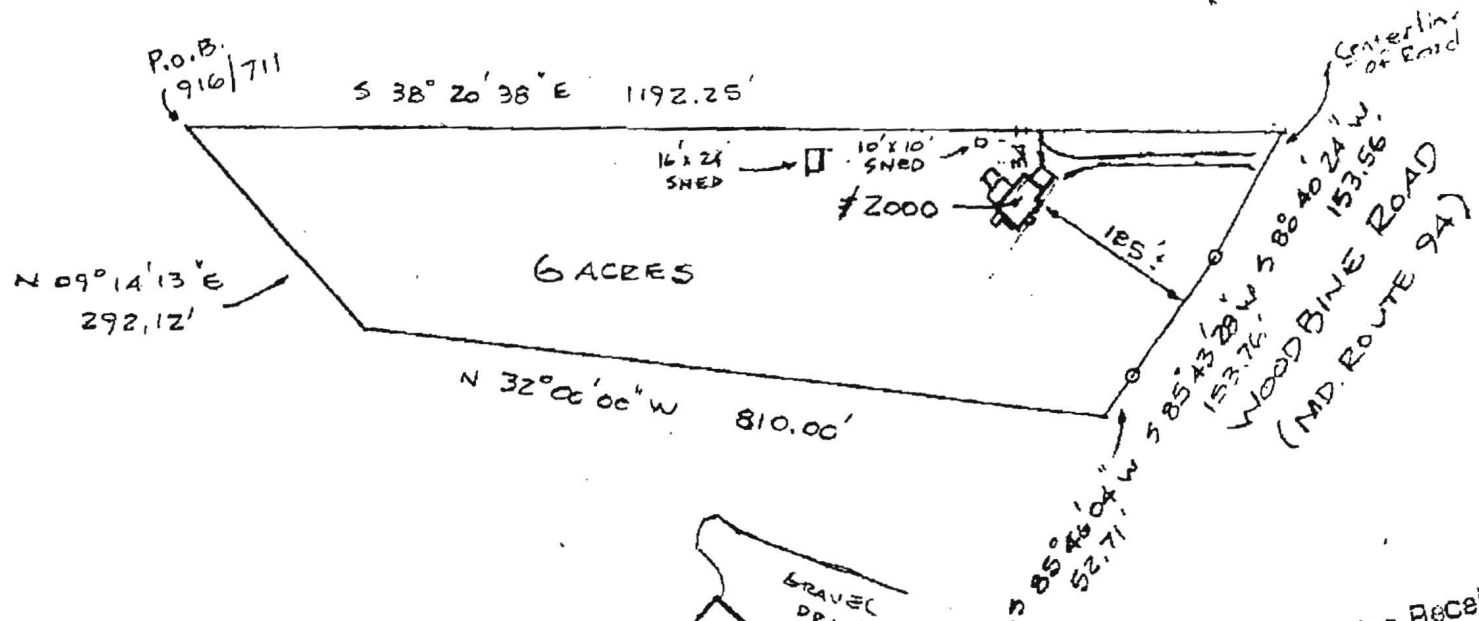

Hereby Acknowledge Receipt
 Of The Herein Document
Victor Zangla

Subject property is shown in Zone C
 on the National Flood Insurance Program
 Flood Insurance Rate Map of HOWARD
 County, Maryland. Panel # 7 OF 45
 Community Panel # PAUGL IS NOT
 Effective Date: PRINTED

This is to certify that I have surveyed the property
 known as 2000 WOODBINE ROAD
LIBER FOLIO
 sheet of recorded 916 711 among the
 Land Records of HOWARD County, Maryland for the
 purpose of locating the improvements thereon.

THIS PLAT SHOWS ONLY THAT THE IMPROVEMENTS ARE
 CONTAINED WITHIN THE OUTLINES OF THE LOT AND IS
 NOT TO BE USED TO ESTABLISH PROPERTY LINES.



J. Carl Hudgins PLS#96

LOCATION SURVEY

2000 WOODBINE ROAD
HOWARD COUNTY, MD

NTT ASSOCIATES, INC.
 16205 Old Frederick Road
 Mt. Airy, Maryland 21771
 Phone 442-2031

| | |
|----------|----------------|
| Scale | 1" = 200' |
| Date | SEPT. 28, 1994 |
| Field By | <i>JCH</i> |
| Drawn By | <i>JCH</i> |
| Drawing | 194-4469K |

~~Evonne DeLoach~~

Scott Hendricks
443 266 2066

Pericert Ap Scott + Hendricks
for
2000 Woodbine

STU perced on 11/5/2007


Homeowner peric sec STU

Is building permit App in File?

Percolation Certification Plan

Hendricks Family Revocable Trust
 Scott & Diana Hendricks
 2000 Woodbine Road
 Woodbine, MD 21797
 Home Phone: 443-266-7066
 Tax Map 7
 Grid 21
 Parcel 359
 A#527232

4875

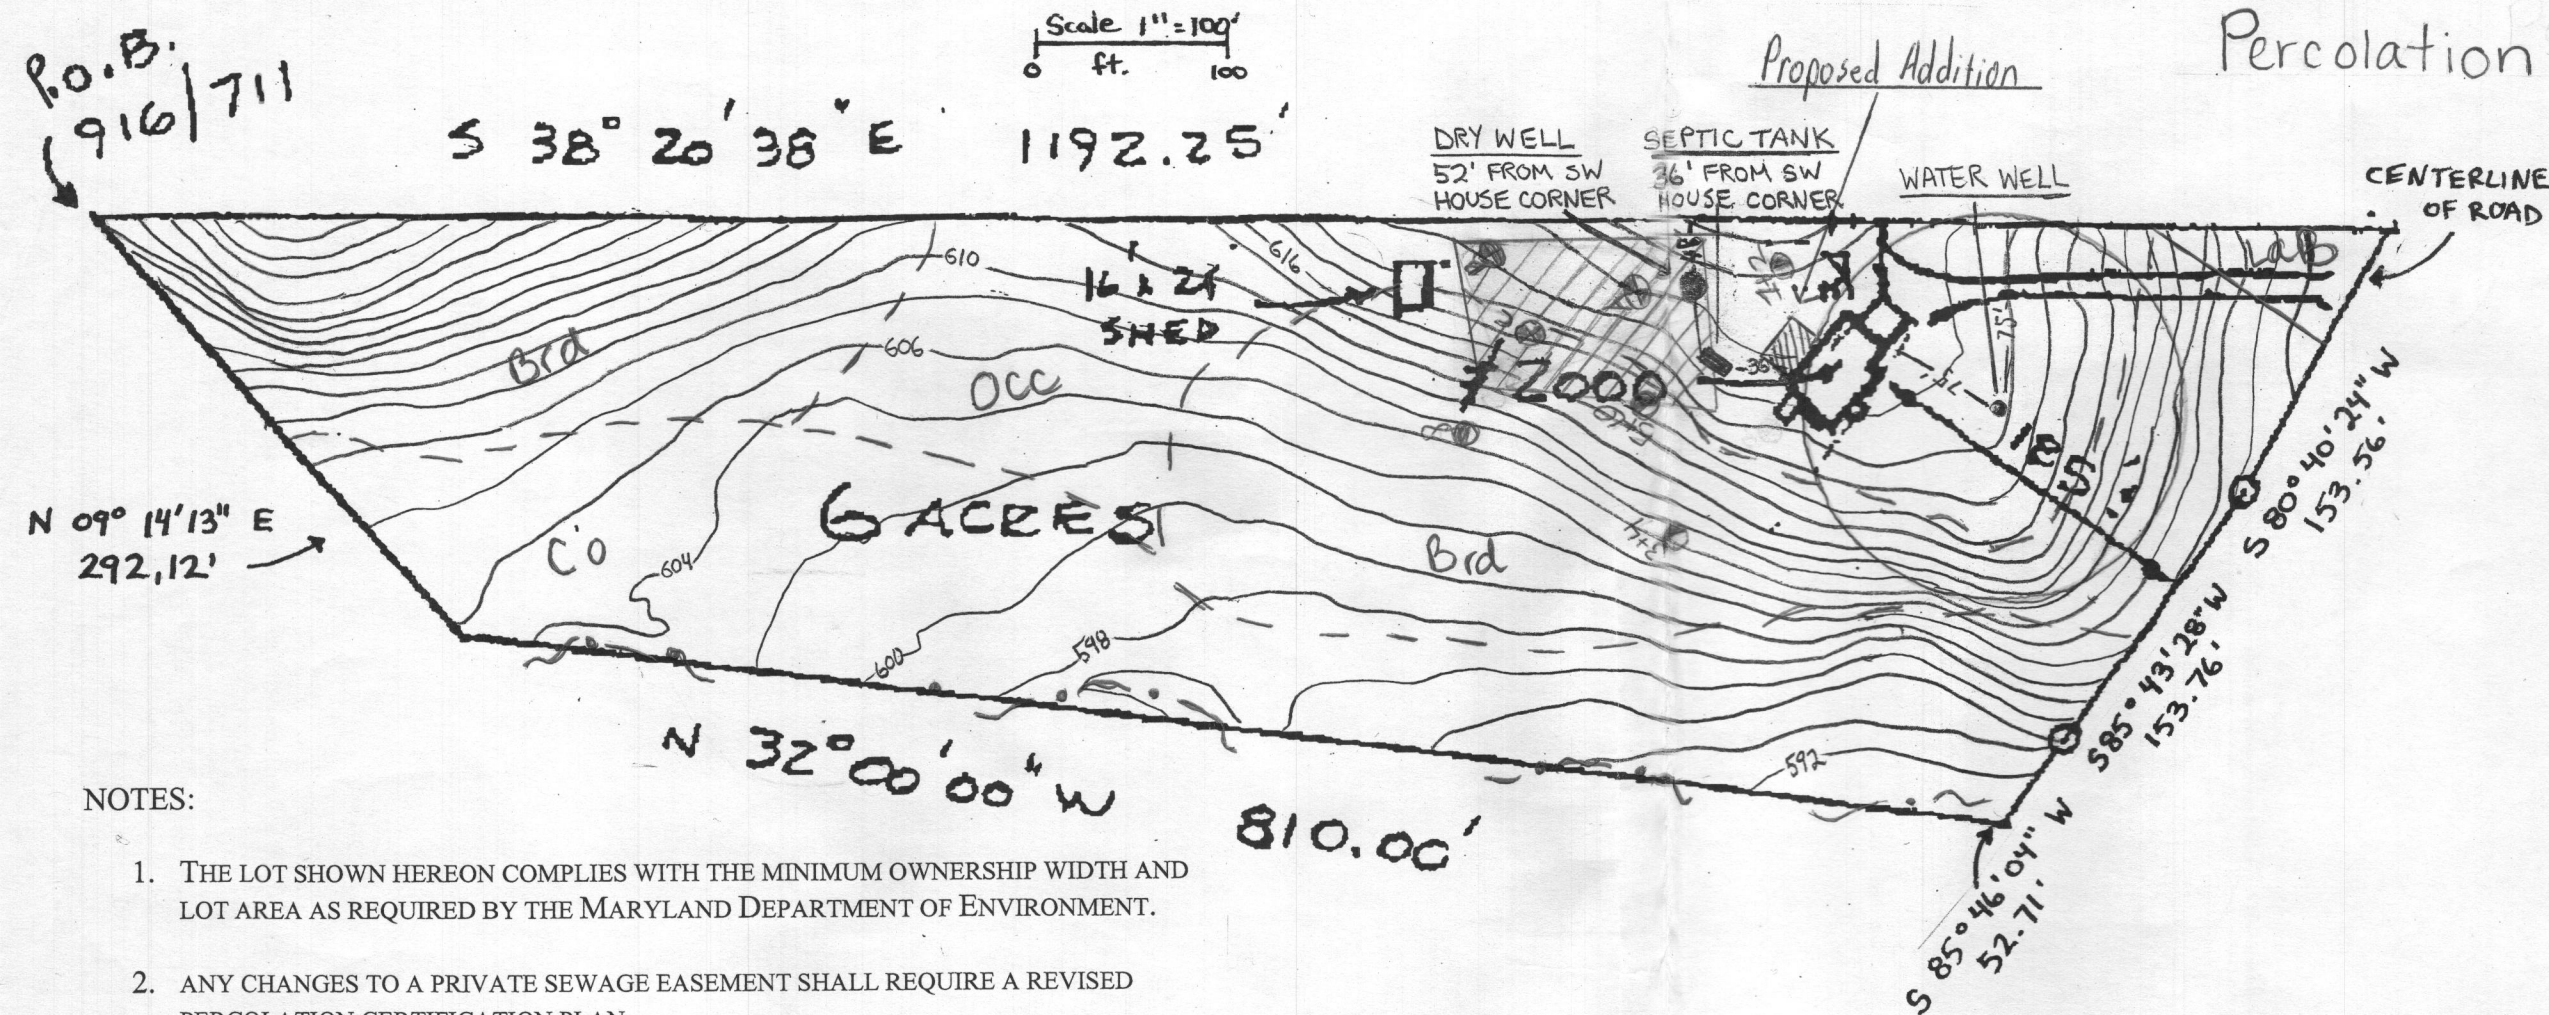

NOTES:

1. THE LOT SHOWN HEREON COMPLIES WITH THE MINIMUM OWNERSHIP WIDTH AND LOT AREA AS REQUIRED BY THE MARYLAND DEPARTMENT OF ENVIRONMENT.
2. ANY CHANGES TO A PRIVATE SEWAGE EASEMENT SHALL REQUIRE A REVISED PERCOLATION CERTIFICATION PLAN.
3. THIS AREA DESIGNATES A PRIVATE SEWAGE EASEMENT AS REQUIRED BY THE MARYLAND DEPARTMENT OF ENVIRONMENT FOR INDIVIDUAL SEWAGE DISPOSAL. IMPROVEMENTS OF ANY NATURE IN THIS EASEMENT ARE RESTRICTED. THIS EASEMENT SHALL BECOME NULL AND VOID UPON CONNECTION TO A PUBLIC SEWERAGE SYSTEM. THE COUNTY HEALTH OFFICER SHALL HAVE AUTHORITY TO GRANT ADJUSTMENTS TO THE PRIVATE SEWAGE EASEMENT. RECORDATION OF A REVISED SEWAGE EASEMENT SHALL NOT BE NECESSARY.
4. THE EXISTING SEPTIC SYSTEM IS TO ACCOMMODATE A 3 BEDROOM RESIDENCE
5. THE TOPOGRAPHY OF THIS PLAT IS FROM HOWARD COUNTY DATA AND IS VERIFIED TO ACCURATELY REPRESENT THE RELATIVE ELEVATION CHANGES ON THE SUBJECT PROPERTY
6. SOIL BOUNDARY LINES TAKEN FROM HOWARD COUNTY DATA BASED ON THE 2003 HOWARD COUNTY SOIL SURVEY WITHIN THE PROPERTY INCLUDE: Co, BrD, & Occ
7. Existing shed 16x24 to be removed
8. All existing wells and septic systems within 100' of property have been shown.



SIGNATURE BLOCKS

Two signature blocks will be on the plan, one as certification by the person (or supervisor) drawing the plan, and one for the health officer. The first statement below conditions the surveyor or engineer signature with date.

I CERTIFY THAT THE INFORMATION SHOWN HERON IS BASED ON WORK PERFORMED IN MY PRESENCE OR BY MY DIRECTION AND IS CORRECT TO THE BEST OF MY KNOWLEDGE AND BELIEF.

Scott Hendricks 11-29-07
 (SIGNATURE) (DATE)

The second is the health officer signature block, conditioned as follows:

APPROVED FOR PRIVATE WATER AND PRIVATE SEWERAGE SYSTEMS.


B. Nefen for Peter Beilensen, MD 12/12/2007
 (SIGNATURE) (DATE)

Legend:

- ~ ~ ~ ~ = stream
- - - - = soil boundary
- A ⊕ = passed perc hole 11/5/07
- 1+2 ⊕ = passed perc hole 3/9/73

Percolation Certification Plan

Hendricks Family Revocable Trust
 Scott & Diana Hendricks
 2000 Woodbine Road
 Woodbine, MD 21797
 Home Phone: 443-266-7066
 Tax Map 7
 Grid 21
 Parcel 359
 A#527232

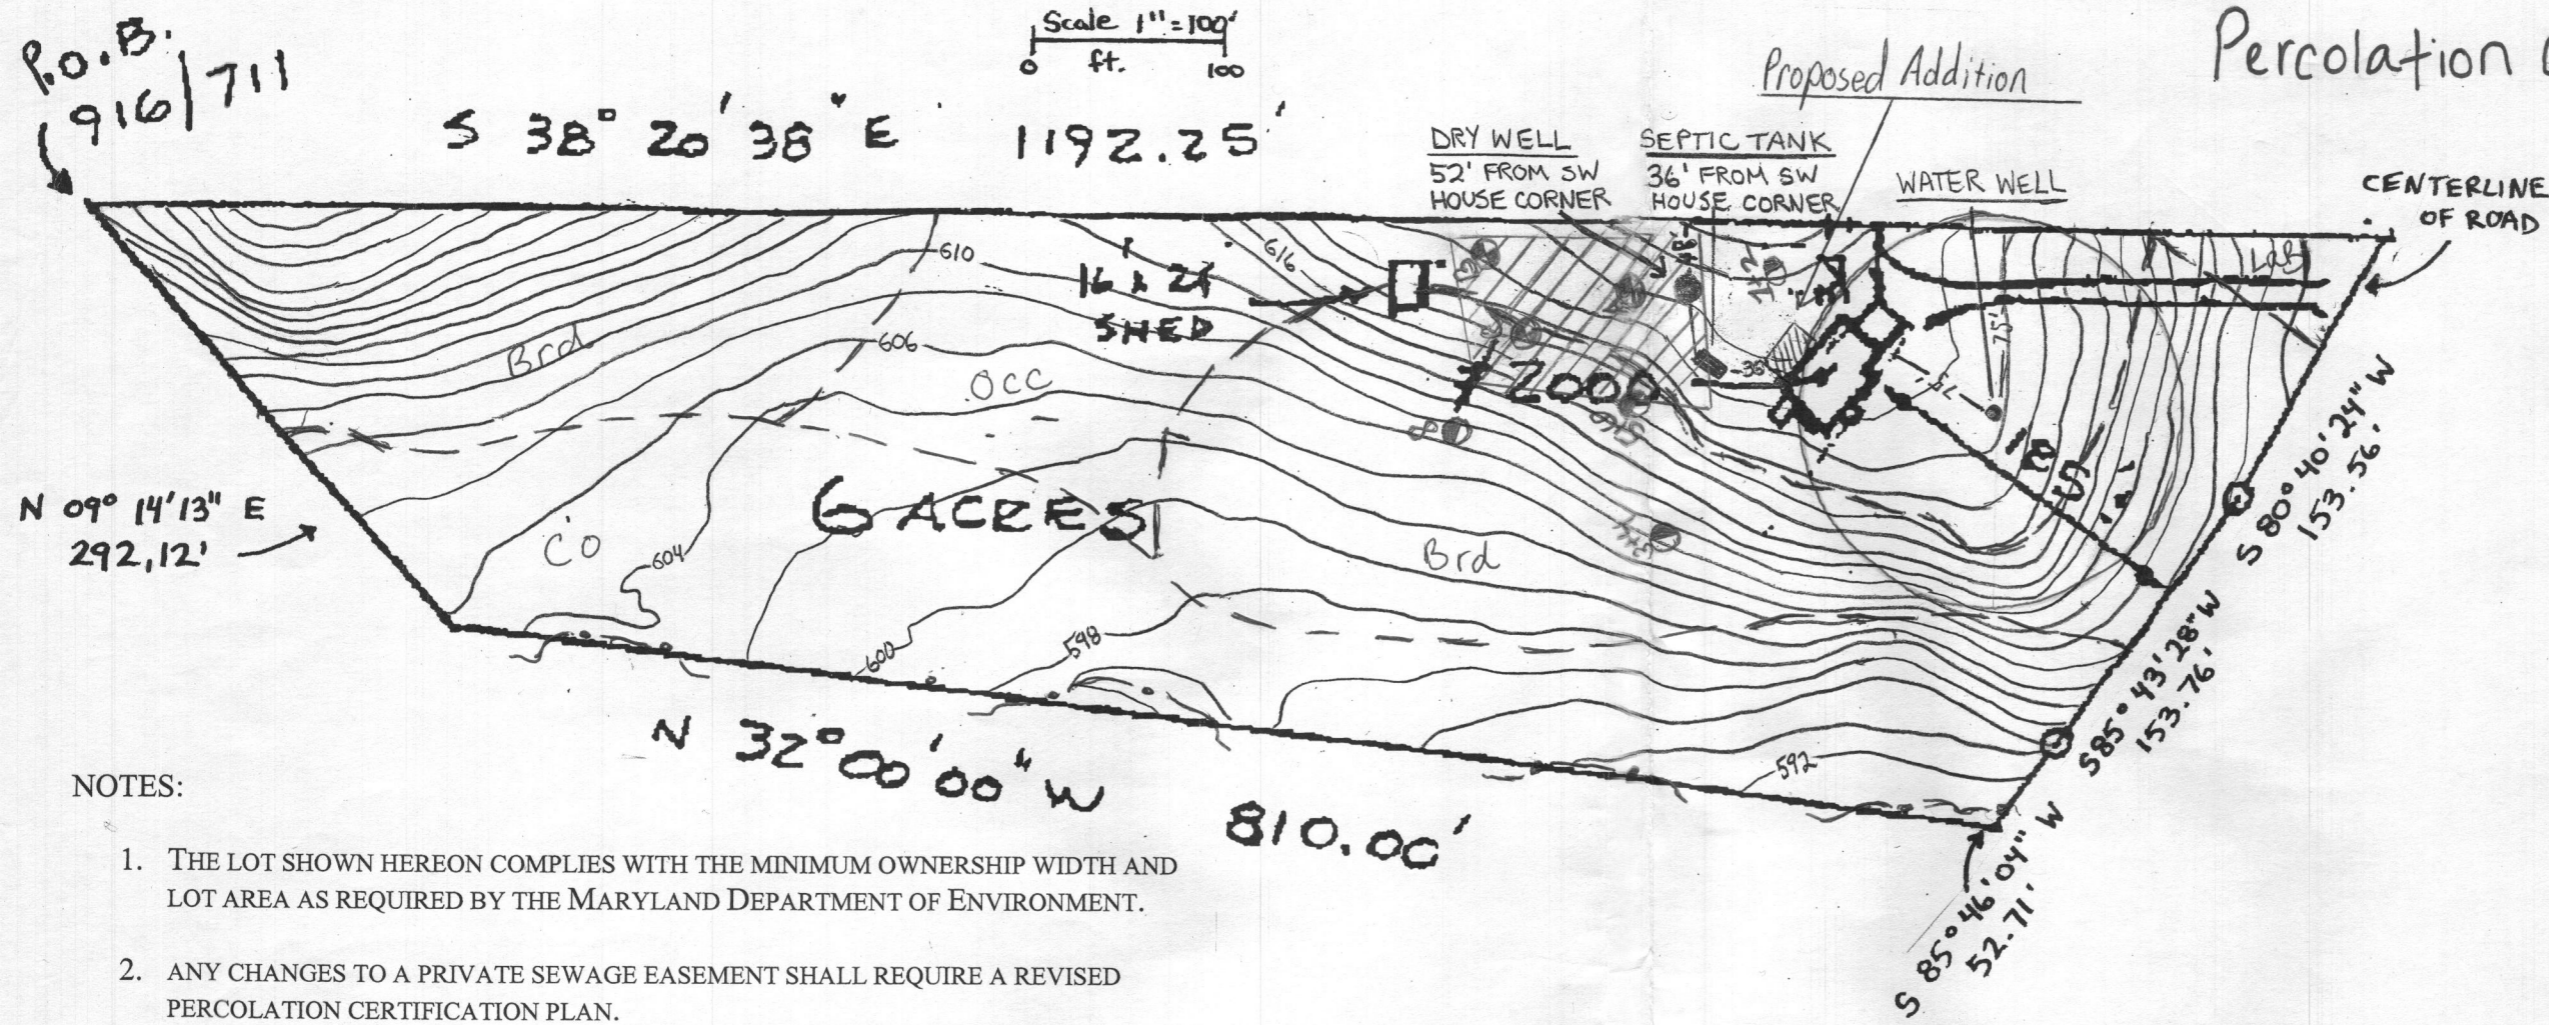

NOTES:

1. THE LOT SHOWN HEREON COMPLIES WITH THE MINIMUM OWNERSHIP WIDTH AND LOT AREA AS REQUIRED BY THE MARYLAND DEPARTMENT OF ENVIRONMENT.
2. ANY CHANGES TO A PRIVATE SEWAGE EASEMENT SHALL REQUIRE A REVISED PERCOLATION CERTIFICATION PLAN.
3. THIS AREA DESIGNATES A PRIVATE SEWAGE EASEMENT AS REQUIRED BY THE MARYLAND DEPARTMENT OF ENVIRONMENT FOR INDIVIDUAL SEWAGE DISPOSAL. IMPROVEMENTS OF ANY NATURE IN THIS EASEMENT ARE RESTRICTED. THIS EASEMENT SHALL BECOME NULL AND VOID UPON CONNECTION TO A PUBLIC SEWERAGE SYSTEM. THE COUNTY HEALTH OFFICER SHALL HAVE AUTHORITY TO GRANT ADJUSTMENTS TO THE PRIVATE SEWAGE EASEMENT. RECORDATION OF A REVISED SEWAGE EASEMENT SHALL NOT BE NECESSARY.
4. THE EXISTING SEPTIC SYSTEM IS TO ACCOMMODATE A 3 BEDROOM RESIDENCE
5. THE TOPOGRAPHY OF THIS PLAT IS FROM HOWARD COUNTY DATA AND IS VERIFIED TO ACCURATELY REPRESENT THE RELATIVE ELEVATION CHANGES ON THE SUBJECT PROPERTY
6. SOIL BOUNDARY LINES TAKEN FROM HOWARD COUNTY DATA BASED ON THE 2003 HOWARD COUNTY SOIL SURVEY WITHIN THE PROPERTY INCLUDE: Co, BrD, & Occ
7. Existing shed 16x24 to be removed.
8. All existing wells and septic systems within 100' of property have been shown.

SIGNATURE BLOCKS

Two signature blocks will be on the plan, one as certification by the person (or supervisor) drawing the plan, and one for the health officer. The first statement below conditions the surveyor or engineer signature with date.

I CERTIFY THAT THE INFORMATION SHOWN HERON IS BASED ON WORK PERFORMED IN MY PRESENCE OR BY MY DIRECTION AND IS CORRECT TO THE BEST OF MY KNOWLEDGE AND BELIEF.

Scott D Hendricks 11-29-07
 (SIGNATURE) (DATE)

The second is the health officer signature block, conditioned as follows:

APPROVED FOR PRIVATE WATER AND PRIVATE SEWERAGE SYSTEMS.

B. Nyanja Peter Beilensen, MD 12/12/2007
 (SIGNATURE) (DATE)

Legend:

- ~ ~ ~ = stream
- - - = soil boundary
- ⊕ = passed perc hole 11/5/07
- ⊙ = passed perc hole 3/9/73