

Permit
11/13/86
1830

APPLICATION

PERCOLATION TESTING

A 37920

P _____

HOWARD COUNTY HEALTH DEPARTMENT
BUREAU OF ENVIRONMENTAL HEALTH
P.O. BOX 476 ELLICOTT CITY, MARYLAND 21043
TELEPHONE: 461-9933

DISTRICT _____

DATE 10/22/86

TO: THE COUNTY HEALTH OFFICER
ELLICOTT CITY, MARYLAND

I HEREBY APPLY FOR THE NECESSARY TEST IN ORDER TO CONSTRUCT (OR RECONSTRUCT) A SEWAGE DISPOSAL SYSTEM.

PROPERTY OWNER ROBERT ORNDORFF

ADDRESS % RLO CONTRACTORS, P.O. BOX 57, DARTON, MD. 21036 PHONE 596-9490

PROSPECTIVE BUYER _____

ADDRESS _____ PHONE _____

PROPERTY LOCATION:

SUBDIVISION SABINE PROPERTY LOT NO. 10

ROAD AND DESCRIPTION NORTH SIDE TRIADELPHIA MILL RD.

TAX MAP 28 PARCEL # 300

SIZE OF LOT 3.1 AC. TYPE BLDG. SINGLE-FAMILY DWLG.
(SINGLE FAMILY DWELLING OR COMMERCIAL)

THE SYSTEM INSTALLED UNDER THIS APPLICATION IS ACCEPTABLE ONLY UNTIL PUBLIC FACILITIES BECOME AVAILABLE. I FULLY UNDERSTAND THE FEE CONNECTED WITH THE FILING OF THIS PERC TEST APPLICATION IS NON-REFUNDABLE UNDER ANY CIRCUMSTANCES. I ALSO AGREE TO COMPLY WITH ALL M.O.S.H.A. REQUIREMENTS IN TESTING THIS LOT.

[Signature]
(SIGNATURE OF APPLICANT)

APPROVED BY _____ FOR _____ DATE _____

REJECTED BY _____ FOR _____ DATE _____

HOLD PENDING FURTHER TESTS _____ DATE _____


REASONS FOR REJECTION OR HOLDING _____

BLDG. PERMIT SIGNED
AND RETURNED 5/19/95
Serial # 59633
[Signature]

THIS IS NOT A PERMIT

ALL HOLES

SOIL PROFILE

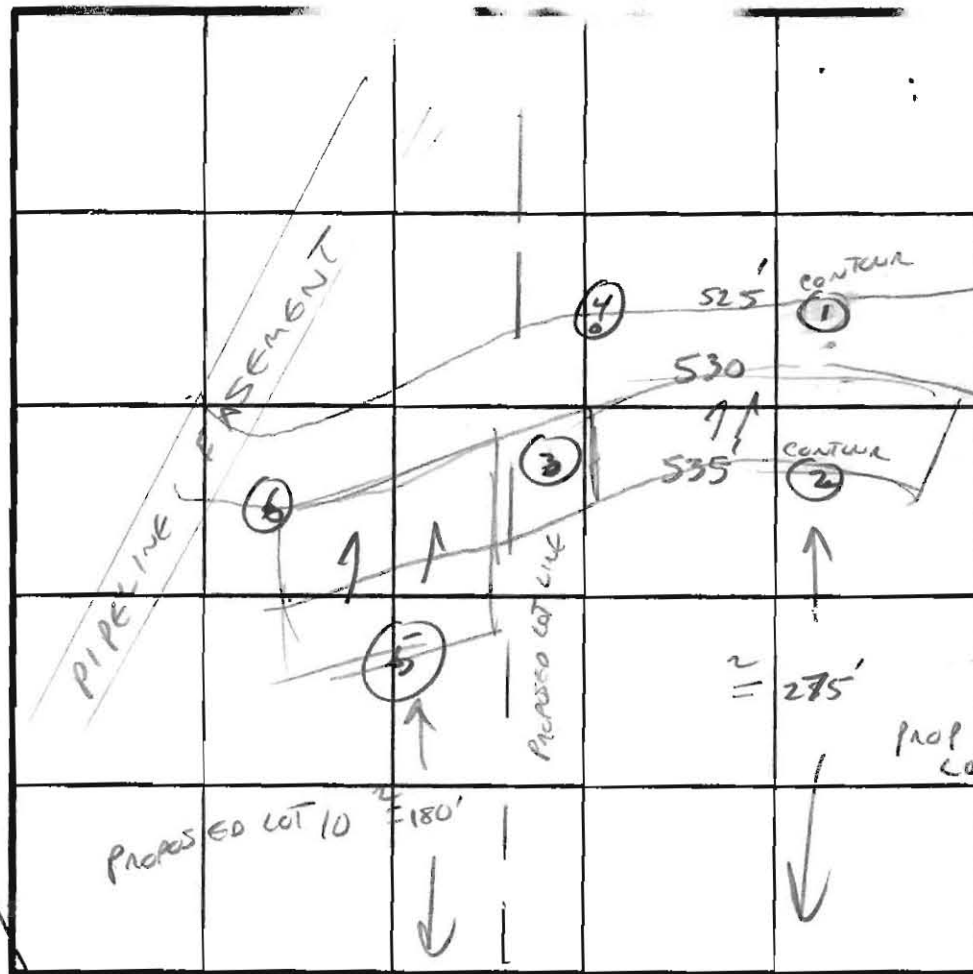

DATE	TEST NO.	DEPTH	PRE-WET		TEST - 1" DROP		TIME
			START	STOP	START	STOP	
11/3/86	1	4	3:26	3:28	3:28	3:30	2 MIN
		8	VIS	OK			
		13	VIS	OK			
	2	4	3:20	3:22	3:22	3:24	2 MIN
		8	VIS	OK			
		13					
	3	4	3:32	3:34	3:34	3:36	2 MIN
		8	VIS	OK			
		13					
	4	4	VISUALLY SIMILAR TO OTHERS				
		8	NO OBVIOUS SIGN OF WATER, BUT LOCATION IN SUSPECT AREA				
		13					
	5	4	3:38	3:40	3:40	3:42	2 MIN
		8	VIS	OK			
		13					
	6	4	VISUAL SIMILAR TO OTHER HOLES				
		8					
		13					

REMARKS

TYPE OF SOIL

MICA LOAM

TESTED BY


C. Williams

ALSO PRESENT

ORNDORFF

HOWARD COUNTY HEALTH DEPARTMENT

JOYCE M. BOYD, M.D., M.P.H.
COUNTY HEALTH OFFICER

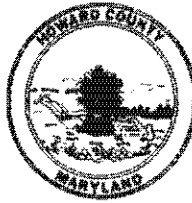

Bureau of Environmental Health
3525 Ellicott Mills Drive
Ellicott City, Maryland 21043

Director - 461-9958
Water & Sewerage, Permits - 461-9933
Community Environmental Health - 461-9944
Technical Services - 461-9955

December 10, 1986

Mr. Robert Orndorff
c/o RLO Contractors
P. O. Box 57
Dayton, Maryland 21036

RE: Percolation Testing
Proposed Lots 9 & 10
Sabine Property
Triadelphia Mill Road

Dear Mr. Orndorff:

Percolation testing conducted November 12, 1986 on the above referenced property indicated satisfactory soil conditions.

Approval is contingent upon submission by a registered engineer of a plat showing certified test hole locations and a suitable house and well site. Proposed septic areas should be no lower on the property than the 530 foot contour.

This should be submitted within sixty (60) days to allow field verification if necessary.

If you have any questions regarding this matter, please feel free to contact me at the above address or by calling 461-9933.

Very truly yours,

A handwritten signature in cursive script that reads "Craig Williams".

Craig Williams, Director
Water and Sewerage Program

CW:JR

APPLICATION

PERCOLATION TESTING

A 37919
P _____

HOWARD COUNTY HEALTH DEPARTMENT
BUREAU OF ENVIRONMENTAL HEALTH
P.O. BOX 476 ELLICOTT CITY, MARYLAND 21043
TELEPHONE: 461-9933

DISTRICT _____
DATE 10/22/86

*Reviewed - OK TO Process
10/21/86 SAGLE*

TO: THE COUNTY HEALTH OFFICER
ELLICOTT CITY, MARYLAND

I HEREBY, APPLY FOR THE NECESSARY TEST IN ORDER TO CONSTRUCT (OR RECONSTRUCT) A SEWAGE DISPOSAL SYSTEM.

PROPERTY OWNER ROBERT ORNDORFF
ADDRESS % RLO CONTRACTORS, P.O. BOX 57, DAYTON, MD. 21036 PHONE 506-9490

PROSPECTIVE BUYER _____
ADDRESS _____ PHONE _____

PROPERTY LOCATION:

SUBDIVISION CABINE PROPERTY LOT NO. 9

ROAD AND DESCRIPTION NORTH SIDE TRIADDELPHIA MILL RD.

TAX MAP 20 PARCEL # 300

SIZE OF LOT 3.0 AC TYPE BLDG. SINGLE FAMILY DWLG.
(SINGLE FAMILY DWELLING OR COMMERCIAL)

THE SYSTEM INSTALLED UNDER THIS APPLICATION IS ACCEPTABLE ONLY UNTIL PUBLIC FACILITIES BECOME AVAILABLE. I FULLY UNDERSTAND THE
FEE CONNECTED WITH THE FILING OF THIS PERC TEST APPLICATION IS NON-REFUNDABLE UNDER ANY CIRCUMSTANCES. I ALSO AGREE TO COMPLY
WITH ALL M.O.S.H.A. REQUIREMENTS IN TESTING THIS LOT.

Robert C. Orndorff Jr.
(SIGNATURE OF APPLICANT)

APPROVED BY _____ FOR _____ DATE _____

REJECTED BY _____ FOR _____ DATE _____

HOLD PENDING FURTHER TESTS _____ DATE _____


REASONS FOR REJECTION OR HOLDING _____

THIS IS NOT A PERMIT

ALL HOLES

SOIL PROFILE

0	CLAY LOAM
3	SAND LOAM MIXED W SOME CLAY LOAM
5	MICA SAND LOAM
13	<10% MICA SCHIST-SAPPHIRE

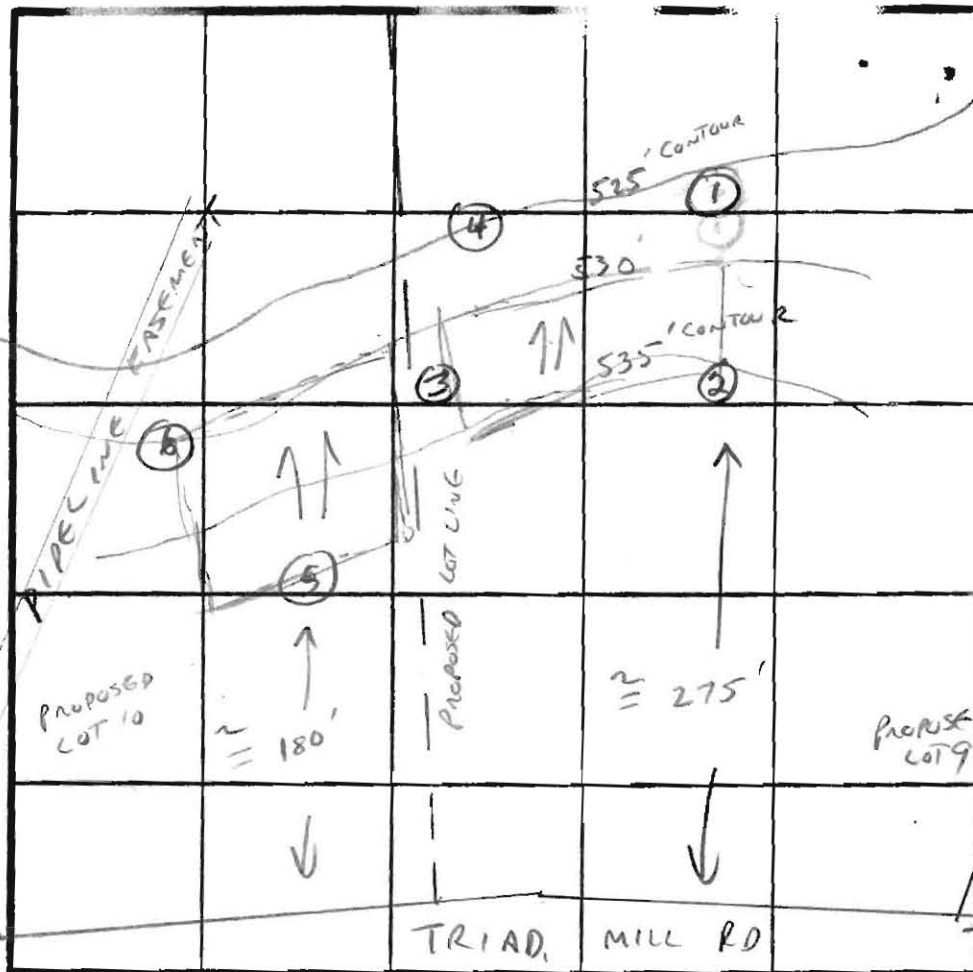

INDICATE NORTH - NAME ADJOINING ROADWAY AS BASE LINE

DATE	TEST NO.	DEPTH	PRE-WET		TEST - 1" DROP		TIME
			START	STOP	START	STOP	
11/13/86	1	4	3:26	3:28	3:28	3:30	2 MIN
		8		VIS	OK		
		13					
	2	4	3:20	3:22	3:22	3:24	2 MIN
		8		VIS	OK		
		13					
	3	4	3:32	3:34	3:34	3:36	2 MIN
		8		VIS	OK		
		13					
	4	4		VISUALLY	SIMILAR	TO OTHERS	
		8					
		13		NO OBVIOUS SIGN OF WATER BUT IN SUSPECT LOCATION		RECOMMEND SEPTIC AREA BY 5' HIGHER ELEVATION	
	5	4	3:38	3:40	3:40	3:42	2 MIN
		8		VIS	OK		
		13					
	6	4		VISUALLY	SIMILAR	TO OTHER HOLES	
		8					
		13					

REMARKS

TYPE OF SOIL

TESTED BY


MICA LOAM > NO EVIDENCE OF WATER IN VERY DRY YEAR
RECOMMEND SEPTIC AREA NO LOWER THAN 530' CONTOUR

William

ALSO PRESENT

ORNDORF

SABINI
LOT 3

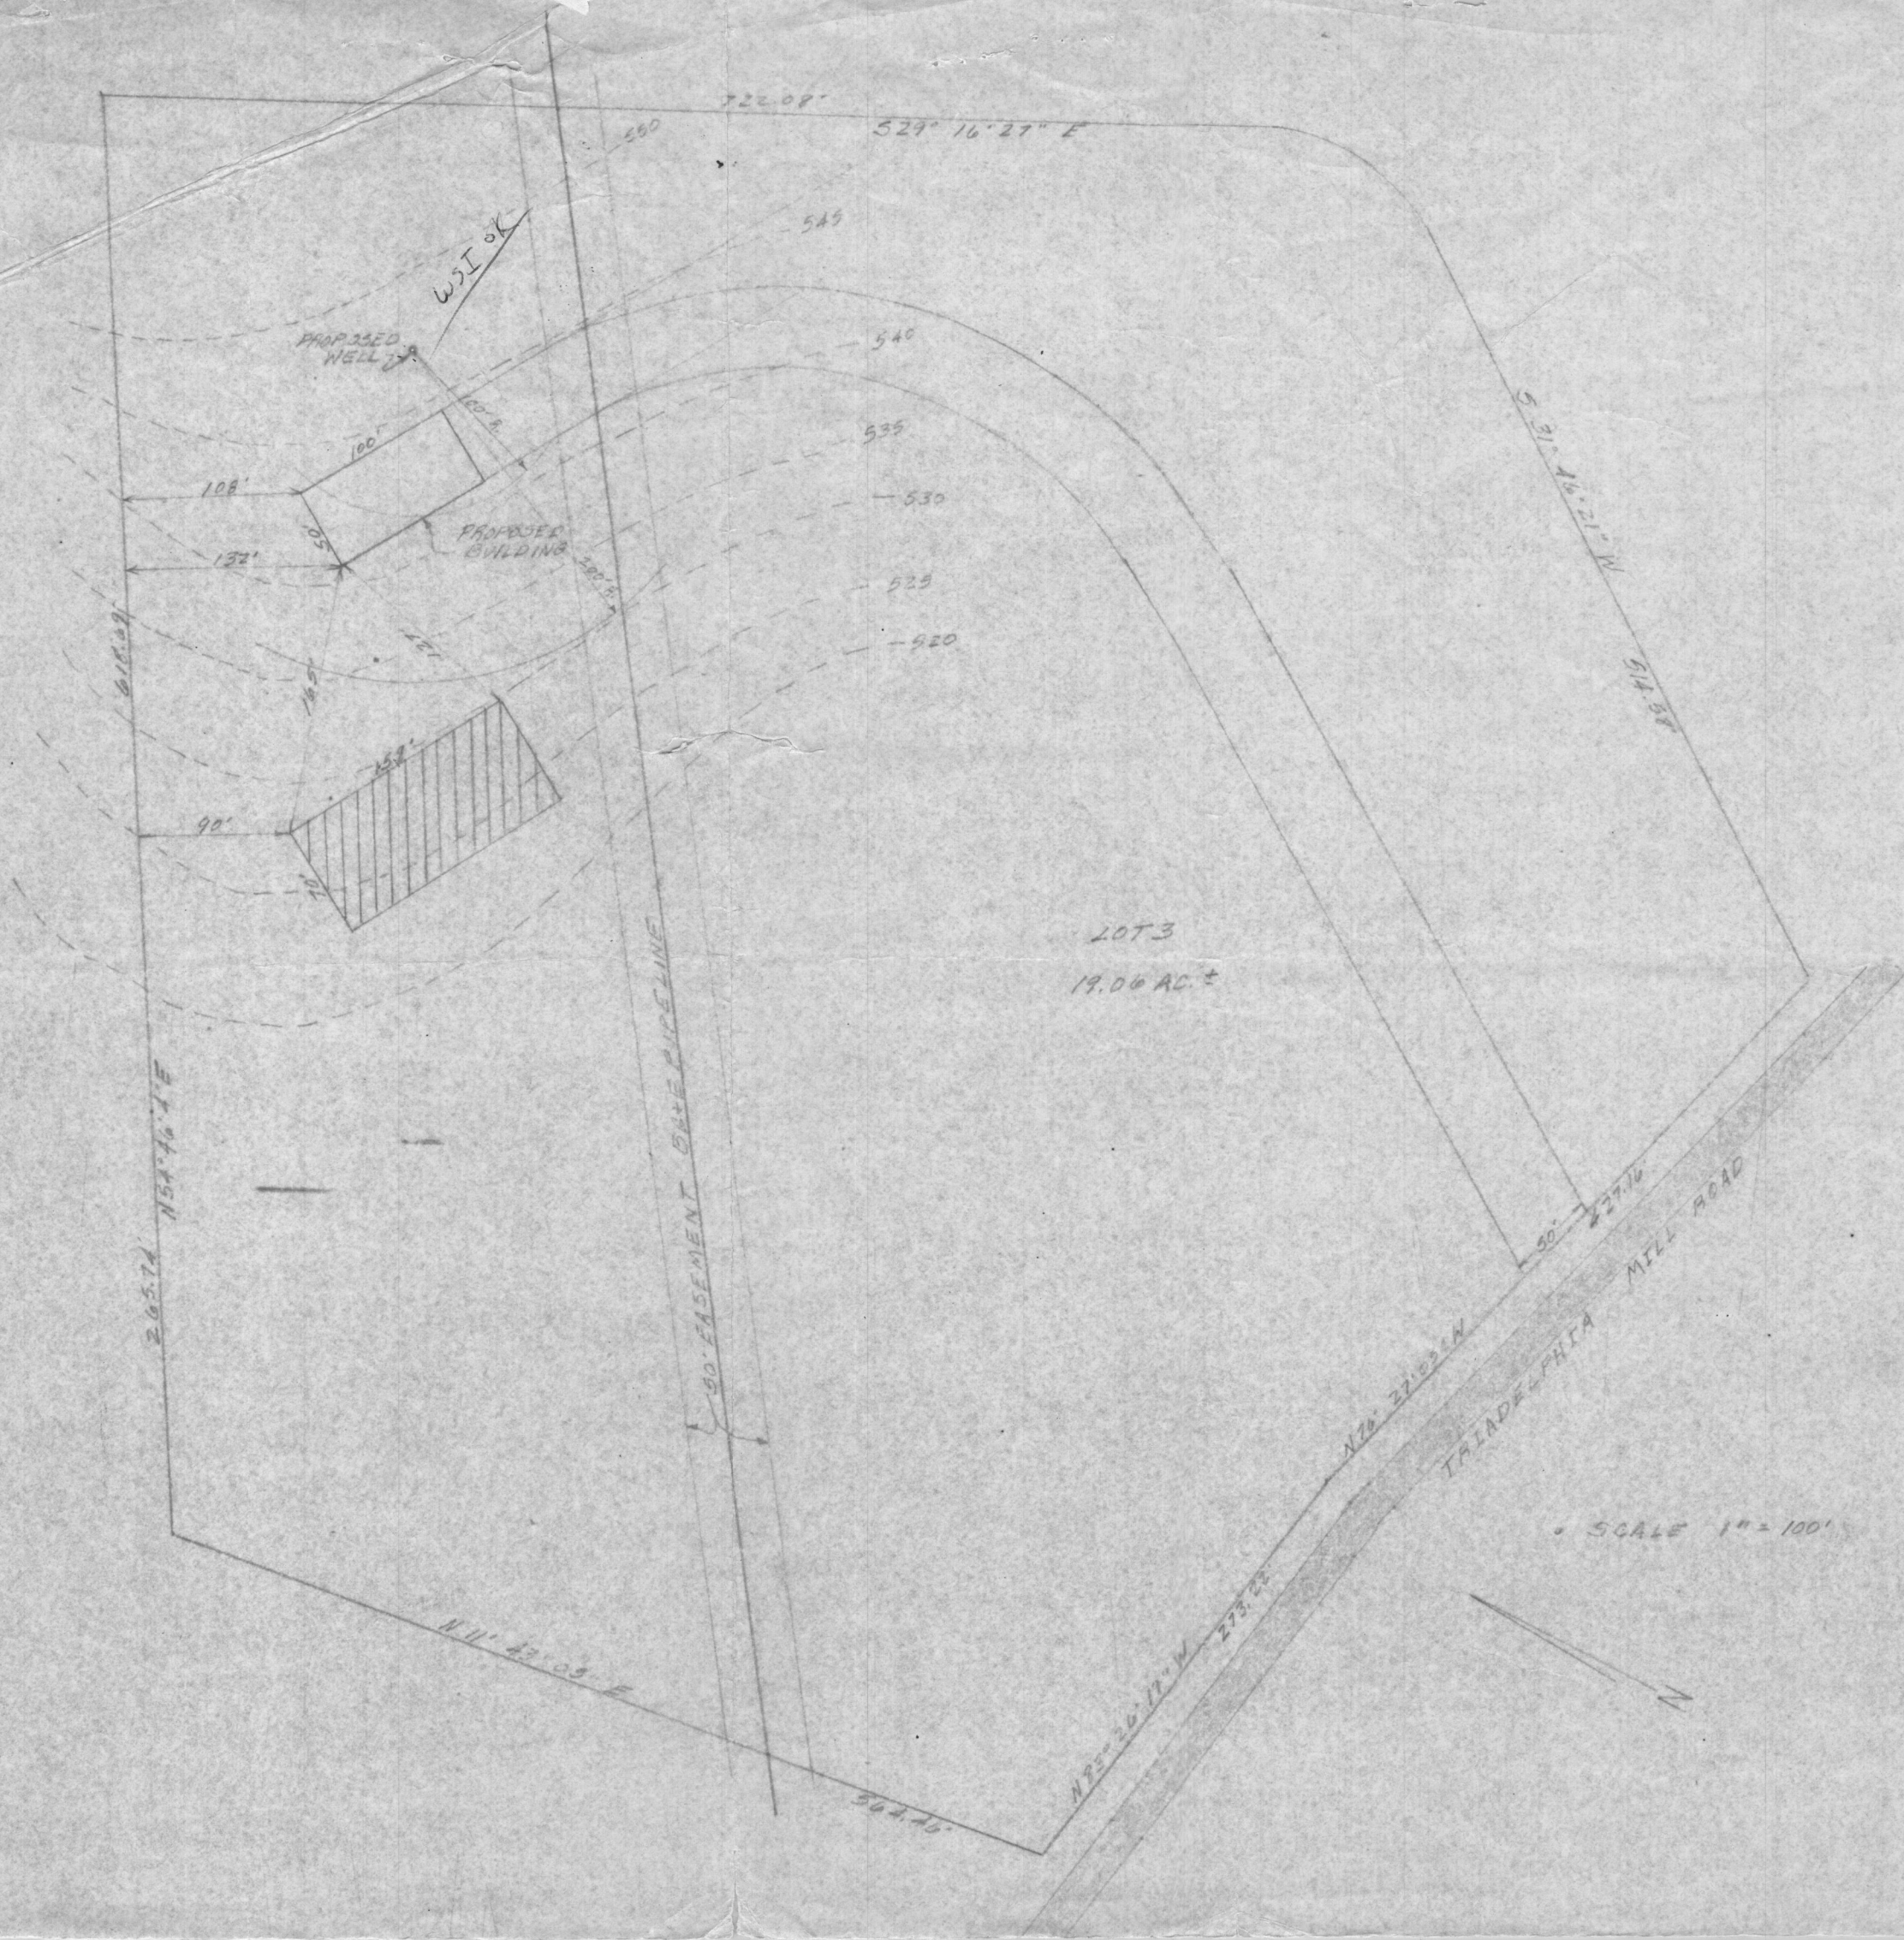

Walter Sabine Property
LOT 3
5th Election District