

APPLICATION

HOWARD COUNTY

PERMIT APPLICATION

DEPARTMENT OF INSPECTIONS, LICENSES & PERMIT
3430 COURT HOUSE DRIVE, ELICOTT CITY, MARYLAND 21043

SERIAL NUMBER

59633

BUILDING ADDRESS (HOUSE NO., STREET, TOWN OR AREA)

13730 Triadelphia Mill Rd.
Clarksville, Md 21029

GRADING/SEDIMENT CONTROL ☐ YES ☐ NO

SDP #

DESCRIPTION OF WORK AUTHORIZED

Build 18x23' Bathroom addition
on Bsmi.

LOT NO. PARCEL NO. SEC. AREA BLOCK NO. LIBER FOLIO

SUB DIVISION ZONE ZONE MAP ELEC. DIST. CENSUS TR.

OWNER NAME AND ADDRESS

PHONE NO.

Robert & Joyce Orndorff 301-854-
Same 3417

OCCUPANT'S NAME AND ADDRESS

PHONE NO.

Same

ARCHITECT OR ENGINEER'S NAME AND ADDRESS

PHONE NO.

Stan Ryder Jr. Associates 521-
8308 Liberty Road, Balt. Md. 2367
CONTRACTOR'S NAME AND ADDRESS 21244

Owner

SIZE OF BLDG. FRONT DEPTH HEIGHT

18 23 18'

TYPE OF BLDG. AREA VOLUME ROOF

B. ROOMS
ROOMS
BATHS
FIREPLACES

FOOTINGS FOUNDATION S. WALLS

20x8' Concrete 12" Block

UTILITIES

WATER/WELL SEWER/SEPTIC GAS ELECTRICITY TYPE OF HEAT AC

I have carefully examined and read this application and know the same is true and correct, and that in doing this work, all provisions of Howard County Ordinances and the State Laws of Maryland will be complied with, whether specified or not; and I will notify the Department of Inspections, and Permits twenty-four hours in advance when I am ready for the inspections called for elsewhere in the application; and that no work will be covered up until such inspections have been completed.

Stanley B. Miller
Rep. Owner
5/15/95
DATE

EXISTING USE

PROPOSED USE

N/A S.F.D. Bathroom

EST. CONSTRUCTION COST

LICENSE NUMBER

PERMIT FEE

20,000.00

W/S CODE

FOR OFFICE USE ONLY

DISTRICT IN FEET FROM R/W LINE TO FRONT BUILDING LINE

SIDE YARD

(DISTANCE IN FEET FROM SIDE BLDG. LINE TO SIDE PROPERTY LINE)

TO SIDE BUILDING LINE

DISTANCE IN FEET, REAR YD. REQUIRING SET

BACK (CORNER LOT ONLY)

SDP #

Check payable to: DIRECTOR OF FINANCE OF HOWARD COUNTY

CAUTION

To begin construction before a permit placard has been issued and displayed on the job is a violation of the law.
Use and occupancy permit must be applied for two weeks before it will be issued.

IMPORTANT: PLEASE SHOW ZIP CODES AND AREA CODES WHEREVER REQUIRED.

LP-69-591

FUNCTION	DATE	SIGNATURE APPROVAL
ZONING/PLANNING		
SHA		
SEDIMENT/GRADING		
BUILDING OFFICIAL		
WATER & SEWER		
HEALTH DEPT.	5/14/95	Robert Orndorff
FIRE PROTECTION		
STORM WATER MGM.		

APPROVED

DATE

Distribution of Copies:
White - Building Official
Green - Planning & Zoning

Yellow - Engineering
Pink - Health Dept.
Gold - S.H.A.

Permits: 410-313-2455
Inspections: 410-313-1810
Automated Line: 410-313-3800

Howard County Building/Fire Permit Application
Department of Inspections, Licenses & Permits
3430 Court House Drive
Ellicott City, MD 21043

Permit Number:

Building Address: _____

Suite/Apt. # _____ SDP/WP/BA #: _____

Census Tract: _____ Subdivision: _____

Section: _____ Area: _____ Lot: 12

Tax Map: _____ Parcel: _____ Grid: 19

Zoning: _____ Map Coordinates: _____ Lot Size: 13,594

Existing Use: _____

Proposed Use: _____

Estimated Construction Cost: \$ _____

Description of Work: _____

Occupant or Tenant: _____

Was tenant space previously occupied? ☐ Yes ☐ No

Contact Name: _____

Address: _____

City: _____ State: _____ Zip Code: _____

Phone: _____ Fax: _____

Email: _____

Property Owner's Name: _____

Address: _____

City: _____ State: _____ Zip Code: _____

Home Phone: 443-301-1200 Work Phone: _____

Applicant's Name & Mailing Address, (If other than stated herein): _____

Phone: 410-313-3800 Fax: _____

Email: g4c@hcc.gov

Contractor Company: _____

Contact Person: _____

Address: _____

City: _____ State: _____ Zip Code: _____

License No.: _____

Phone: _____ Fax: _____

Email: _____

Engineer/Architect Company: _____

Responsible Design Prof.: _____

Address: _____

City: _____ State: _____ Zip Code: _____

Phone: _____ Fax: _____

Email: _____

BUILDING DESCRIPTION - COMMERCIAL

Building Characteristics	Utilities
Height:	<u>Water Supply</u>
No. of stories:	☐ Public
Gross area, sq. ft./floor:	☐ Private
	<u>Sewage Disposal</u>
Area of construction (sq. ft.):	☐ Public
	☐ Private
Use group:	Electric: ☐ Yes ☐ No
	Gas: ☐ Yes ☐ No
<u>Construction type:</u>	<u>Heating System</u>
☐ Reinforced Concrete	☐ Electric ☐ Oil
☐ Structural Steel	☐ Natural Gas ☐ Propane Gas
☐ Masonry	<u>Sprinkler System:</u>
☐ Wood Frame	☐ N/A
☐ State Certified Modular	☐ Full
☒ Roadside Tree Project Permit	☐ Partial
☐ Yes ☒ No	☐ Other Suppression
<u>Roadside Tree Project Permit #</u>	No. of Heads:

BUILDING DESCRIPTION - RESIDENTIAL

Building Characteristics	Utilities
☒ SF Dwelling ☐ SF Townhouse	<u>Water Supply</u>
<u>Depth</u> <u>Width</u>	☐ Public
1 st floor:	☐ Private
2 nd floor:	<u>Sewage Disposal</u>
Basement:	☐ Public
☐ Finished Basement	☐ Private
☐ Unfinished Basement	Electric: ☐ Yes ☐ No
☐ Crawl Space	Gas: ☐ Yes ☐ No
☐ Slab on Grade	<u>Heating System</u>
No. of Bedrooms:	☐ Electric
<u>Multi-family Dwelling</u>	☐ Oil
No. of efficiency units:	☐ Natural Gas
No. of 1 BR units:	☐ Propane Gas
No. of 2 BR units:	
No. of 3 BR units:	
Other Structure:	
Dimensions:	
Footings:	☒ Roadside Tree Project Permit
Roof:	☐ Yes ☒ No
☐ State Certified Modular	<u>Roadside Tree Project Permit #</u>
☐ Manufactured Home	

THE UNDERSIGNED HEREBY CERTIFIES AND AGREES AS FOLLOWS: (1) THAT HE/SHE IS AUTHORIZED TO MAKE THIS APPLICATION; (2) THAT THE INFORMATION IS CORRECT; (3) THAT HE/SHE WILL COMPLY WITH ALL REGULATIONS OF HOWARD COUNTY WHICH ARE APPLICABLE THERETO; (4) THAT HE/SHE WILL PERFORM NO WORK ON THE ABOVE REFERENCED PROPERTY NOT SPECIFICALLY DESCRIBED IN THIS APPLICATION; (5) THAT HE/SHE GRANTS COUNTY OFFICIALS THE RIGHT TO ENTER ONTO THIS PROPERTY FOR THE PURPOSE OF INSPECTING THE WORK PERMITTED AND POSTING NOTICES.

Applicant's Signature _____

Email Address _____

Title/Company _____

Print Name _____

Date _____

Checks Payable to: DIRECTOR OF FINANCE OF HOWARD COUNTY

****PLEASE WRITE NEATLY & LEGIBLY****
-FOR OFFICE USE ONLY-

AGENCY	DATE	SIGNATURE OF APPROVAL
State Highways		
Building Officials		
PSZA (Zoning)		
PSZA (Engineering)		
Health	<u>7/29/11</u>	<u>[Signature]</u>
Fire Protection		

Is Sediment Control approval required for issuance? ☐ Yes ☐ No
☐ CONTINGENCY CONSTRUCTION START
☐ ONE STOP SHOP

DPZ SETBACK INFORMATION

Front: _____

Rear: _____

Side: _____

Side St.: _____

All minimum setbacks met? ☐ Yes ☐ No

Is Entrance Permit Required? ☐ Yes ☐ No

Historic District? ☐ Yes ☐ No

Lot Coverage for New Town Zone: _____

SDP/Red-line approval date: _____

Filing Fee	\$
Permit Fee	\$
Tech Fee	\$
Excise Tax	\$
PSFS	\$
Guaranty Fund	\$
Add'l per Fee	\$
Total Fees	\$
Sub- Total Paid	\$
Balance Due	\$


9-10-11

tribution of Copies: White: Building Officials Green: PSZA,Zoning Yellow: PSZA,Engineering Pink: Health Gold: SHA

NO.	N
109	50
108	50
107	50
106	50
105	50
104	50
103	50
102	50
101	50
100	50

* MD 50
CROWN
HAWK
BIRCH
TRAVEL
VILLAGE
KGO 5

THE
TURN
BURN
ADD
BURN
STRE
LEA
REG
7.85E

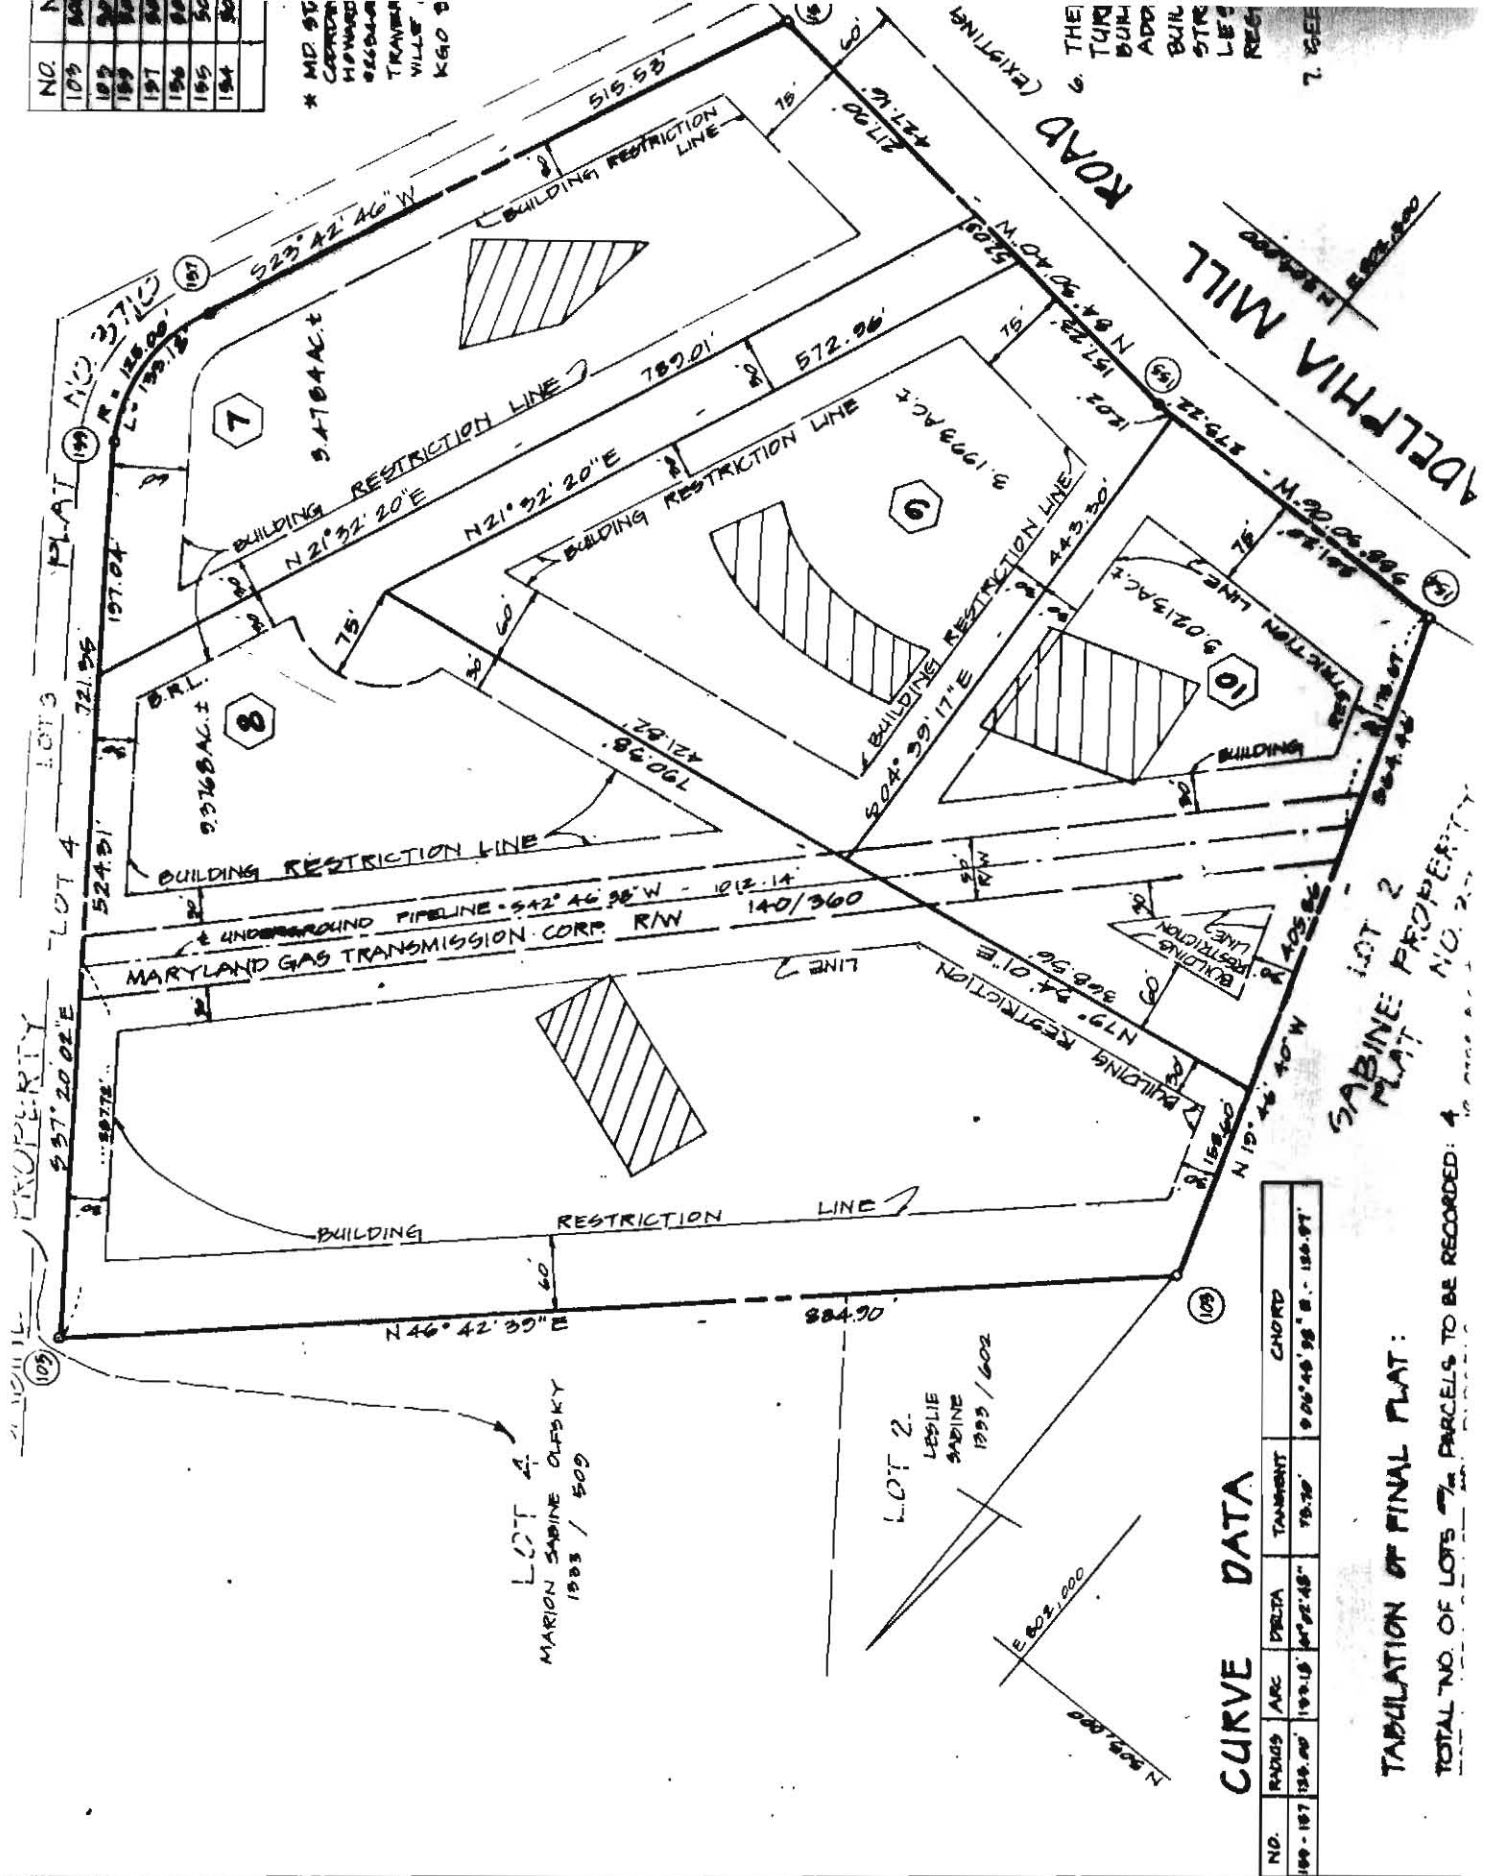


CURVE DATA

NO.	RADIUS	ARC	DELTA	TANGENT	CHORD
100-107	150.00'	193.18'	60°22'48"	75.70'	90.64' 98" 8" 150.00'

TABULATION OF FINAL PLAT:

TOTAL NO. OF LOTS 7. PARCELS TO BE RECORDED: 4

F-87-93
SABINE PROPERTY 7-10
(CONDOFF)
TRIA, MILL RD
SGUT FOR SIGNATURE
4/29/87 CW

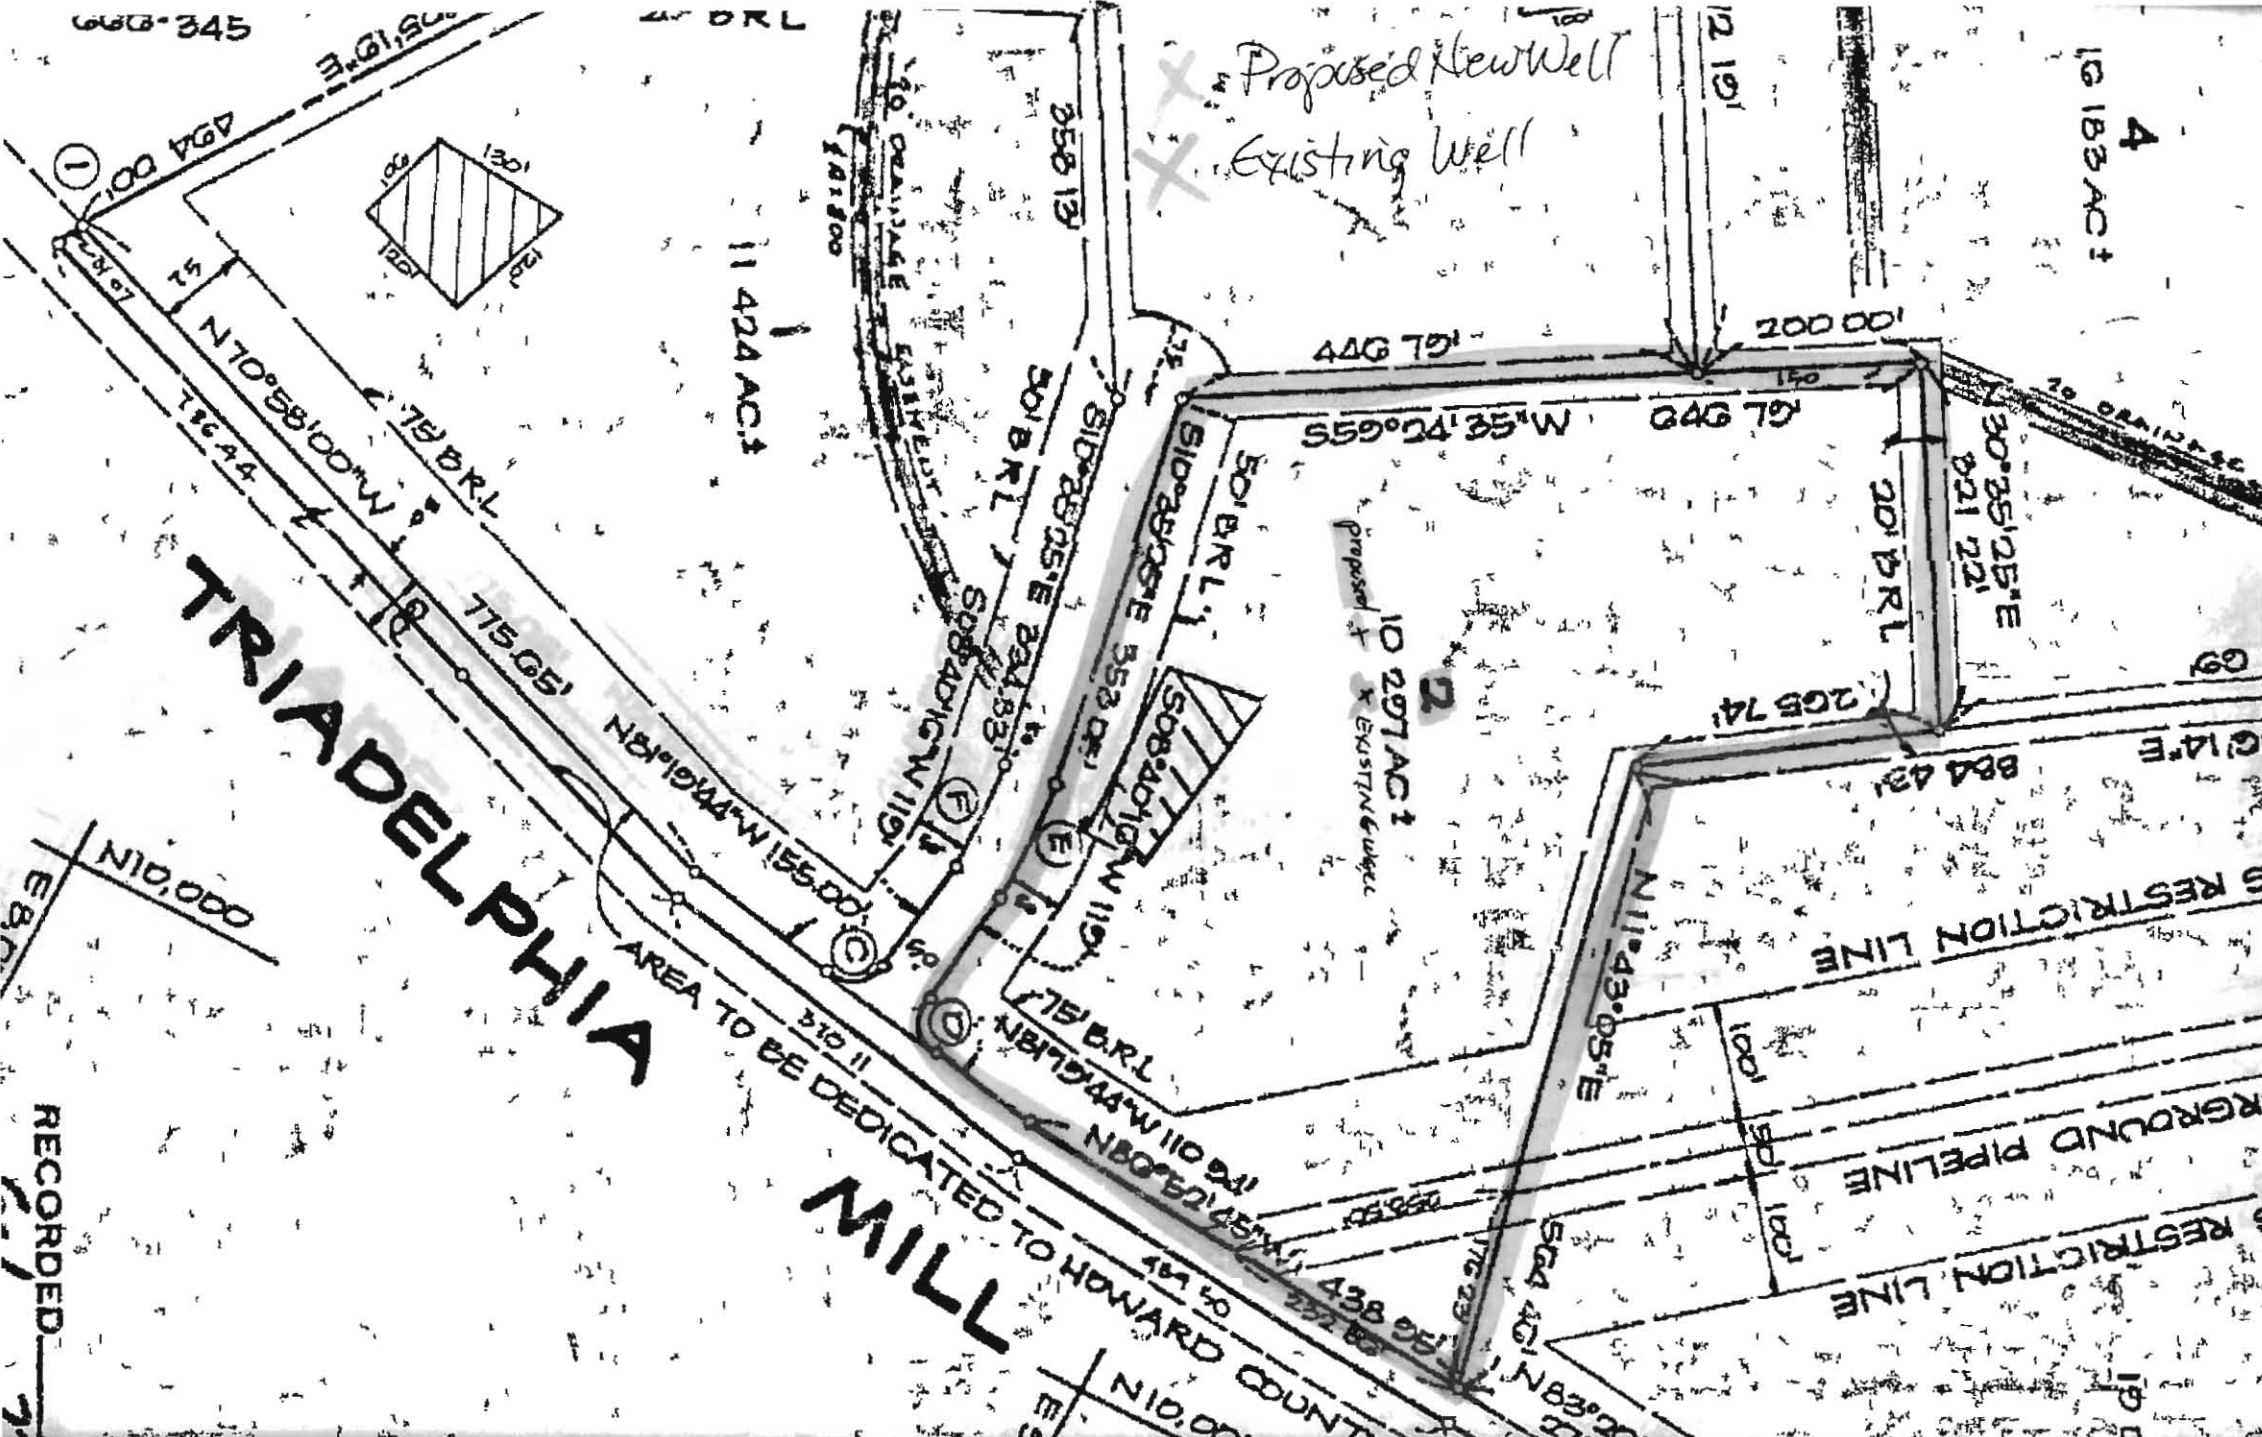

OWNER: ROBERT L. ORNDORFF
 13780 TRIADELPHIA MILL RD. HOWARD COUNTY
 CLARKSVILLE, MD 21029
 410-531-2288 ext. 620 OR 410-977-8990 cell

Existing hand-dug well is failing.
 Need to make application for drilling new well.

5/18/95

SEPTIC CLEAN-UP LOCATED
NEAR FRONT OF HOUSE. NO DISCREPANCY
SEEN IN SEPTIC FIELD AREA.
PLENTY OF SEPTIC REPAIR AREA.
NO OBSTRUCTIONS AT END OF DRAINAGE.
OK TO APPROVE. RL

30' SET BACK
FROM EASEMENT

518.95
4' X 4' CONCRETE
W/ CAP
+ WATER HYDRAULIC
PROBABLE LEAK
HOUSE
POOL

EXIST. WELL
ONE STORY POOL
ADDITION

EXISTING
ONE STORY
ADDITION
W/ BENT
42.65' F.
23'-8"
4'-0"
4'-0"

EXIST. SEPTIC

ADDITION PLAN
scale 1" = 20'-0"

50' EASEMENT FOR
BORE PIPELINE
EXISTING GRAVE

EXISTING DRIVE WAY

Recommended
5/17/95
No other
work with this
check

50' EASEMENT BORE PIPELINE

N 11° 43' 05" E

265.74'

N 54° 46' 04" E

EXIST'G

525

530

545

550

564.76

N 85° 26' 19" W 285.26'

N 62° 27' 05" W
TRAYBEL PHIL
MILL
227.16'

514.58'
531° 46' 21" W

2500' ±
To HOLLAND PK

North

SITE PLAN

scale 1" = 100'

5th ELECTION DISTRICT
ADDITION TO THE
ORNDORFF RESIDENCE

MAY 12 1995
STAN RYDER JR. + ASSOC.
ARCHITECTS 521 2367

95 MAY 16 AM 9:02

HOWARD COUNTY
HEALTH DEPT.

5/1/95

will