

Building Permit Application
Howard County Maryland
Department of Inspections, Licenses and Permits
3430 Court House Drive
Permits: 410-313-2455
www.howardcountymd.gov

27/21	DOW	ECLIN	15781 7	1702.3	- 28
Date	Receiv	ed.	MUM T	EP-6	(多名) 图图图
-		ou.			

Permit No.: <u>B</u>18003

Zip Code: 2:02: Zip Code: 2:02: Zip Code: 2:12: Zip Code: 2:12: Zip Code: 2:12:
At the control of the
her than stated herein) Zip Code: 21179 Lapp round . 222 Zip Code: 20707
Zip Code: 21178
Zip Code: 21178
Zip Code: 21178
Inportation Comments Zip Code: 20707
Zip Code: 20707
Zip Code: Zo?o?
Zip Code: <u>20707</u>
Zip Code: Zo7o7
Zip Code: <u>このでの</u> つ
braichte ar is idelateure in laste in
braichte ar is idelateure in laste in
braichte ar is idelateure in laste in
A STREET OF STREET OF STREET
Zip Code:
STREET, STREET

AGENCY	DATE	SIGNATURE OF APPROVAL
State Highways	Miles P	
Building Officials		
PSZA (Zoning)		
PSZA (Engineering)		
Health	11/00	R Hotel

DPZ SETBACK INFORMATION		
Front:		East No.
Rear:	5.00	200
Side:	W 15:26	
Side St.:	777	
All minimum setbacks met?	☐ Yes	□No
Is Entrance Permit Required?	☐ Yes	□No
Historic District?	☐ Yes	□No
Lot Coverage for New Town Z	one:	4
SDP/Red-line approval date:	SMELLS	Children

Filing Fee	\$ 1111
Permit Fee	\$
Tech Fee	\$
Excise Tax	\$
PSFS	\$ 2.44
Guaranty Fund	\$
Add'I per Fee	\$
Total Fees	\$
Sub- Total Paid	\$
Balance Due	\$
Check	# 10 02 1 1


istribution of Copies: White: Building Officials

Green: PSZA,Zoning

Yellow: PSZA,Engineering

Pink: Health

Gold: SHA

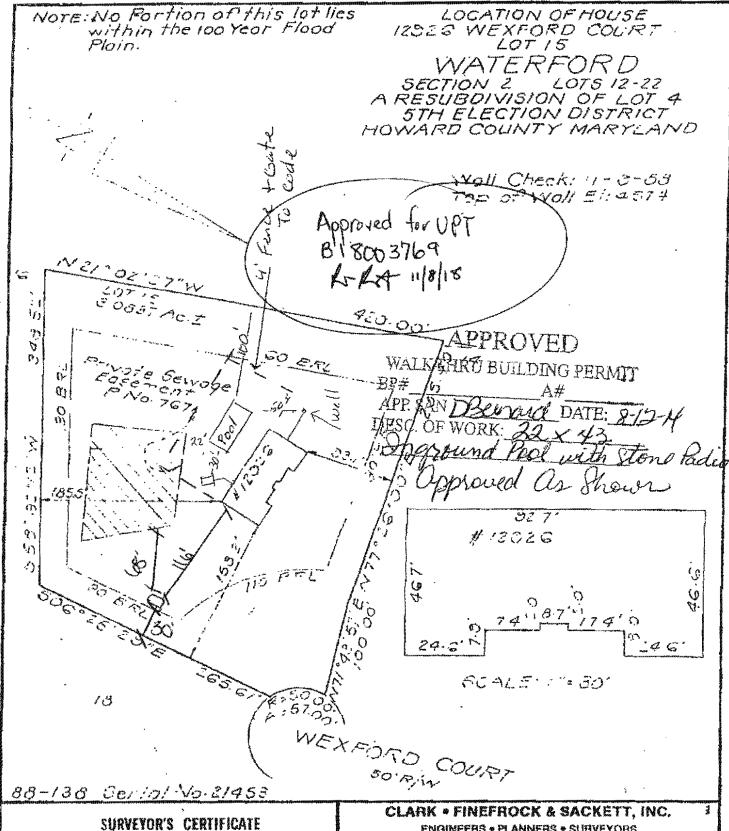

I hereby certify that the position of all existing improvements on the above described property have been carefully established by a transit-tape survey and that unless otherwise shown, there are no encroachments.

boundelle relieble 6057

ENGINEERS • PLANNERS • SURVEYORS 7136 MINSTREL WAY COLUMBIA, MD. 21045 (301) 381-7600-BALTO, • (301) 821-8100-WASH.

REFERENCE	DRAWN BYSWA	CHECKED BY KING
Plat	DATE //-/5-88	FILE NO.
767/	SCALE / "= 100"	3435-K