

LAYOUT 5/21/07 (kw) INSP 4 \_\_\_\_\_  
INSP 2 5/23/07 (kw) INSP 5 \_\_\_\_\_  
INSP 3 5/24/07 (kw) INSP 6 \_\_\_\_\_

ISSUE DATE: 05/16/2007

P 526707

APPROVAL DATE: 5/24/07 (kw)

A 50225-C

# PERMIT

TAX ID #

## ON-SITE SEWAGE DISPOSAL SYSTEM HOWARD COUNTY HEALTH DEPARTMENT BUREAU OF ENVIRONMENTAL HEALTH

Michael Budman

IS PERMITTED TO INSTALL ☒ ALTER ☐

ADDRESS: 18222 Flower Hill Way, #132 PHONE NUMBER: 301-351-8746  
Gaithersburg, MD 20879

SUBDIVISION: \_\_\_\_\_ LOT NUMBER: 10

ADDRESS: 3601 Willow Birch Dr PROPERTY OWNER: \_\_\_\_\_

SEPTIC TANK CAPACITY (GALLONS): 2000 OUTLET BAFFLE FILTER REQUIRED ☐

PUMP CHAMBER CAPACITY (GALLONS): \_\_\_\_\_ COMPARTMENTED TANK REQUIRED ☒

NUMBER OF BEDROOMS: 6

SQUARE FEET PER BEDROOM: \_\_\_\_\_

LINEAR FEET OF TRENCH REQUIRED: 266

TRENCHES:	Trench to be feet wide. Inlet feet below original grade. Bottom maximum depth feet below original grade. Effective area begins at feet below original grade. feet of stone below distribution pipe.
LOCATION:	
NOTES:	Need to add a 500 gallon piggy back tank to an existing 1500 gallon tank. Layout inspection required prior to installation.

PLANS APPROVED: SF DATE: 5/16/07

NOTE: PERMIT VOID AFTER 2 YEARS

NOTE: CONTRACTOR RESPONSIBLE FOR SCHEDULING A PRE-CONSTRUCTION INSPECTION FOR ALL INSTALLATIONS

NOTE: WATERTIGHT SEPTIC TANKS REQUIRED

NOTE: ALL PARTS OF SEPTIC SYSTEM SHALL BE 100 FEET FROM ANY WATER WELL

NOTE: MANHOLE RISERS REQUIRED ON ALL SEPTIC TANKS AND PUMP CHAMBERS UNLESS SPECIFICALLY AUTHORIZED


**NEITHER THE HOWARD COUNTY COUNCIL NOR THE HEALTH DEPARTMENT IS  
RESPONSIBLE FOR THE SUCCESSFUL OPERATION OF ANY SYSTEM  
PERMITTEE RESPONSIBLE FOR OBTAINING FINAL APPROVAL ON THIS PERMIT  
CALL 410-313-1771 FOR INSPECTION OF SEPTIC SYSTEM**

**BUILDING PERMIT SIGNED  
AND RETURNED**

5/24/07- B07001991- Frank BsmT

HO-95-1247

NOT TO SCALE

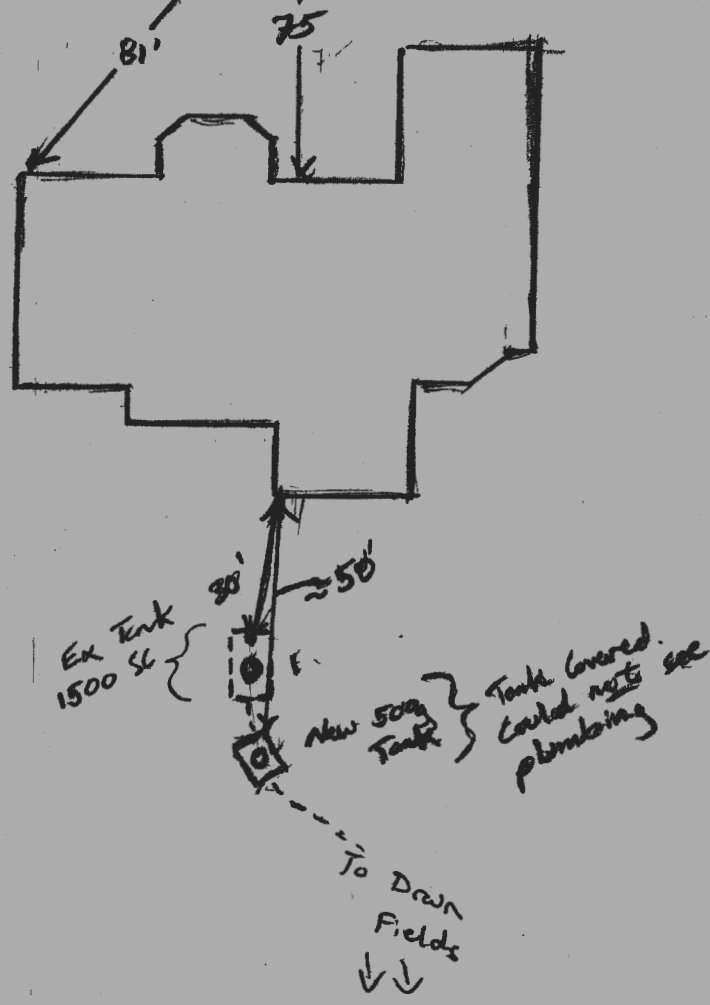

TRENCH/DRAINFIELD DATA		
WIDTH	INLET	BOTTOM
NUMBER OF TRENCHES		
TOTAL LENGTH		
ABSORPTION AREA		
DISTRIBUTION BOX LEVEL		
DISTRIBUTION BOX BAFFLE		
DISTRIBUTION BOX PORT		

SEPTIC TANK DATA	
SEPTIC TANK 1 LEVEL	
CAPACITY	GAL
SEAM LOC	
TANK LID DEPTH	
BAFFLES	
BAFFLE FILTER	
MANHOLE LOC	
6" PORT LOC	
WATERTIGHT TEST	
SEPTIC TANK 2 LEVEL	
CAPACITY	GAL
SEAM LOC	
TANK LID DEPTH	
BAFFLES	
BAFFLE FILTER	
MANHOLE LOC	
6" PORT LOC	
WATERTIGHT TEST	

PRE-CONSTRUCTION 5/21/07 O.K. to install 500 gallon tank downhill of existing tank. Tank cannot be deeper than 3'. (KB)

INSTALLATION 5/23/07 Tanks installed and covered before I arrived. Contractor took pics of installation. Used vertical pipe extending down off of baffle tee's, roughly 12"-16" on inlet and outlet of new 500g S.T. Told contractor pictures showing complete of this is acceptable. (KW) 5/24/07 Pics of baffles w/ vertical pipe refitted. Sys. complete. (KW)

FINAL INSPECTOR [Signature] DATE OF APPROVAL 5/24/07





OK  
1





OK  
/



## FILE INQUIRY NOTES

[illegible]