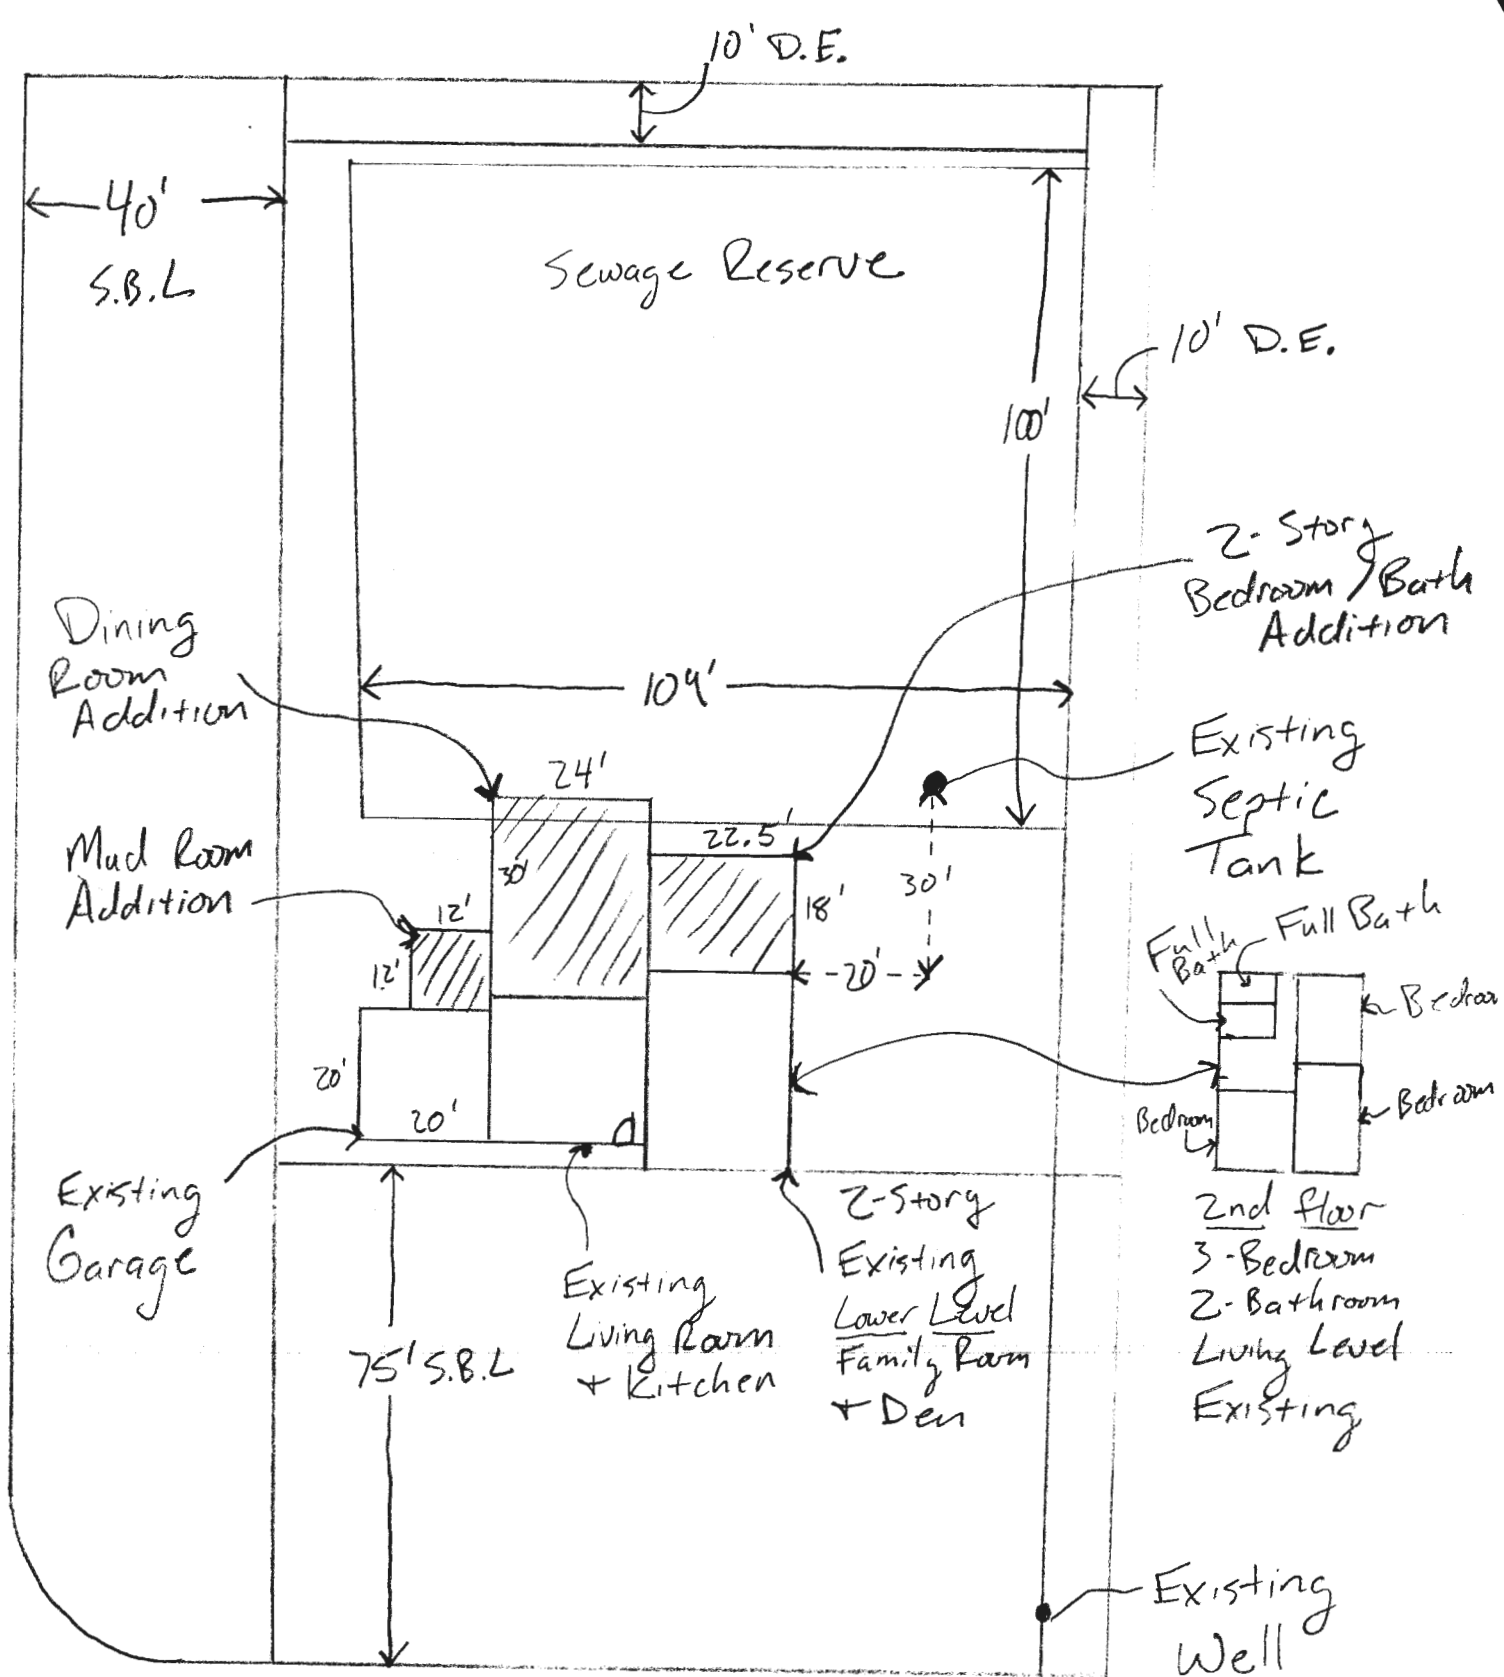


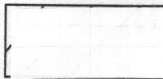


Lot 11 Kingston
 13094 Williamfield dr
 scale 1" = 29'

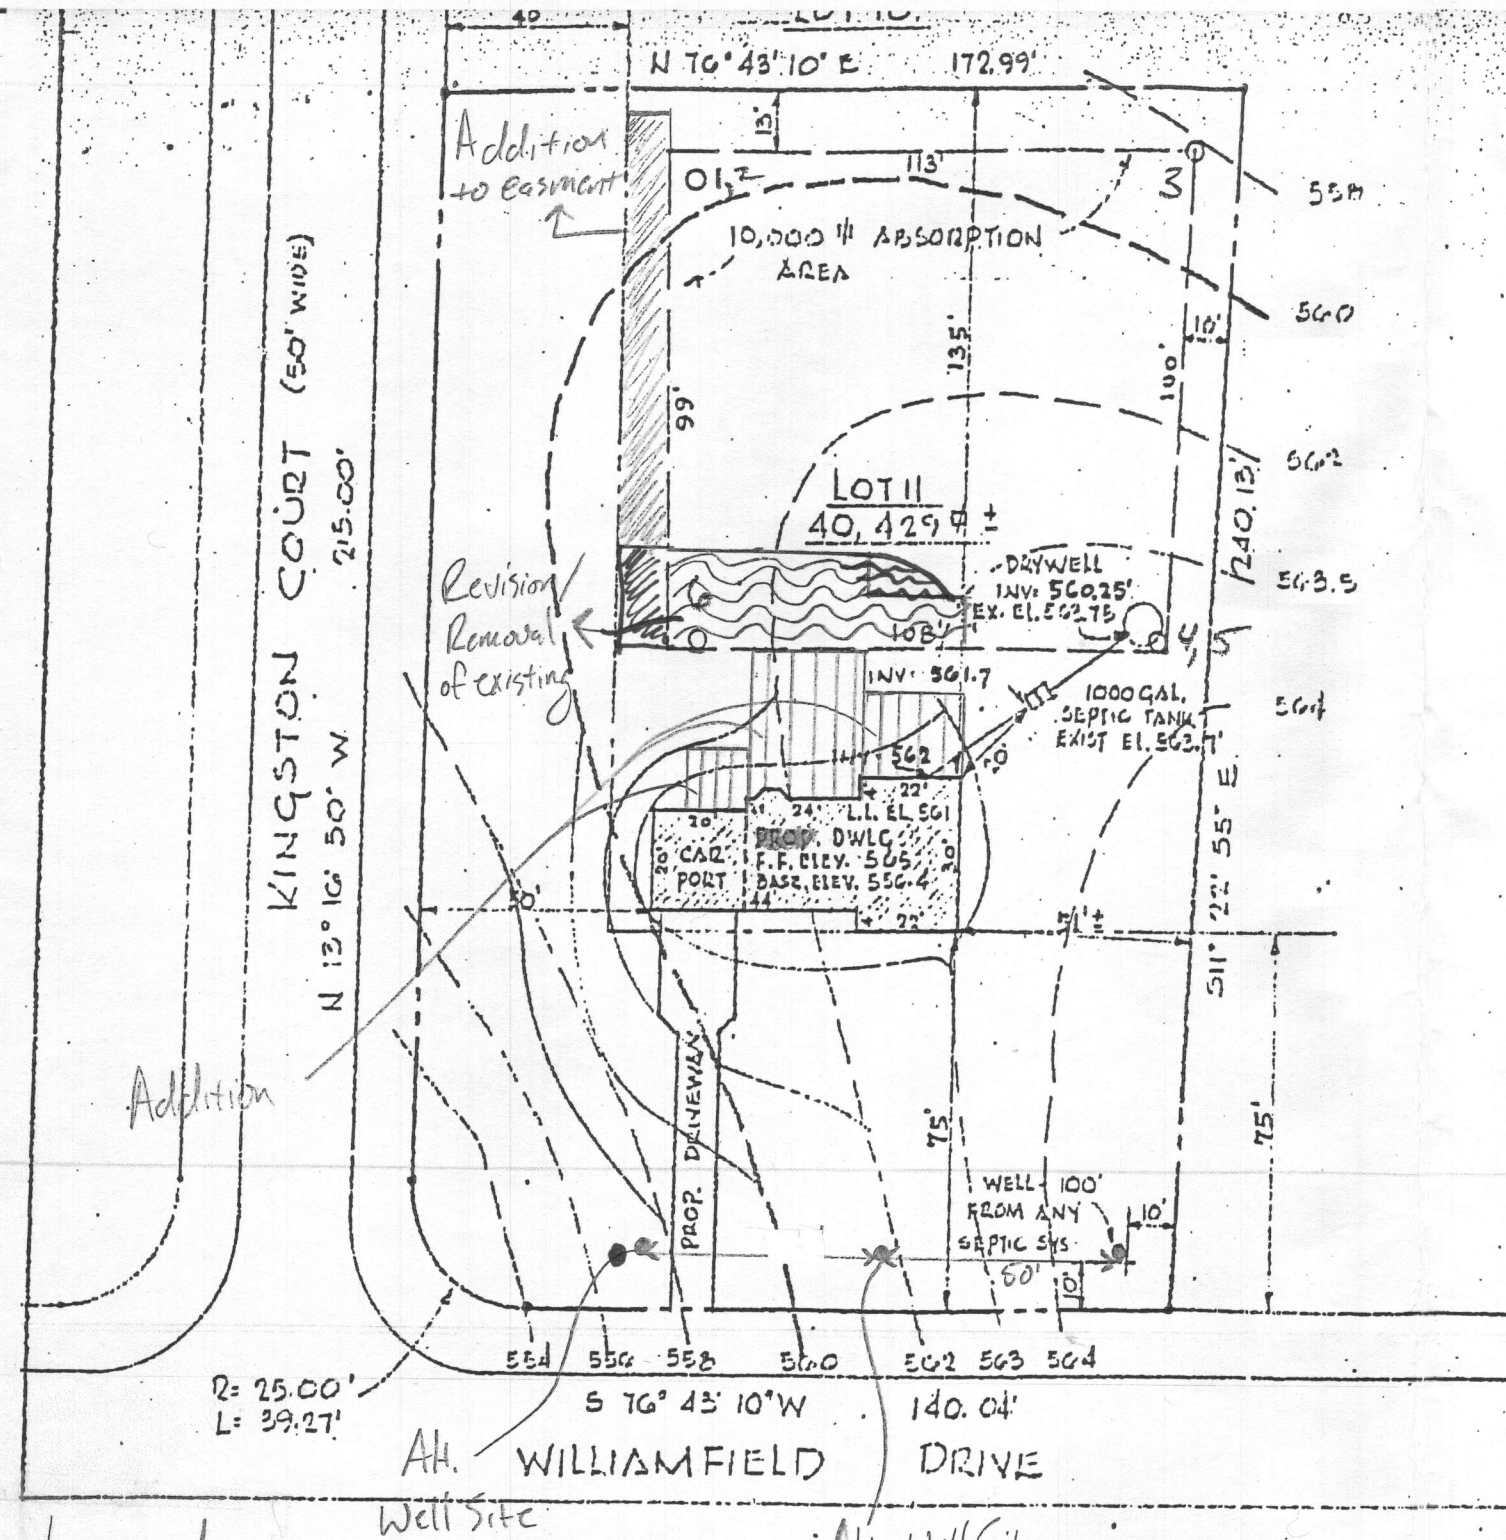
Percolation Certification Plan

Owners: David and Kathryn Schanuel
13094 William field Drive
Ellicott City, Maryland 21042

Notes:

1. The lot herein complies with the minimum ownership width and area as required by Maryland Department of the Environment (MDE) for lots created after March 1972.
2. Any changes to a private sewage easement shall require a revised perc certification plan.
3. The topography of this plat is taken from Howard County GIS and is verified to accurately represent the relative changes on the subject property.
4.  This area designates a private sewage disposal area of at least 10,000 sq. ft. as required by the Maryland Department of the Environment for individual sewage disposal. Improvements of any nature in this area are restricted. This sewage disposal area shall become null and void upon connection to a public sewerage system. The County Health Officer shall have authority to grant adjustments to the private sewage easement Recordation of a revised or modified sewage easement shall not be necessary.
5. All known wells and/or septic easements located within 100 feet of the property have been shown.
6. The existing drywell, trench and septic tank will be abandoned and the replacement septic system will be installed during construction.
7. The Purpose of this Percolation Certification Plan is to redesign the septic easement to allow required setbacks for the installation of an addition at the existing dwelling 13094 William field Drive.

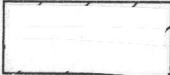
"I certify that the information shown heron is based on field work performed by me or under my direct supervision, and is correct to the best of my knowledge and belief."



Percolation Certification Plan

Owners: David and Kathryn Schanuel
13094 William field Drive
Ellicott City, Maryland 21042

Notes:

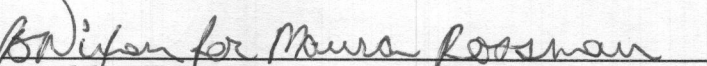
1. The lot herein complies with the minimum ownership width and area as required by Maryland Department of the Environment (MDE) for lots created after March 1972.
2. Any changes to a private sewage easement shall require a revised perc certification plan.
3. The topography of this plat is taken from Howard County GIS and is verified to accurately represent the relative changes on the subject property.
4.  This area designates a private sewage disposal area of at least 10,000 sq. ft. as required by the Maryland Department of the Environment for individual sewage disposal. Improvements of any nature in this area are restricted. This sewage disposal area shall become null and void upon connection to a public sewerage system. The County Health Officer shall have authority to grant adjustments to the private sewage easement Recordation of a revised or modified sewage easement shall not be necessary.
5. All known wells and/or septic easements located within 100 feet of the property have been shown.
6. The existing drywell, trench and septic tank will be abandoned and the replacement septic system will be installed during construction.
7. The Purpose of this Percolation Certification Plan is to redesign the septic easement to allow required setbacks for the installation of an addition at the existing dwelling 13094 William field Drive.

"I certify that the information shown heron is based on field work performed by me or under my direct supervision, and is correct to the best of my knowledge and belief."


Applicant

8/18/14
Date

Approved For Private Water and Private Sewage System


Health Office, Howard County Health Department

8/28/2014
Date

